


7/11/2019


Orkney
959.124 GR
(7/11/2019)

© 2018 Art Form Architecture, Inc., all rights reserved. You may not build this design without purchasing a license, even if you make changes. This design may have geographic restrictions.

Artform Home Plans
603-431-9559

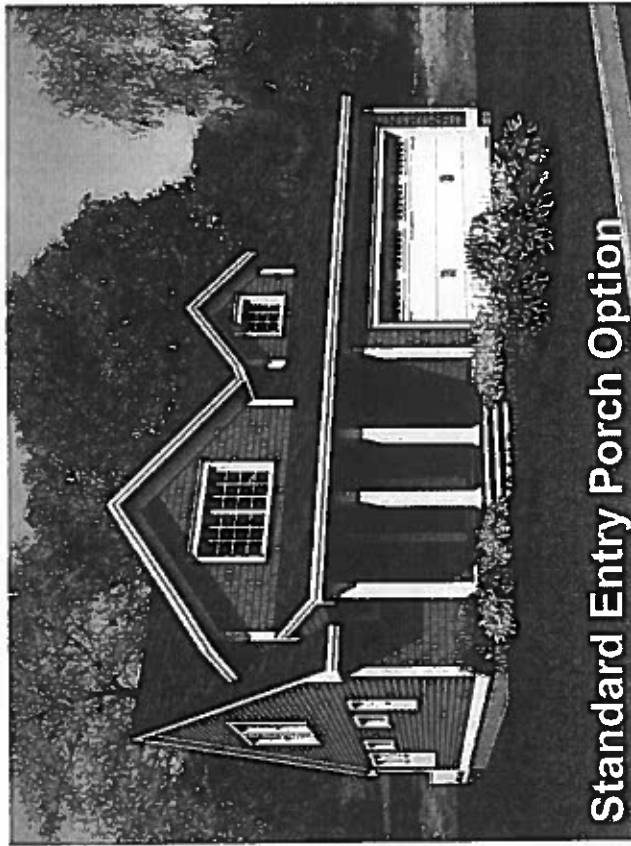


Standard Entry Porch Option

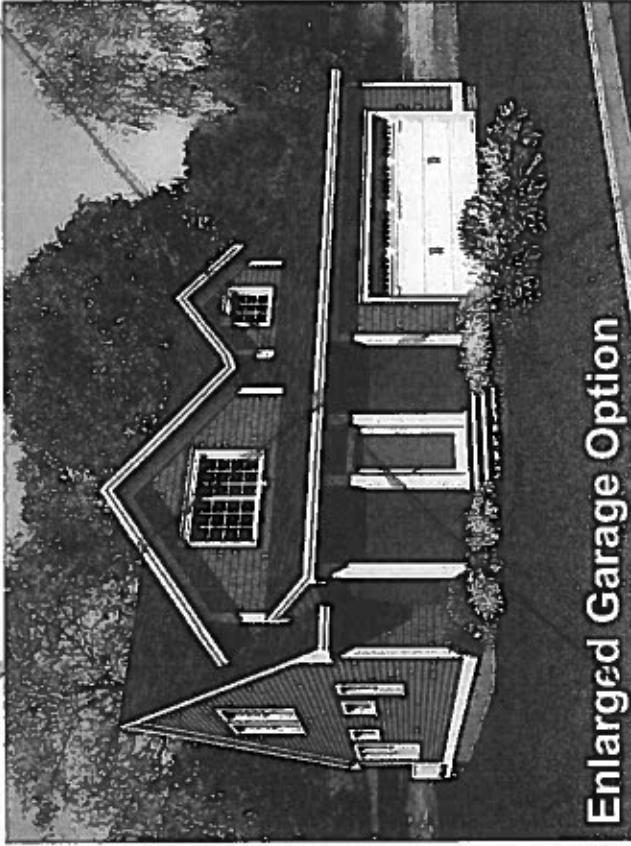

Enlarged Garage Option

garage
left


1/d

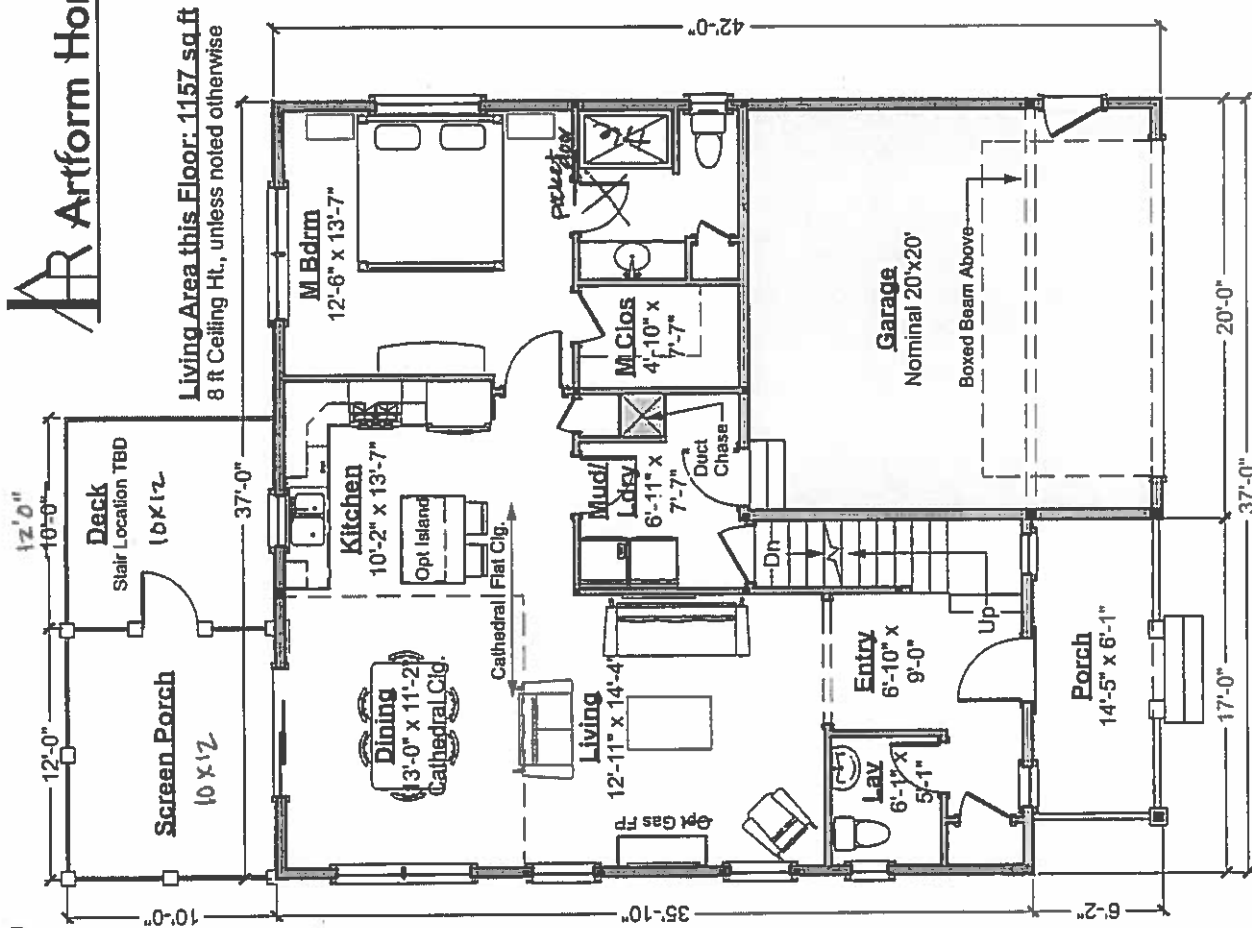

garage left

**First Floor Plan -
Screen Porch & Deck
Option**
Scale: 1/8" = 1'-0"

Living Area this Floor: 798 sq ft
8 ft Ceiling Ht.

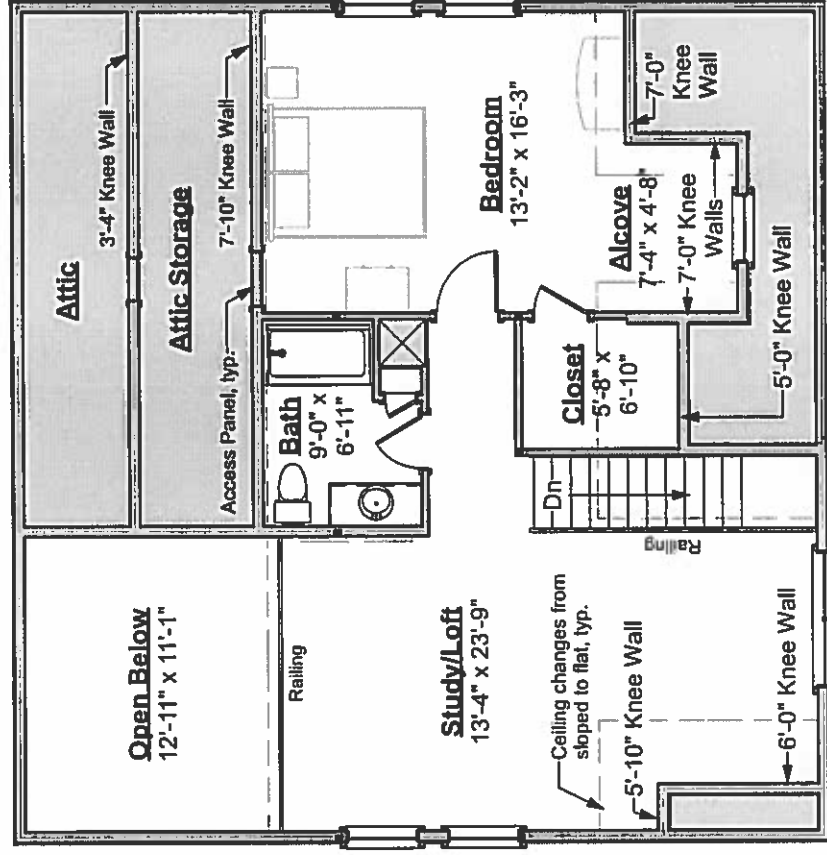

Second Floor Plan
Scale: 1/8" = 1'-0"

1d