

481.124.v10 KR Sweet Cherry Pie




First Floor

	Area	Beds	Baths
Main	977 SF	0	0.5
Future	0 SF	0	0
Apt	0 SF	0	0
Total	977 SF	0	0.5

Ceiling Height			
Shown	9'-0"		
Possible*	8'-0"		

* See Major Change information on plan page for cost

Windows: 6/0
Slider: Clear Glass

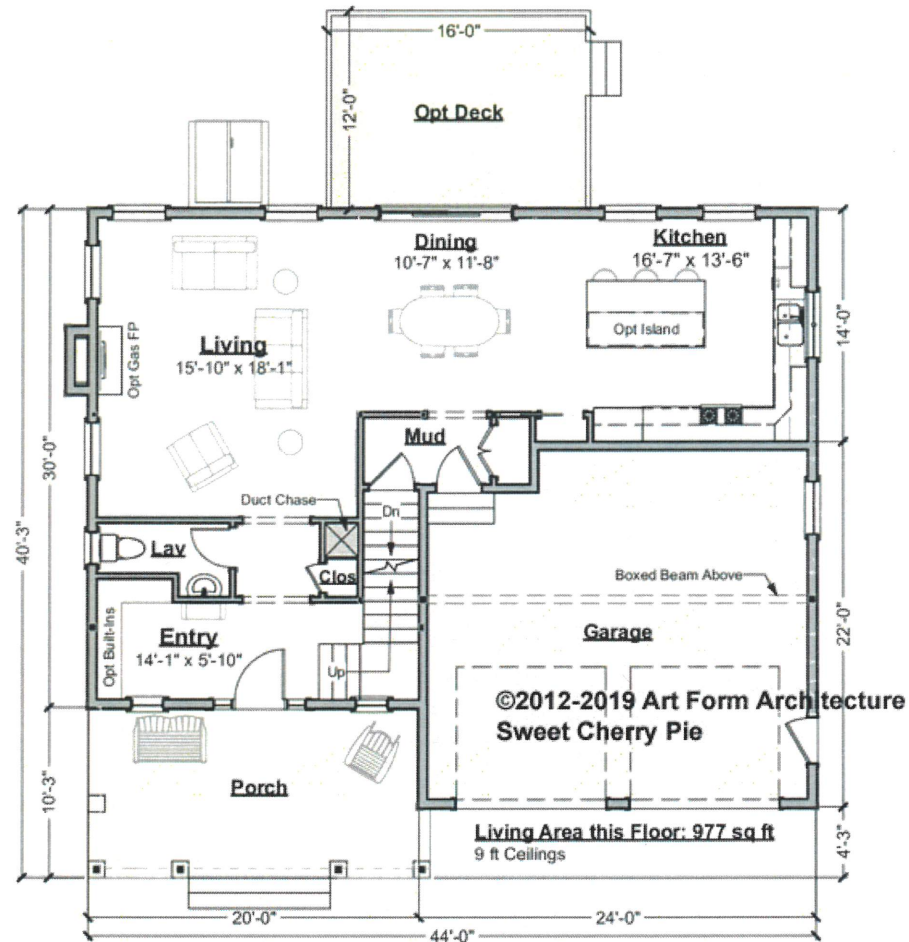

Use of this document is governed by our **Terms and Conditions**, found on our website:
<http://www.artformhomeplans.com/TermsConditions.a5w>

© 2012 Art Form Architecture, Inc. ALL RIGHTS RESERVED.
You may not build this Design without purchasing a License to Build (as defined in our Terms). Unauthorized changes are not permitted and violate copyright laws, which provide substantial penalties for infringement.

Some features show are optional. Your Purchase & Sale Agreement governs, whether items are labeled "optional" in this document or not.

We are not responsible for typographical errors.

481.124.v10 KR Sweet Cherry Pie




Second Floor

	Area	Beds	Baths
Main	1427 SF	3	2
Future	0 SF	1	0
Apt	0 SF	0	0
Total	1427 SF	4	2

Ceiling Height	
Shown	8'-0"
Possible*	9'-0"

* See Major Change information on plan page for cost

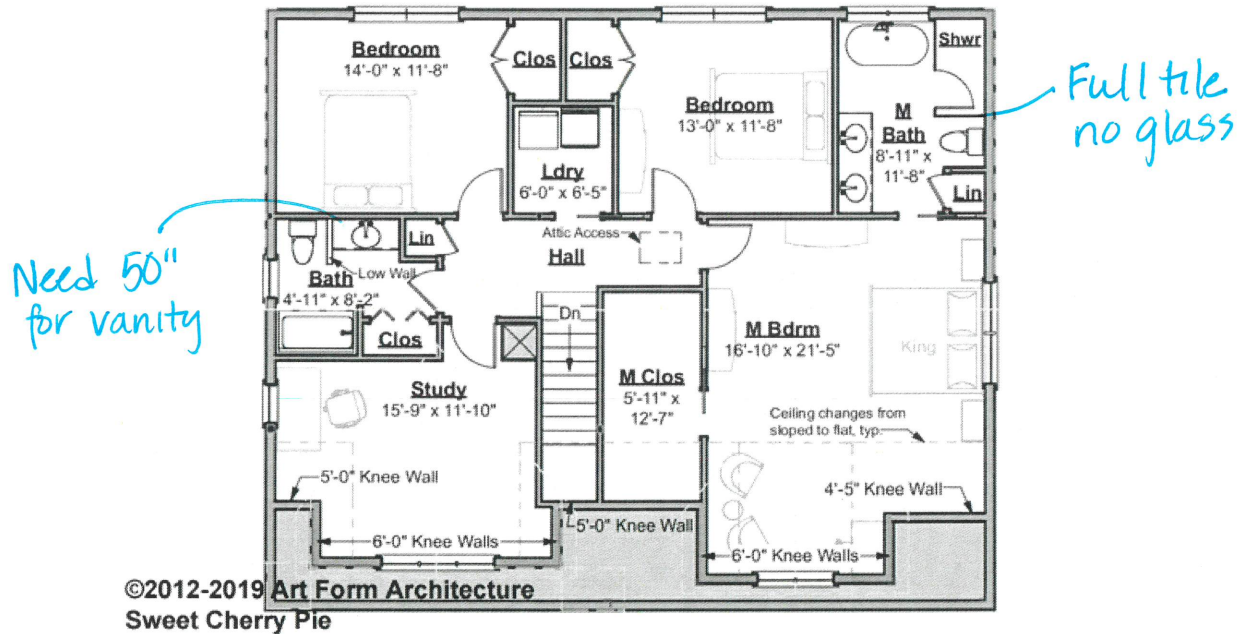

Living Area this Floor: 1427 sq ft
8 ft Ceilings

Use of this document is governed by our **Terms and Conditions**, found on our website:
<http://www.artformhomeplans.com/TermsConditions.a5w>

© 2012 Art Form Architecture, Inc. ALL RIGHTS RESERVED.
You may not build this Design without purchasing a License to Build (as defined in our Terms). Unauthorized changes are not permitted and violate copyright laws, which provide substantial penalties for infringement.

Some features show are optional. Your Purchase & Sale Agreement governs, whether items are labeled "optional" in this document or not.

We are not responsible for typographical errors.