

FIRST FLOOR


GIDEON ~~GRANDE~~

with wings

DIANE ARNONE

Location
West Whitehall Road
Amesbury, MA 02172

17 X 26

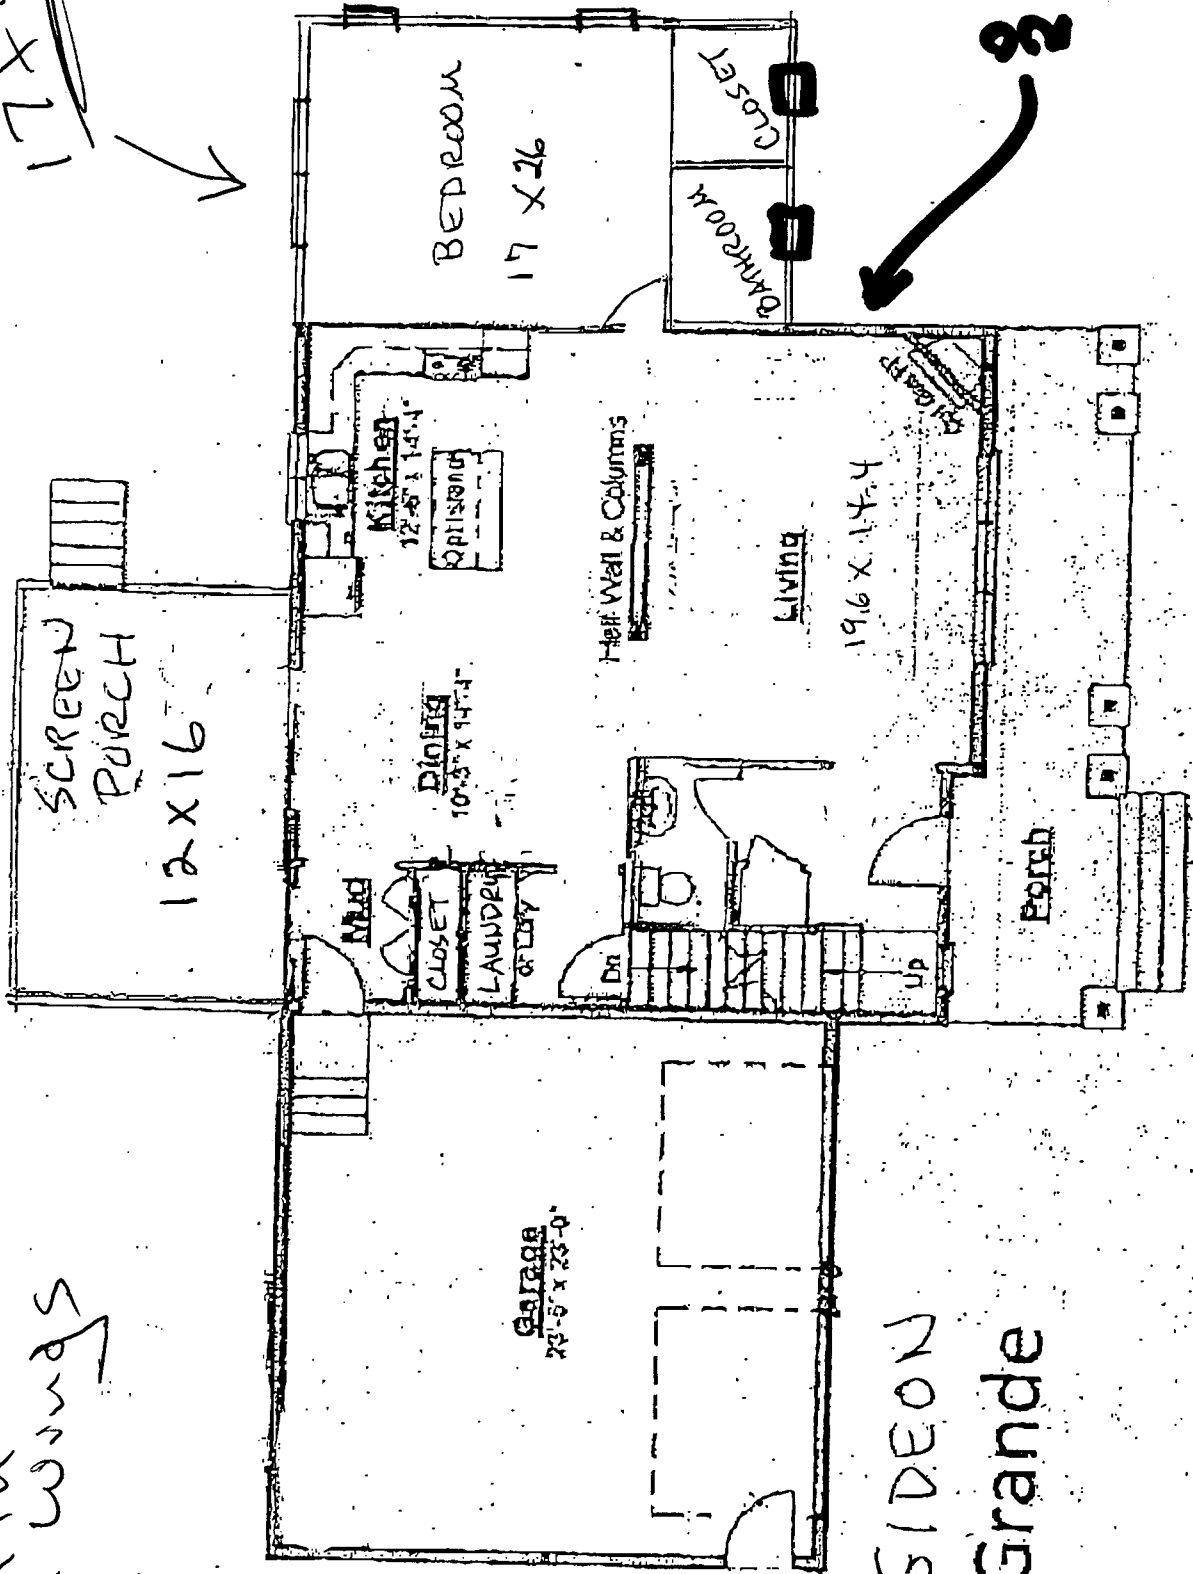

GIDEON
Grande