


Revisions to the Lot 16 Oleo Plan

Change 1st Floor Master to Family Room/Office as noted below:

Buyer: Mike and I discussed our preferred office dimension, we would like office 10 ft in length (10 x 14.5) Family Room area would be 14 ft. in length (14 x 14.5.)

14'

10'

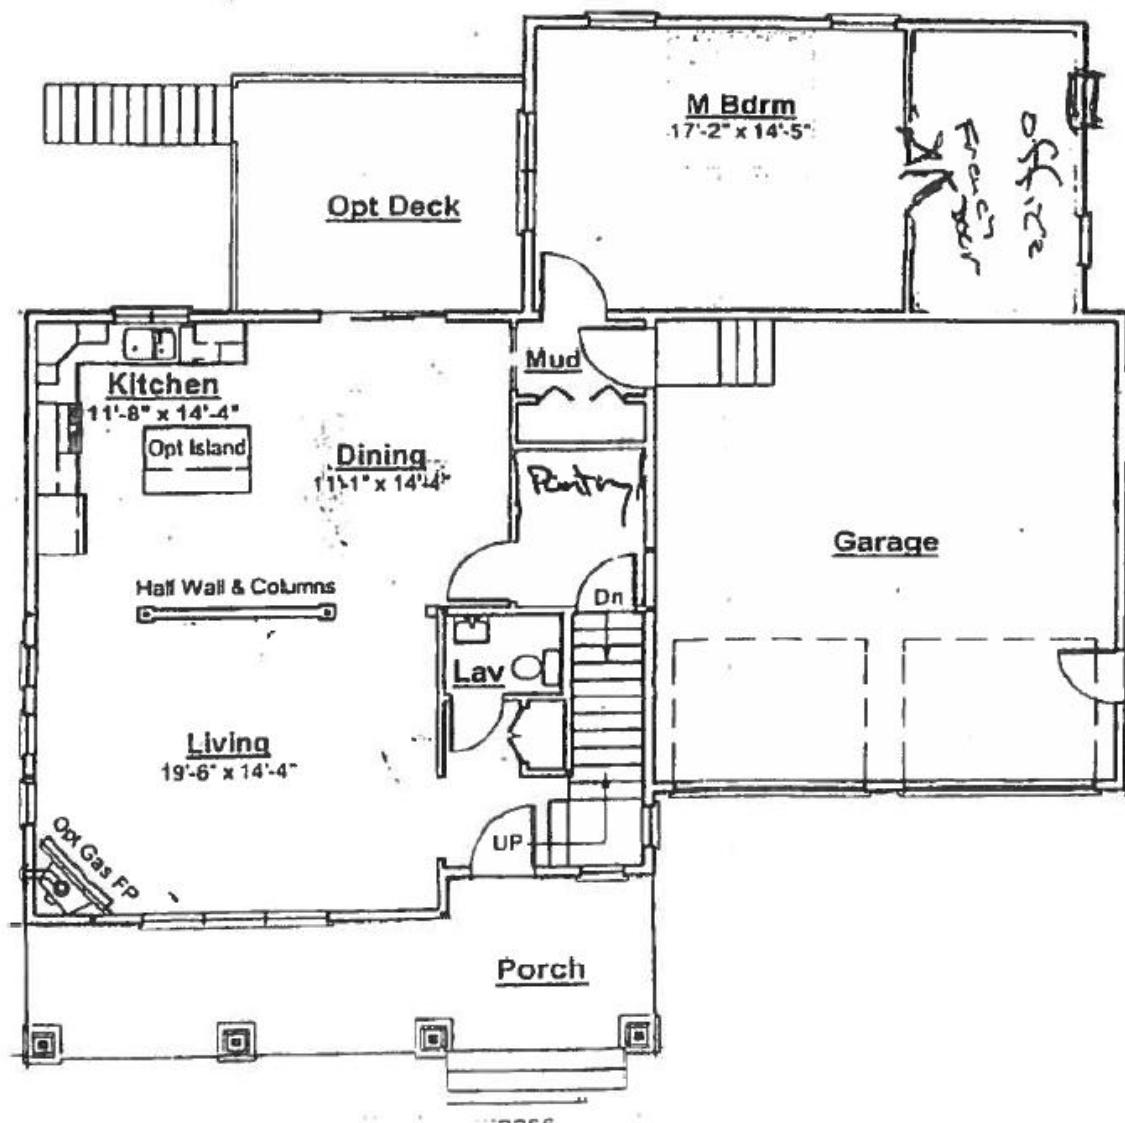

Laundry room on second floor:

3' door into Laundry room – Extend hall only 4' into Bonus Room, Use old Linen closet for Equipment and Small area to for bins etc. Bonus Room is not being finished so access is from hall not bonus Room.

