


# Sweet Cherry Pie

481.124.v10 GL (5/24/2021)

© 2012-2021 Art Form Architecture, Inc., all rights reserved. You may not build this design without purchasing a license, even if you make changes. This design may have geographic restrictions.

**Artform Home Plans**

603-431-9559

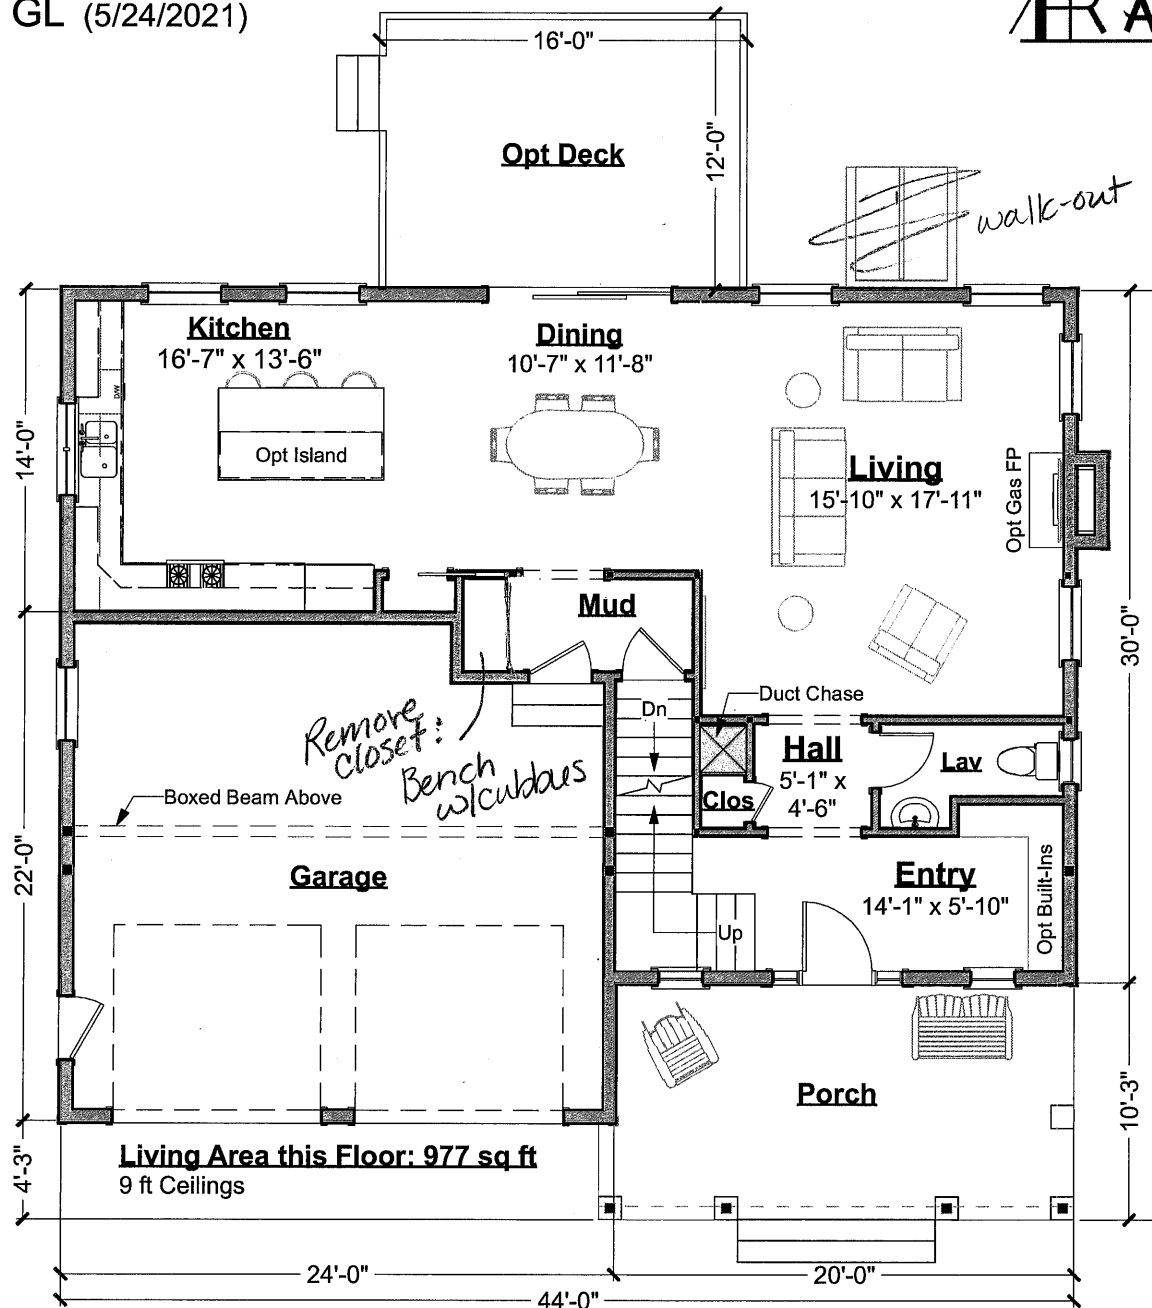

- windows: top grids only
- slider: grids
- kitchen window: full grids

★ Upgrade to Pacific Blue Monogram

## First Floor Plan

Scale: 1/8" = 1'-0"


# Sweet Cherry Pie

481.124.v10 GL (5/24/2021)

© 2012-2021 Art Form Architecture, Inc., all rights reserved. You may not build this design without purchasing a license, even if you make changes. This design may have geographic restrictions.

**Artform Home Plans**

603-431-9559

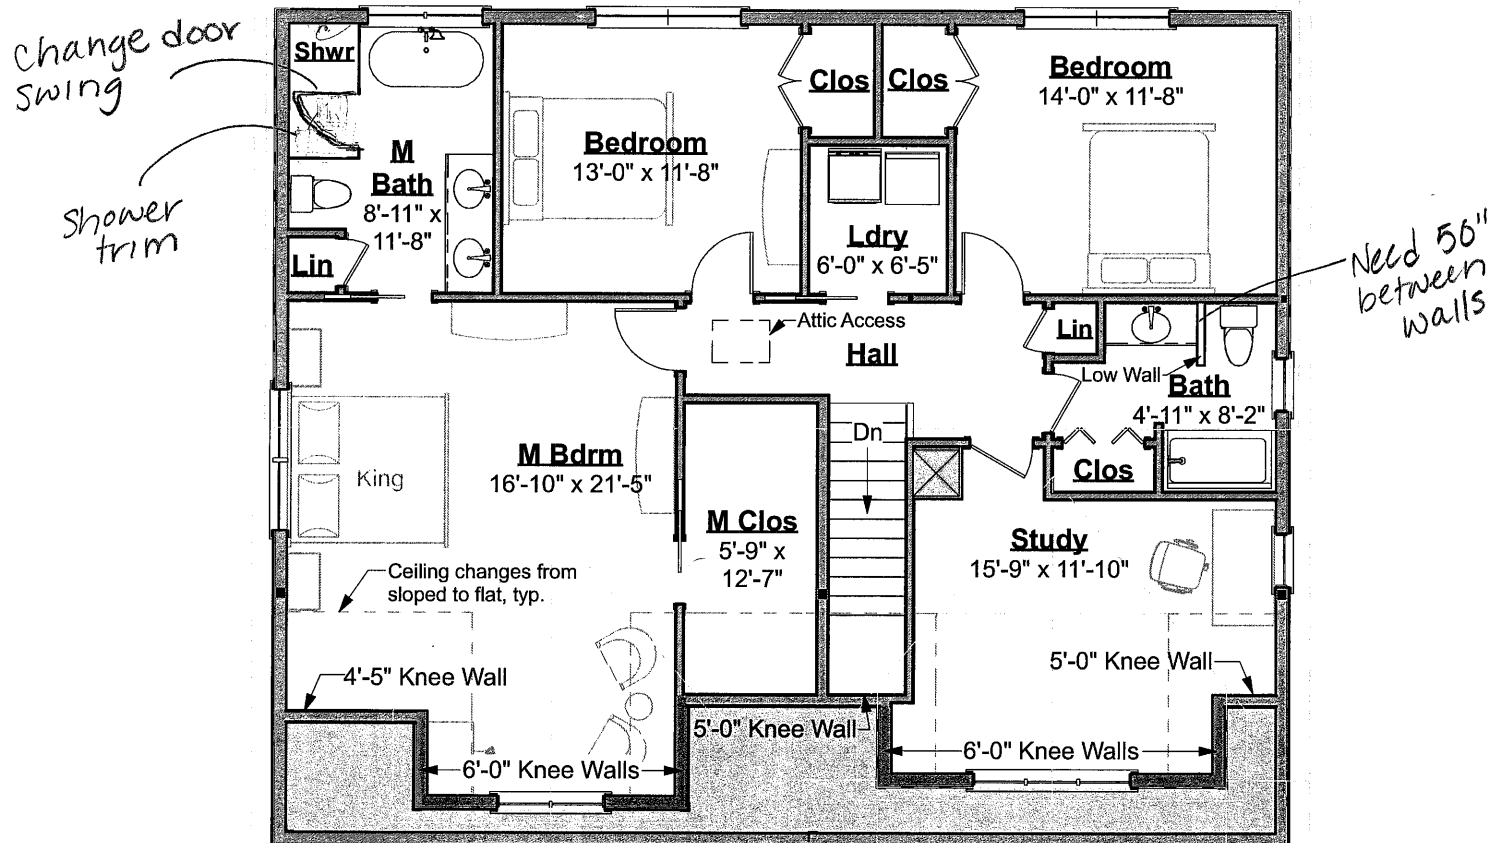

**Living Area this Floor: 1427 sq ft**  
8 ft Ceilings

**Second Floor Plan**


Scale: 1/8" = 1'-0"

**Sweet Cherry Pie**  
481.124.v10 GL (5/24/2021)

© 2012-2021 Art Form Architecture, Inc., all rights reserved. You may not build this design without purchasing a license, even if you make changes. This design may have geographic restrictions.

**Artform Home Plans**

603-431-9559

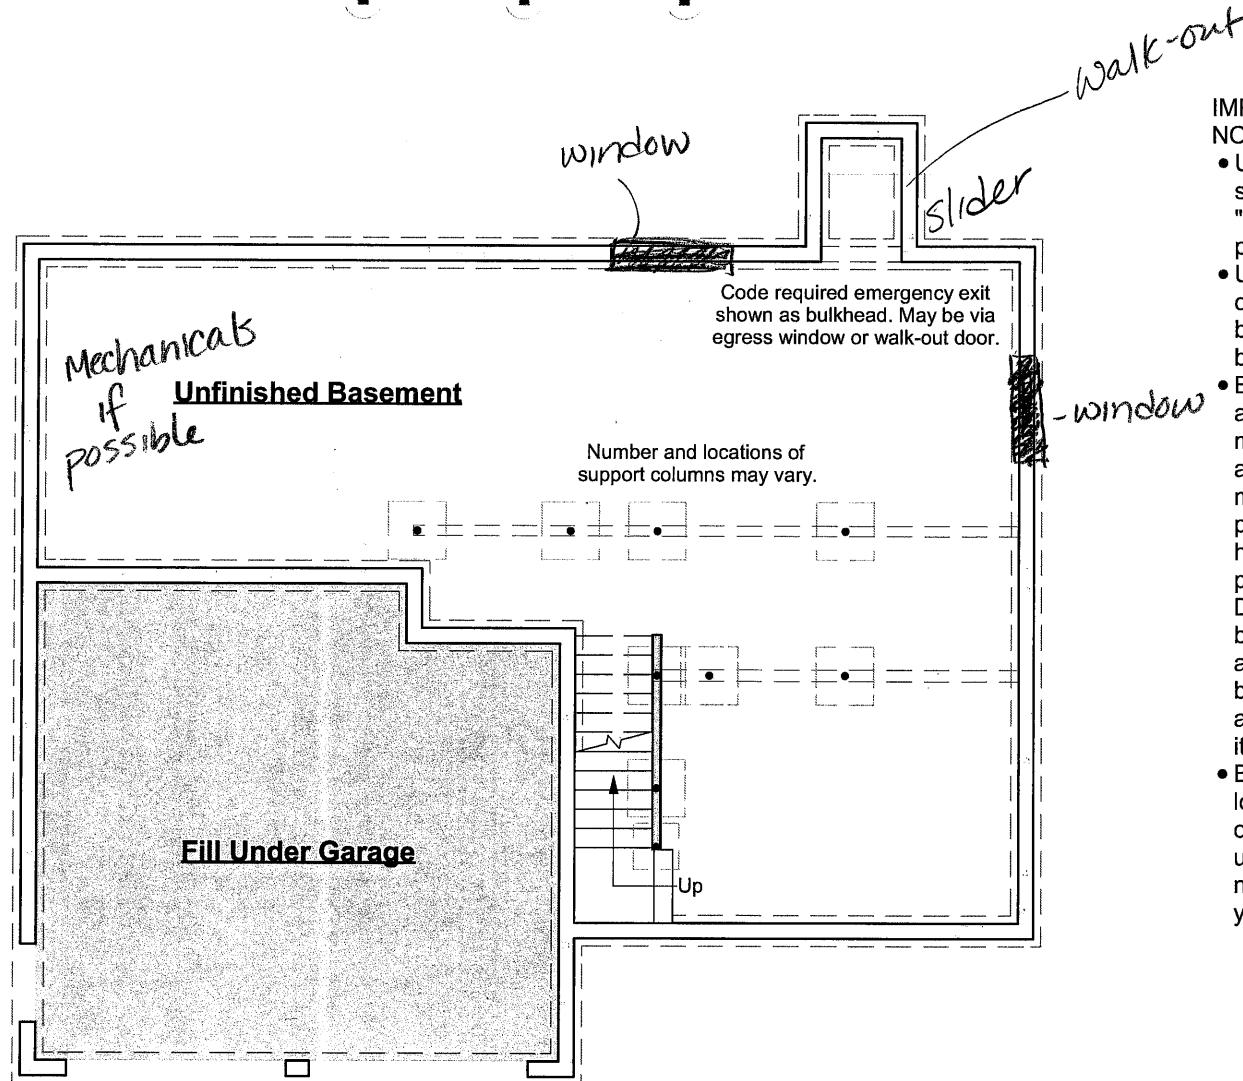

**IMPORTANT BASEMENT NOTES:**

- Unless an area is specifically designed as "no posts", additional posts may be required.
- Unless specifically noted otherwise, basement beams will be framed below the floor joists.
- Basement spaces accommodate utilities, mechanical equipment and the horizontal movement of plumbing pipes, electrical wires and heating ducts. Both as part of any Construction Drawings produced based on this design and as future decisions made by the builder, changes to accommodate these items must be expected.
- Basement window locations are dependent on site conditions and utility locations. Clarify number and location with your builder.

**Foundation Plan**  
Scale: 1/8" = 1'-0"


# Sweet Cherry Pie

481.124.v10 GL (5/24/2021)

© 2012-2021 Art Form Architecture, Inc., all rights reserved. You may not build this design without purchasing a license, even if you make changes. This design may have geographic restrictions.

**Artform Home Plans**

603-431-9559

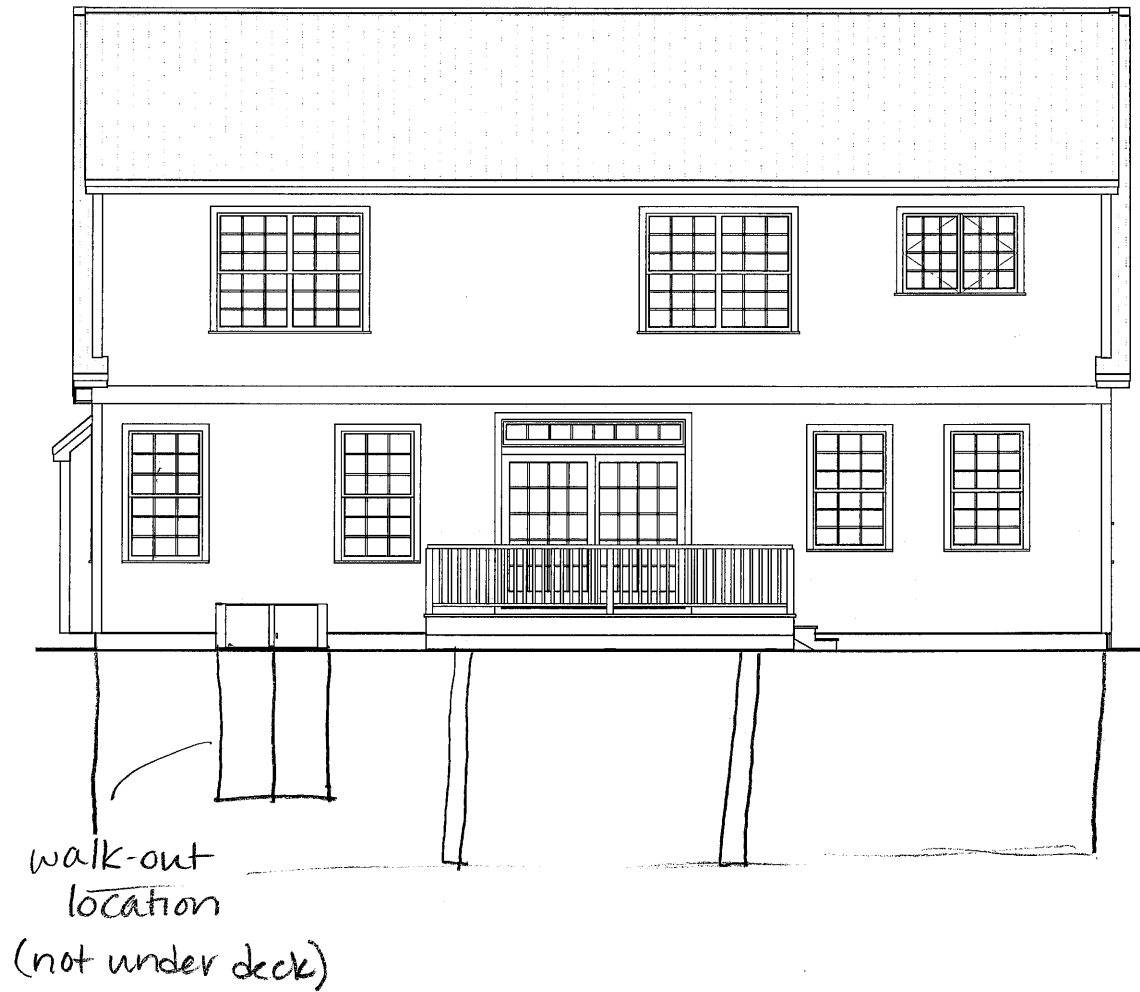

**Rear Elevation**

Scale: 1/8" = 1'-0"