


7/11/2019
Vanilla Grand Torte
594.124.v2 KR
(7/11/2019)

© 2013-2018 Art Form Architecture, Inc., all rights reserved.
You may not build this design without purchasing a license.
even if you make changes. This design may have geographic
restrictions.



603-431-9559

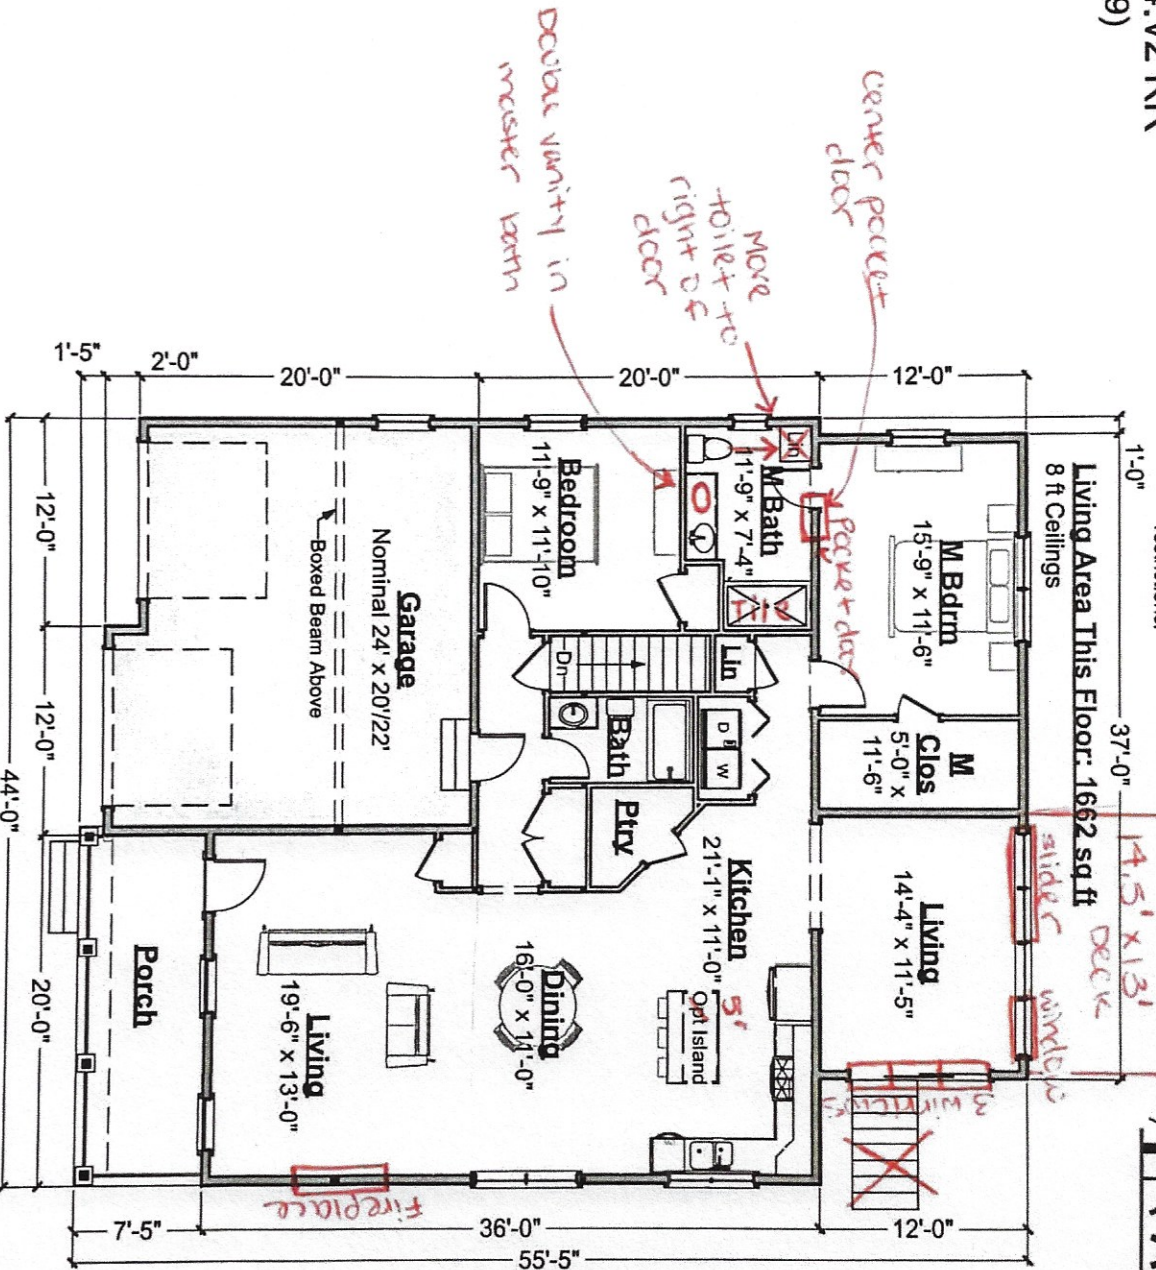

First Floor Plan - 3-Season Porch Option

Scale: 3/32" = 1'-0"


07/22/20
12:46 PM EDT
dotloop verified

07/16/20
5:03 PM EDT
dotloop verified


07/16/20
5:20 PM EDT
dotloop verified

7/11/2019
Vanilla Grand Torte
594.124.v2 KR
(7/11/2019)

© 2013-2018 Art Form Architecture, Inc., all rights reserved.
You may not build this design without purchasing a license,
even if you make changes. This design may have geographic
restrictions.

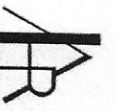 **Artform Home Plans**

603-431-9559

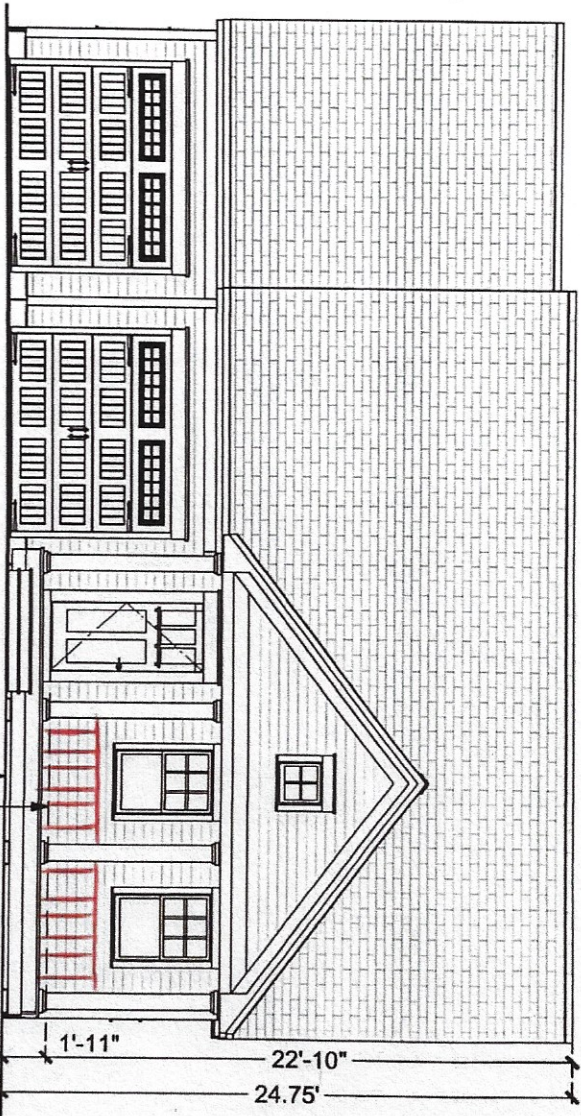

porch railings - 3 sections (as shown)


07/22/20
12:46 PM EDT
dotloop verified


07/16/20
5:03 PM EDT
dotloop verified


07/16/20
5:20 PM EDT
dotloop verified

Front Elevation
Scale: 1/8" = 1'-0"