

9/9/2020

Screen Shot 2020-09-08 at 12:37:37 PM.png



# Vanilla Grand Torte


594.124.v2 KR

(7/11/2019)

© 2013-2018 Art Form Architecture, Inc., all rights reserved.  
You may not build this design without purchasing a license,  
even if you make changes. This design may have geographic  
restrictions.

**Artform Home Plans**

603-431-8559

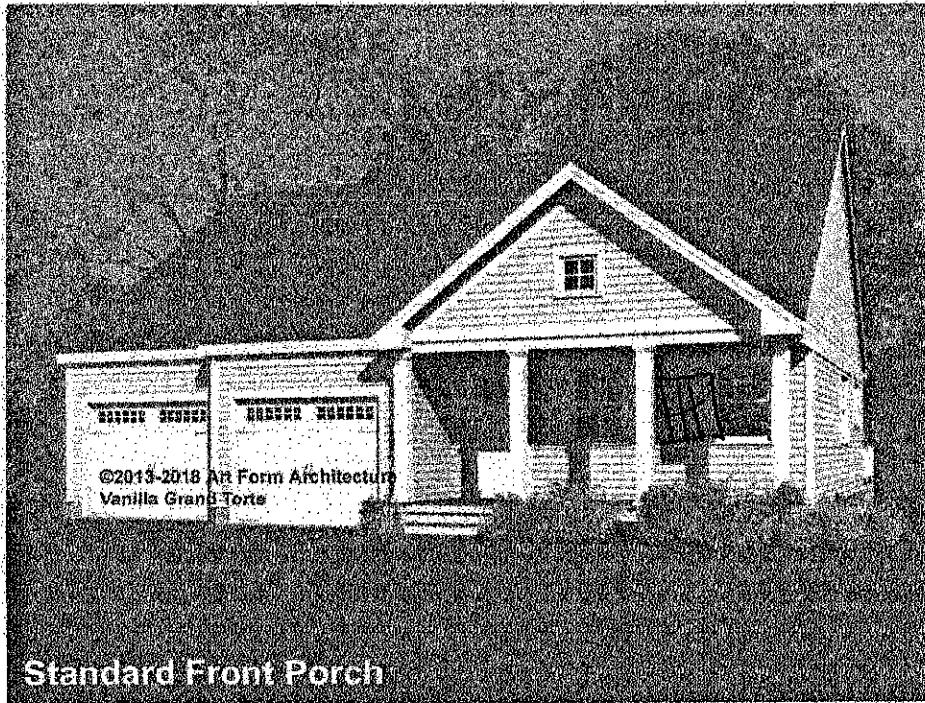

Some items shown are optional and/or may vary. Builder's written specifications always govern.


1. Gas fireplace and it's surround or mantel
2. Kitchen - island, cabinet style & trim, countertop material, etc.
3. Door styles and trim
4. Window grilles and trim, window treatments
5. Stair balusters or low walls at stairs
6. Lighting
7. Material selections (flooring, siding, roofing, paint colors, etc.)
8. Other furnishings
9. Landscaping, paving and walkways
10. Gutters, shutters and other exterior trim components
11. Deck size, railing style, stair location, etc.
12. Amount of exposed basement and/or wood framed walls at basement.

These images are not of any specific building site. Sun and view through windows will vary, as will the site around the house on the exterior and the slope of the land.

9/9/2020



Screen Shot 2020-09-06 at 12:02:24 PM.png

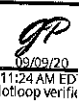


# Vanilla Grand Torte

594.124.v2 KR  
(7/11/2019)

© 2013-2018 Art Form Architecture, Inc., all rights reserved.  
You may not build this design without purchasing a license,  
even if you make changes. This design may have geographic  
restrictions.

**Artform Home Plans**  
603-431-9559

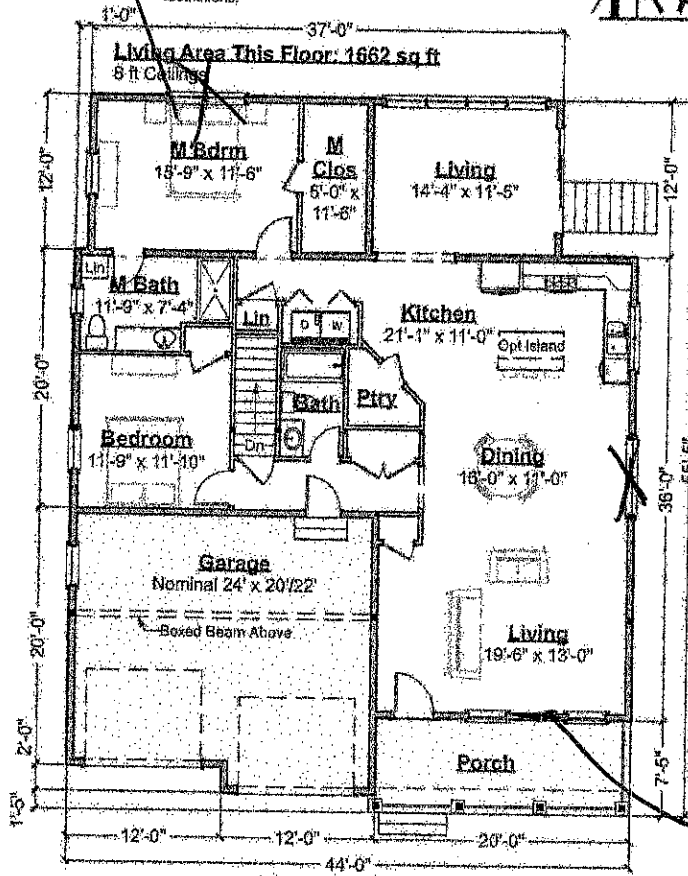

**First Floor Plan - 3-Season Porch Option**  
Scale: 3/32" = 1'-0"

*Remove Windows on wall*

*Remove Windows in Dinetto*

*Add 3rd Window to front of house*