


145.001 Sweet William Bungalow

Some features shown are optional. Your contract with your builder governs.

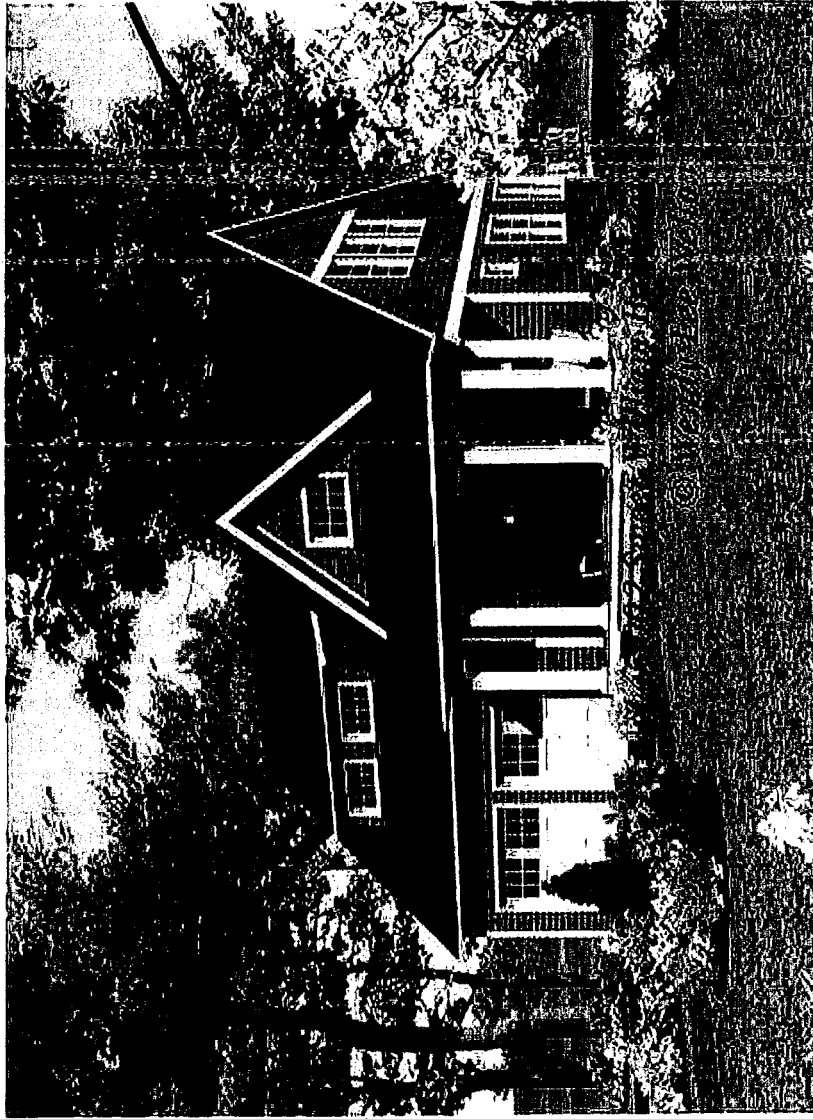

Sweet William Bungalow works on lots that have more depth than width. Making the rear wing narrower allows corner windows in the Living Room while still connecting it strongly with the Dining Room and Kitchen. A ground floor master suite combined with loads of expansion space upstairs makes this design work for all kinds of families.



See more plans in the [Sweet Cottages & Bungalows Collection](#).

	Living Area	Bedrooms	Bathrooms	Ceiling Height Shown	Ceiling Height Possible*
First Floor	1276 SF	1	1.5	8'-0"	8'-0"
Second Floor	1324 SF	3	1.0	8'-0"	8'-0"
Total Above Grade	2600 SF	4	2.5		

Plan to be reversed
on Z Cushman Way
SAA



KC

* -- See Major Changes on pricing tab of plan page for cost.
<http://www.artformhomeplans.com/Contacta5w>
<http://www.artformhomeplans.com/TermsConditions.a5w>

Design is copyright protected, all rights reserved. You may not build without purchasing a license, even if you make changes. Square footages and room dimensions are approximate, and may vary slightly. Not responsible for typographical errors.

145.001 Sweet William Bungalow

Some features shown are optional. Your contract with your builder governs.

First Floor

Living Area: 1276 SF


Beds: 1

Baths: 1.5


Ceiling Height Shown: 8'-0"

Ceiling Height Possible*: 8'-0"

* -- See Major Changes on pricing tab of plan page for cost.

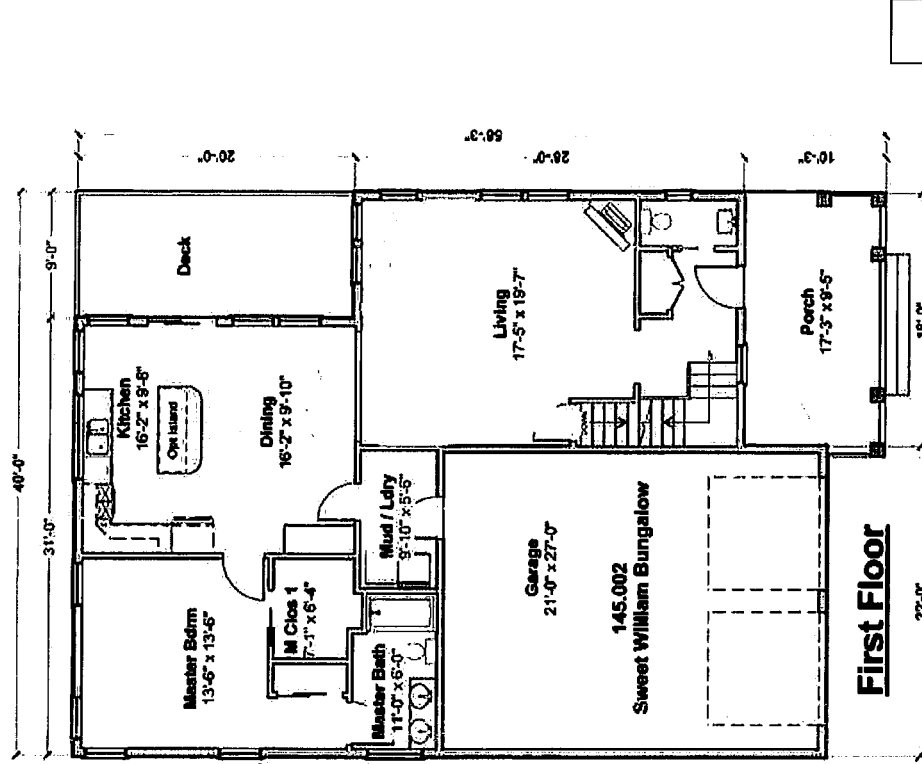

First Floor

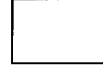

SAA
AK

<http://www.artformhomeplans.com/Contact.aspx>
<http://www.artformhomeplans.com/TermsConditions.aspx>

Design is copyright protected, all rights reserved. You may not build without purchasing a license, even if you make changes. Square footages and room dimensions are approximate, and may vary slightly. Not responsible for typographical errors.

145.001 Sweet William Bungalow

Some features shown are optional. Your contract with your builder governs.

Second Floor

Living Area: 1324 SF

Beds: 3

Baths: 1.0


Ceiling Height Shown: 8'-0"

Ceiling Height Possible*: 8'-0"

* -- See Major Changes on pricing tab of plan page for cost.



Artform Home Plans

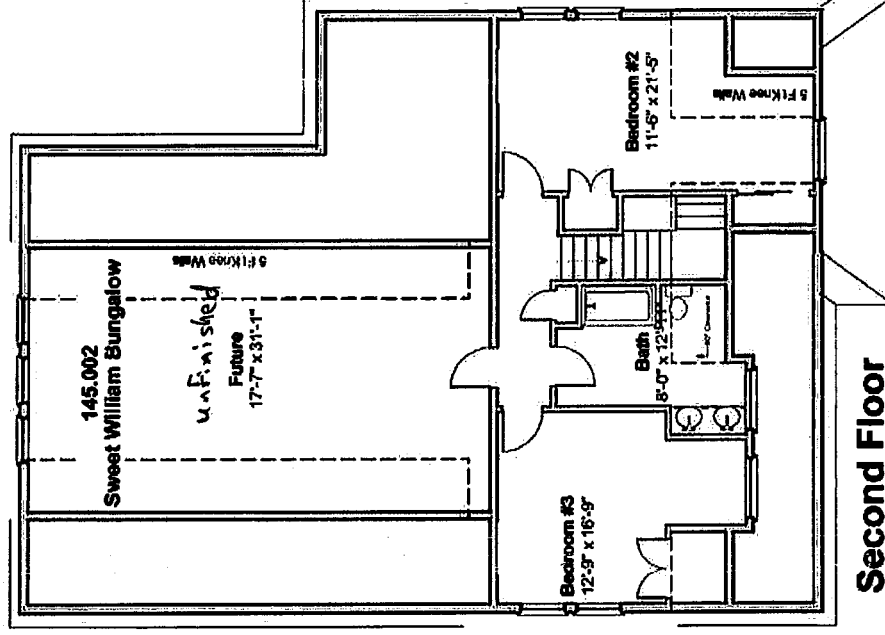

Second Floor

S.A.H. RC

<http://www.artformhomeplans.com/Contact.a5w>

<http://www.artformhomeplans.com/TermsConditions.a5w>

Design is copyright protected, all rights reserved. You may not build without purchasing a license, even if you make changes. Square footages and room dimensions are approximate, and may vary slightly. Not responsible for typographical errors.