

shift the window to the 'R'


Living Area this Floor: 1617 sq ft
9 ft Ceilings

Glass F
inside

NO windows

pantry cabinet

NO window

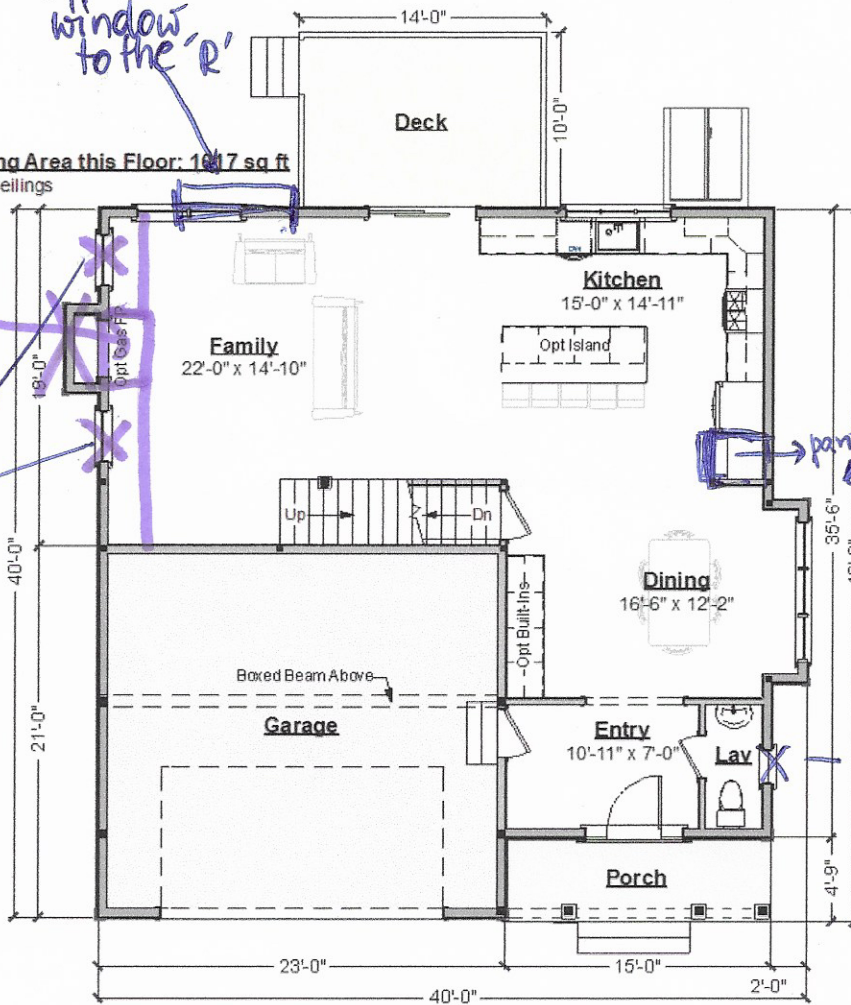


Living Area this Floor: 1372 sq ft
8 ft Ceilings


- Remove laundry
- 2 walk in closets with slide door

- ① long window vertical
② or long horizontal

No closet

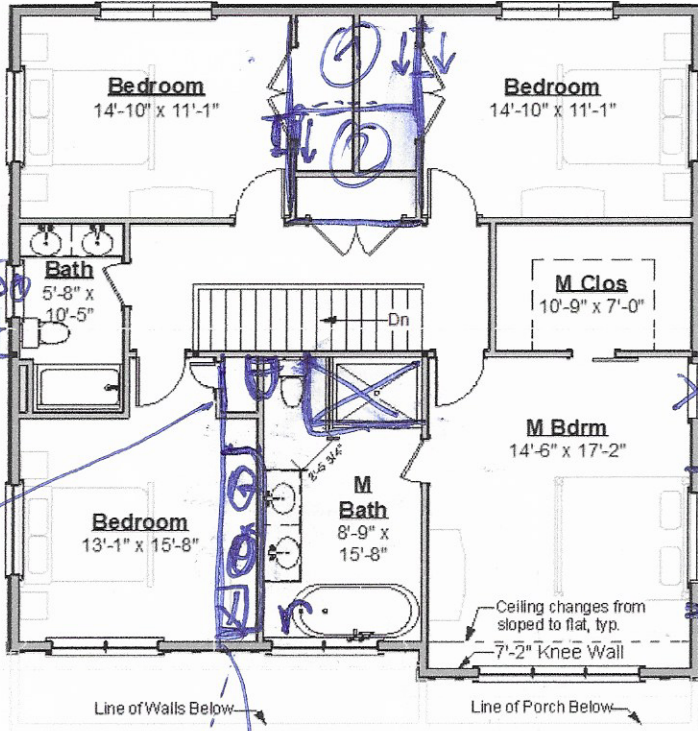


- move the wall
- move toilet
- shower (2 glass walls or need a size of a shower?)
- longer cabinets

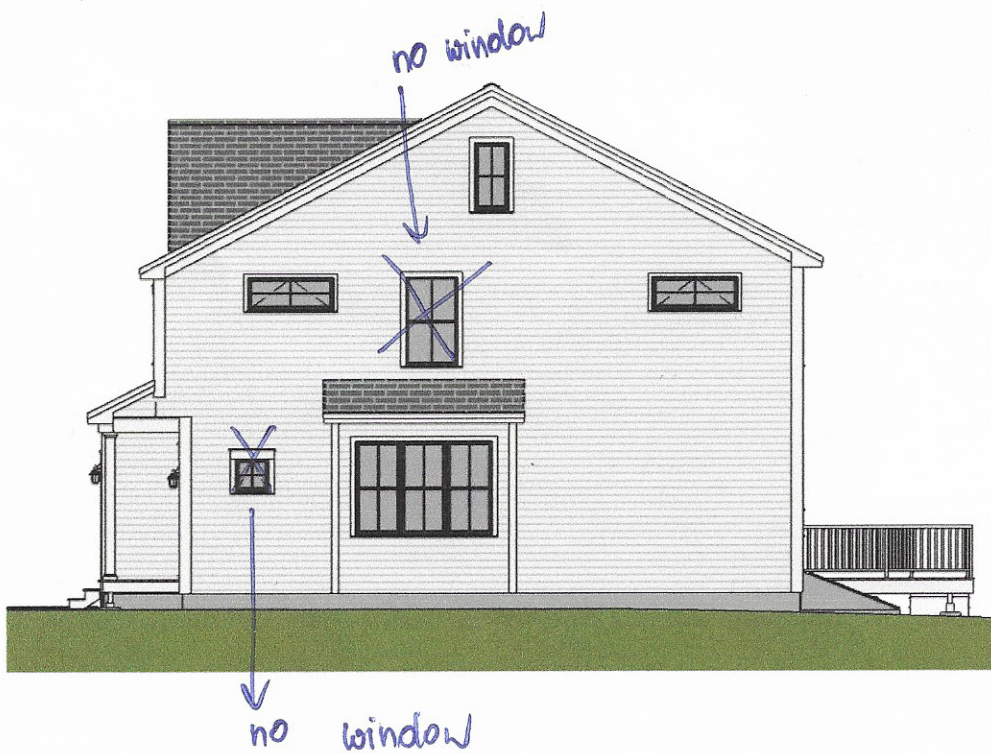



→ No Gas F outside

shif the window to the "L" so it's even with the window upstairs

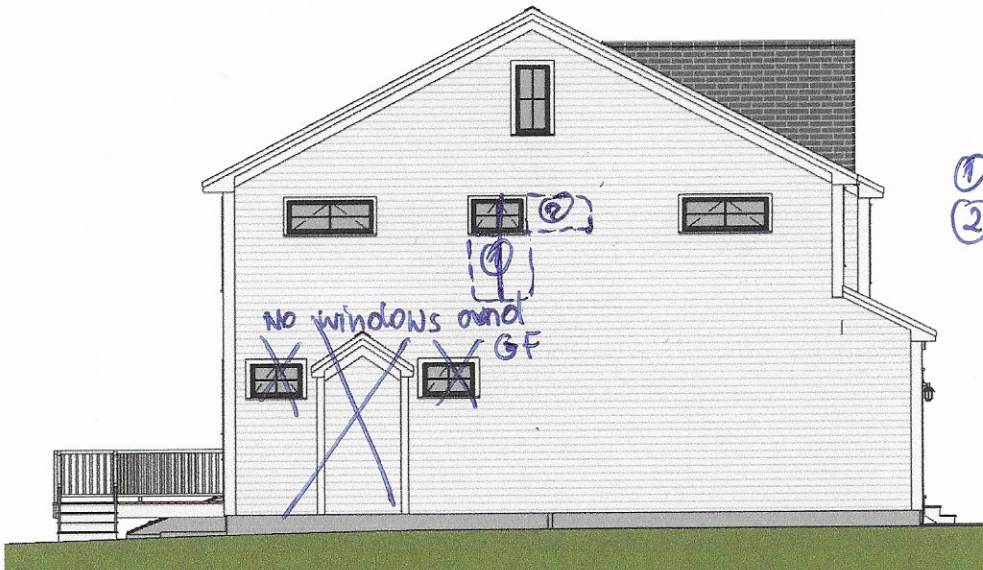

① long window (vertical)
② or long window (horizontal)

Lead times on the New Home Plans are as follows, as of January, 2021.

Tier 1, No change	- up to 1 week
Tier 1, With changes	- 2-8 weeks
Tier 2, No change	- 3-4 week
Tier 2, With changes	- 4-12 weeks
Tier 3 & Custom	- 8-12 weeks