

408.124.v39 KL Hopscotch Classic




First Floor

	Area	Beds	Baths
Main	951 SF	0	0.5
Future	0 SF	1	0
Apt	0 SF	0	0
Total	951 SF	1	0.5

Ceiling Height
Shown 8'-0"
Possible* 8'-8"

* See Major Change information on plan page for cost

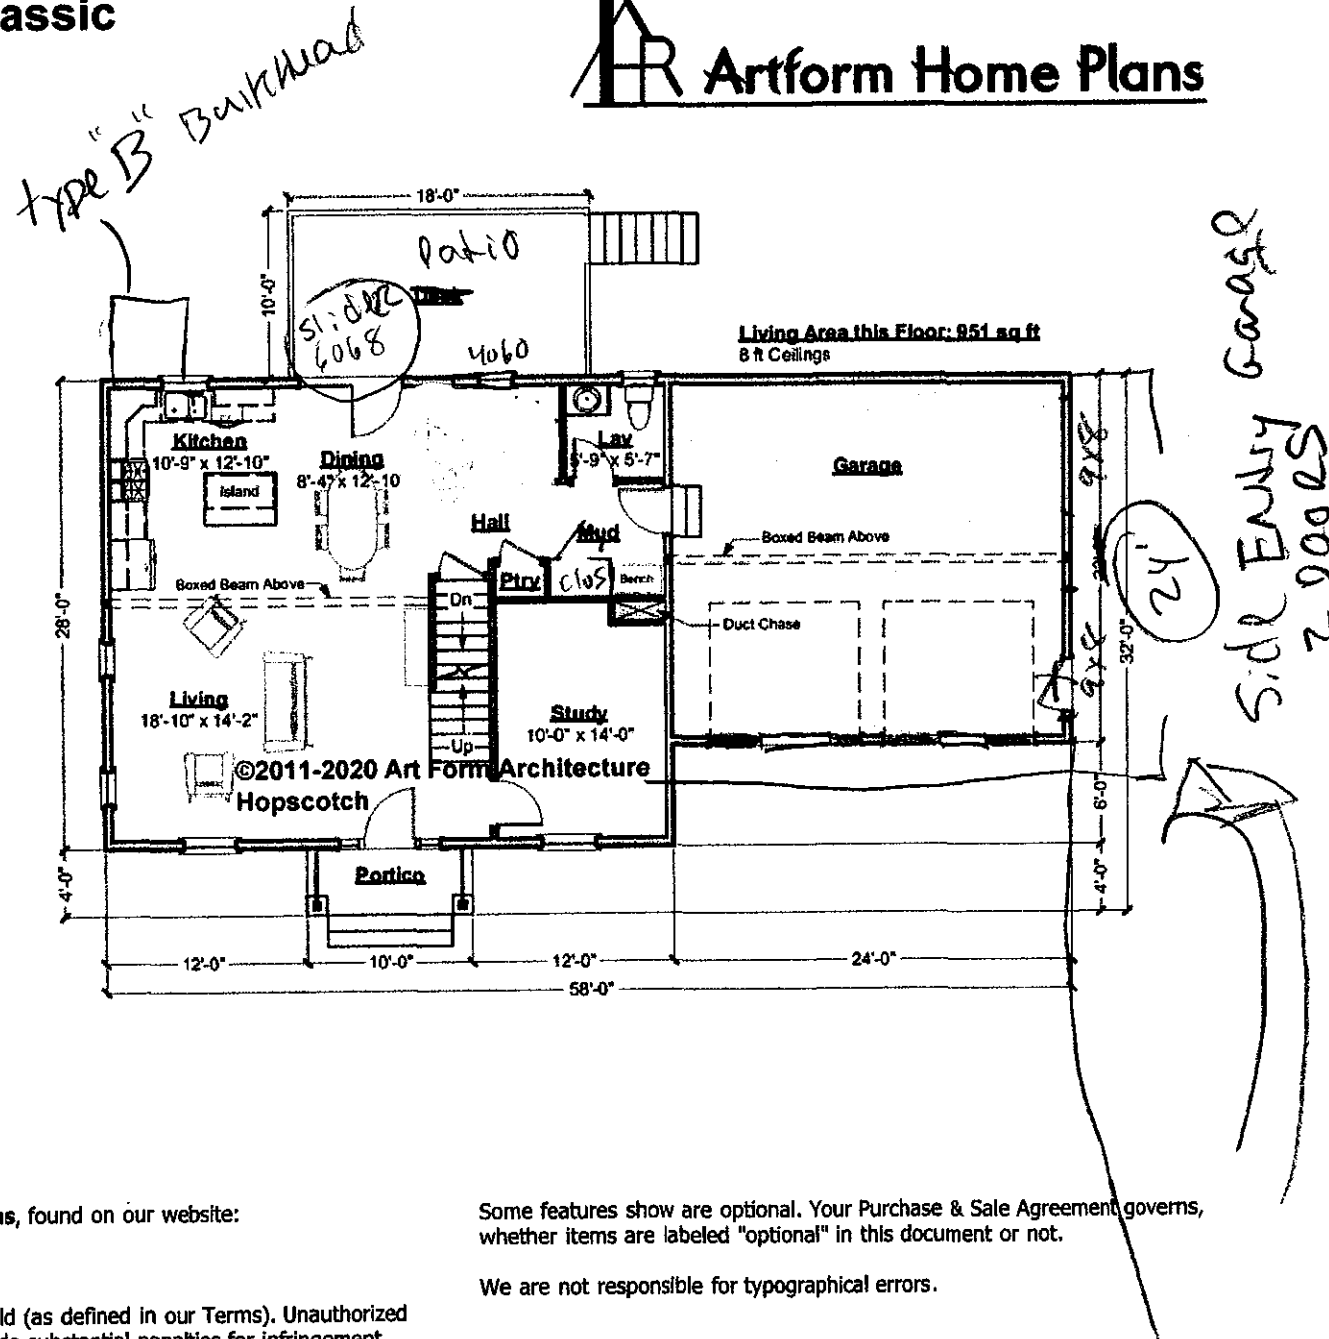

Use of this document is governed by our Terms and Conditions, found on our website:
<http://www.artformhomeplans.com/TermsConditions.a5w>

© 2011 Art Form Architecture, Inc. ALL RIGHTS RESERVED.
 You may not build this Design without purchasing a License to Build (as defined in our Terms). Unauthorized changes are not permitted and violate copyright laws, which provide substantial penalties for infringement.

Some features show are optional. Your Purchase & Sale Agreement governs, whether items are labeled "optional" in this document or not.

We are not responsible for typographical errors.

408.124.v39 KL Hopscotch Classic



Second Floor


	Area	Beds	Baths
Main	1317 SF	4	2
Future	0 SF	0	0
Apt	0 SF	0	0
Total	1317 SF	4	2

Ceiling Height

Shown 8'-0"

Possible* 8'-0"

* See Major Change Information on plan page for cost

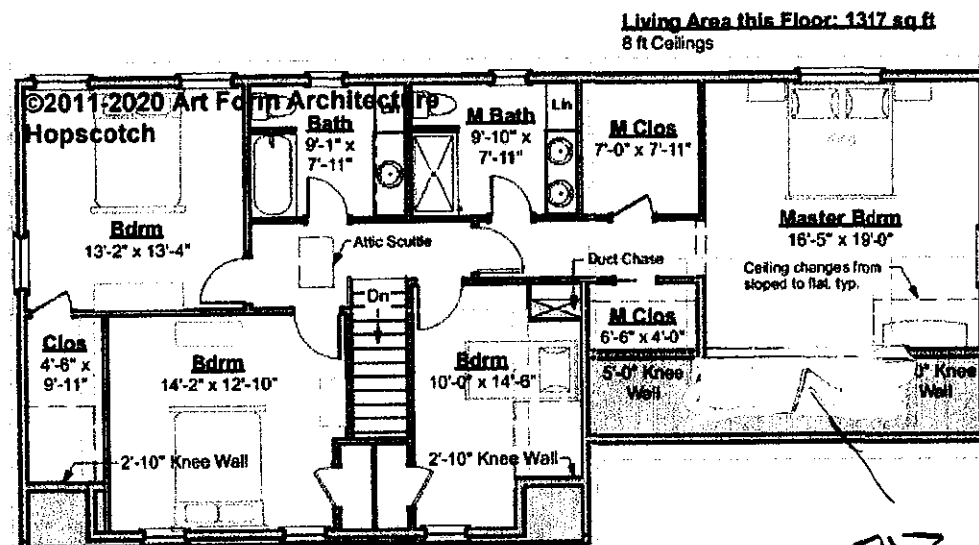

Use of this document is governed by our **Terms and Conditions**, found on our website:
<http://www.artformhomeplans.com/TermsConditions.a5w>

© 2011 Art Form Architecture, Inc. ALL RIGHTS RESERVED.
You may not build this Design without purchasing a License to Build (as defined in our Terms). Unauthorized changes are not permitted and violate copyright laws, which provide substantial penalties for infringement.

Some features shown are optional. Your Purchase & Sale Agreement governs, whether items are labeled "optional" in this document or not.

We are not responsible for typographical errors.