

7/11/2019

Orkney
959.124 GR
(7/11/2019)


© 2018 Art Form Architecture, Inc., all rights reserved. You may not build this design without purchasing a license, even if you make changes. This design may have geographic restrictions.

 **Artform Home Plans**

603-431-9559



Standard Entry Porch Option

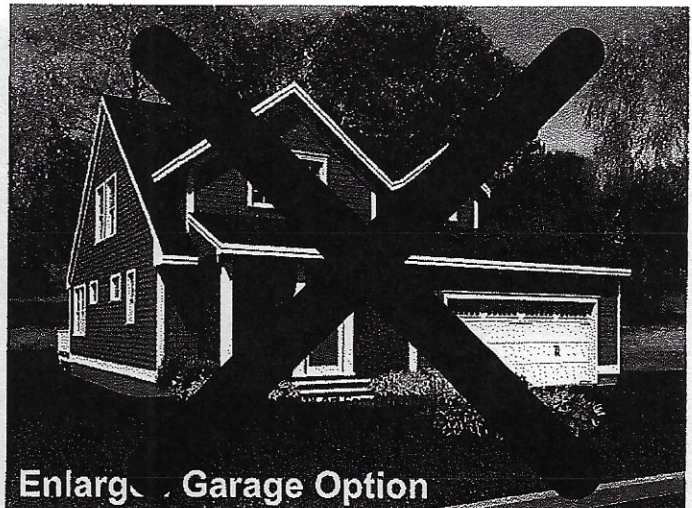

Enlarged Garage Option

JA
DD
PMH

7/11/2019


Orkney

959.124 GR
(7/11/2019)

© 2018 Art Form Architecture, Inc., all rights reserved. You may not build this design without purchasing a license, even if you make changes. This design may have geographic restrictions.

 **Artform Home Plans**


603-431-9559

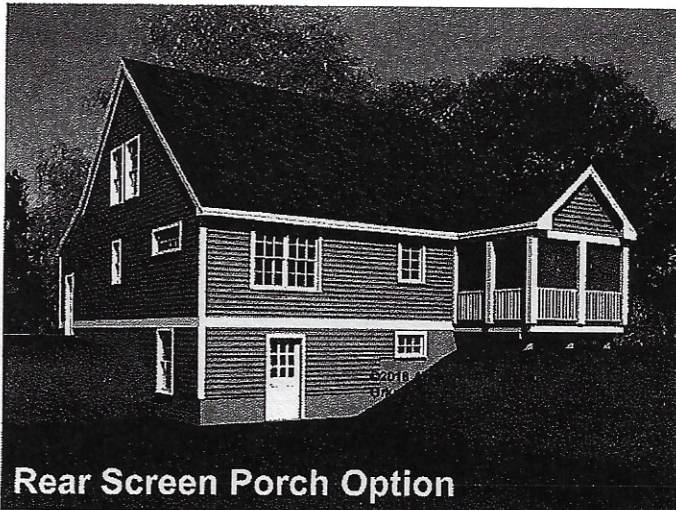

Rear Screen Porch Option



Rear Screen Porch and Deck Option

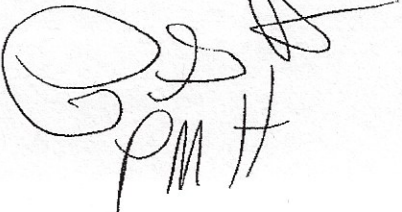

PMH

Orkney
959.124 GR
(7/11/2019)

Artform Home Plans

10'-0"
12'-0"

Screen Porch
Stair Location TBD

Living Area this Floor: 1158 sq ft
8 ft Ceiling Ht., unless noted otherwise

37'-0"

Kitchen
10'-2" x 13'-7"
Opt Island

M. Bdrm
12'-6" x 13'-7"

Dining
13'-0" x 11'-2"
Cathedral Clg.

Living
12'-11" x 14'-4"

Entry
6'-10" x 9'-0"

Lav
6'-1" x 5'-1"

Mud
6'-11" x 7'-7"

Clos
4'-10" x 7'-7"

Garage
Nominal 20'x20'

Porch
14'-6" x 6'-1"

35'-10"
6'-2"

17'-0"
37'-0"
20'-0"

6" Gas LP

Cathedral Flat Clg.

Duct Chase

Boxed Beam Above

Up
Dn

**First Floor Plan -
Screen Porch Option**
Scale: 1/8" = 1'-0"

JK

PMH


7/11/2019

Orkney
959.124 GR
(7/11/2019)

© 2018 Art Form Architecture, Inc., all rights reserved. You may not build this design without purchasing a license, even if you make changes. This design may have geographic restrictions.

 **Artform Home Plans**
603-431-9559

Living Area this Floor: 798 sq ft
8 ft Ceiling Ht.

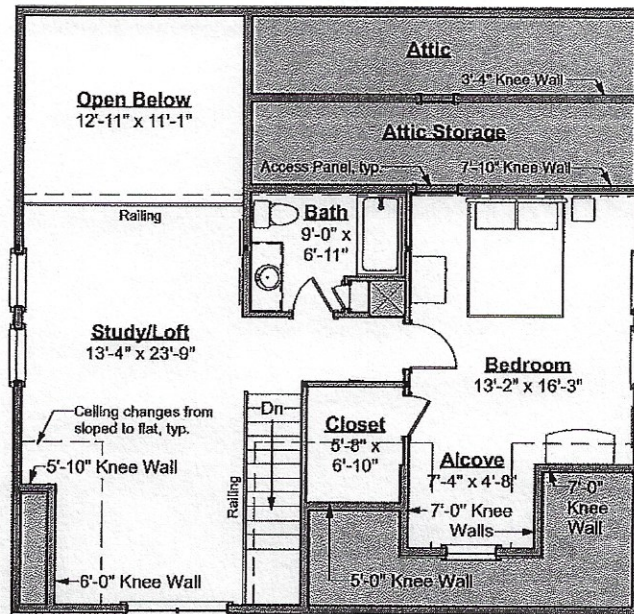

Second Floor Plan
Scale: 1/8" = 1'-0"

Handwritten signatures and initials:
JH
PMH