


© 2014 Wendy Walton, all rights reserved . You may not build this design without purchasing a license, even if you make changes. This design may have geographic restrictions.

Configuration:
127 Classic with Wing

1st Floor
Living Area this Floor: 1224 SF
9 ft Ceilings

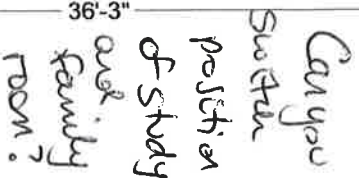

First Floor Plan

Robin Classic w Wing

495.127


© 2014 Wendy Walton, all rights reserved. You may not build this design without purchasing a license, even if you make changes. This design may have geographic restrictions.

Artform Home Plans

603-431-9559

1. Switch laundry room - with Family Bathroom
2. move Master Bath & Master closet + reconfigure so bath + closet are closer together - Master Bedroom is larger if possible.

Configuration:
127 Robin, Classic with Wing
2nd Floor
Living Area this Floor: 1534 SF

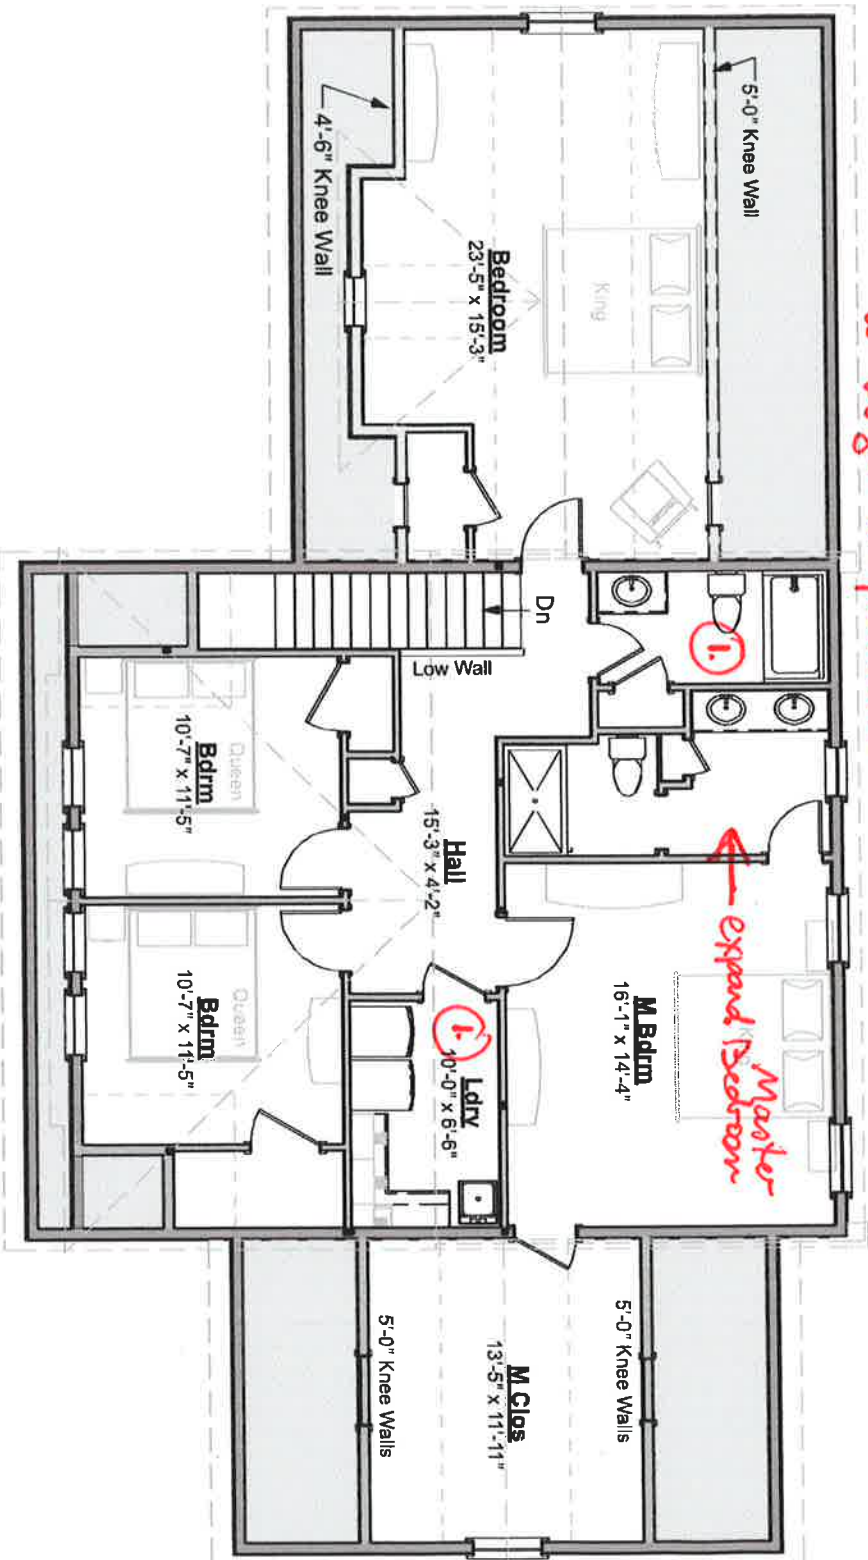

Master bath + closet here

Second Floor Plan