


master bath increased by 3' +/-
space removed from main bath

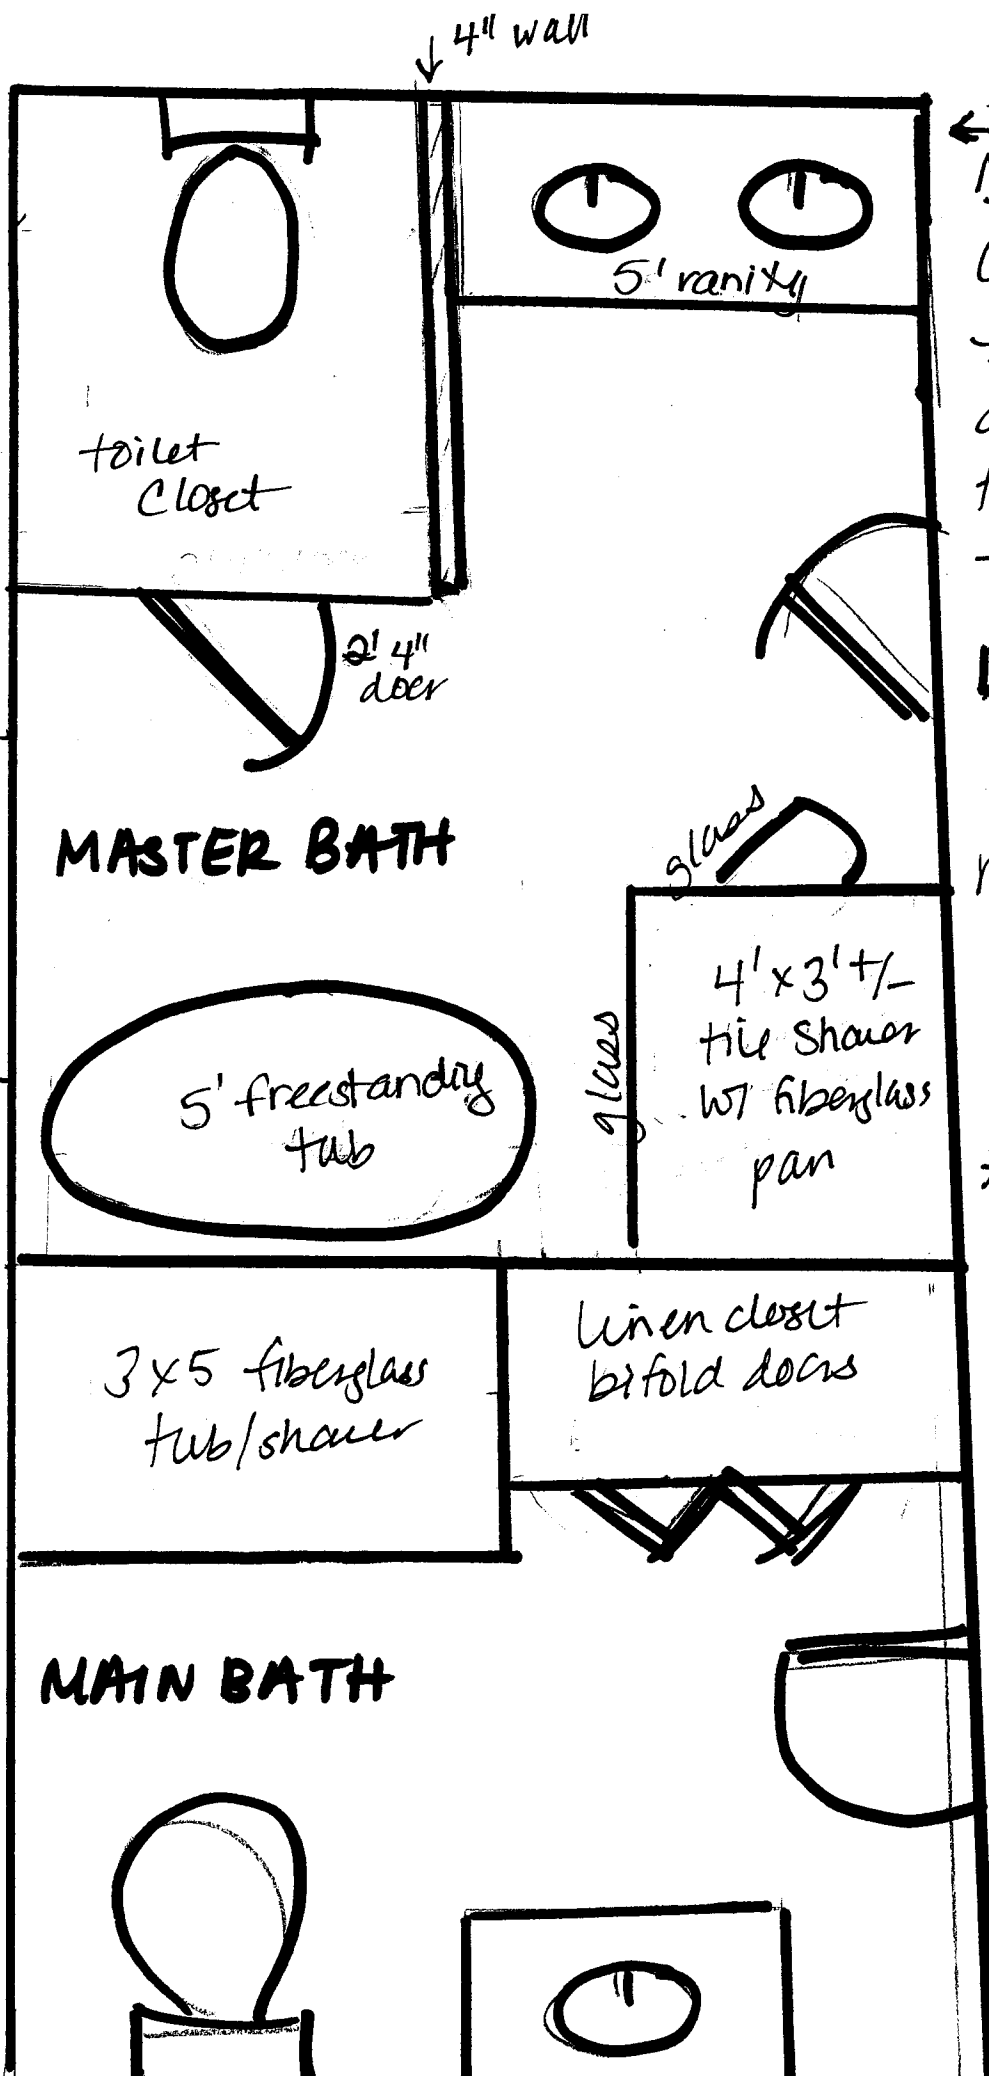

Note - vanity
cannot be larger
than 62" in
order to fit
toilet closet

Lot 14 Banfield

Proposed
master/main
bath
reconfiguration

*dimensions are
approximate,
drawing not to
scale.

Buyer sign off: