

7/11/2019


Vanilla Grand Torte

594.124.v2 KR
(7/11/2019)

© 2013-2018 Art Form Architecture, Inc., all rights reserved .
You may not build this design without purchasing a license,
even if you make changes. This design may have geographic
restrictions.

Artform Home Plans

603-431-9559

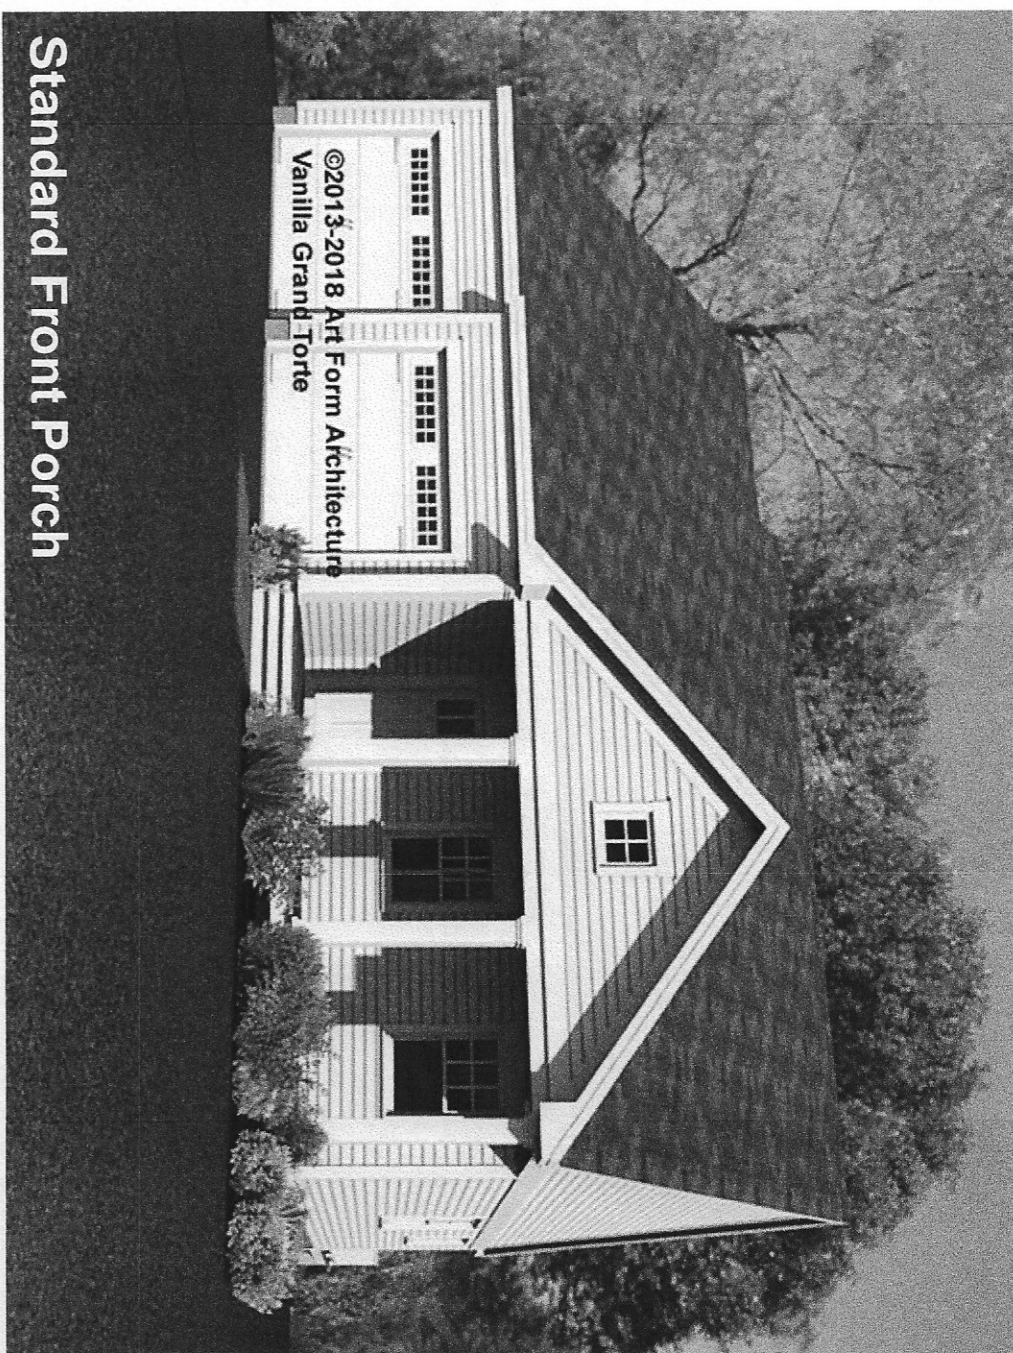

Standard Front Porch

Some items shown are optional and/
or may vary. Builder's written
specifications always govern.

1. Gas fireplace and it's surround or mantel
2. Kitchen - island, cabinet style & trim, countertop material, etc.
3. Door styles and trim
4. Window grilles and trim, window treatments
5. Stair balusters or low walls at stairs
6. Lighting
7. Material selections (flooring, siding, roofing, paint colors, etc.)
8. Other furnishings
9. Landscaping, paving and walkways
10. Gutters, shutters and other exterior trim components
11. Deck size, railing style, stair location, etc.
12. Amount of exposed basement and/or wood framed walls at basement.

These images are not of any specific building site. Sun and view through windows will vary, as will the site around the house on the exterior and the slope of the land.

RTB
08/11/20
9:37 AM EDT
dclloop verified

LB
08/11/20
9:39 AM EDT
dclloop verified


7/11/2019
Vanilla Grand Torte
 594.124.V2 KR
 (7/11/2019)

© 2013-2018 Art Form Architecture, Inc., all rights reserved.
 You may not build this design without purchasing a license,
 even if you make changes. This design may have geographic
 restrictions.

Artform Home Plans

603-431-9559

* If pocket door
 cannot fit at top of
 basement stairs, please
 put at bottom of stairs
 at entrance to finished
 room.

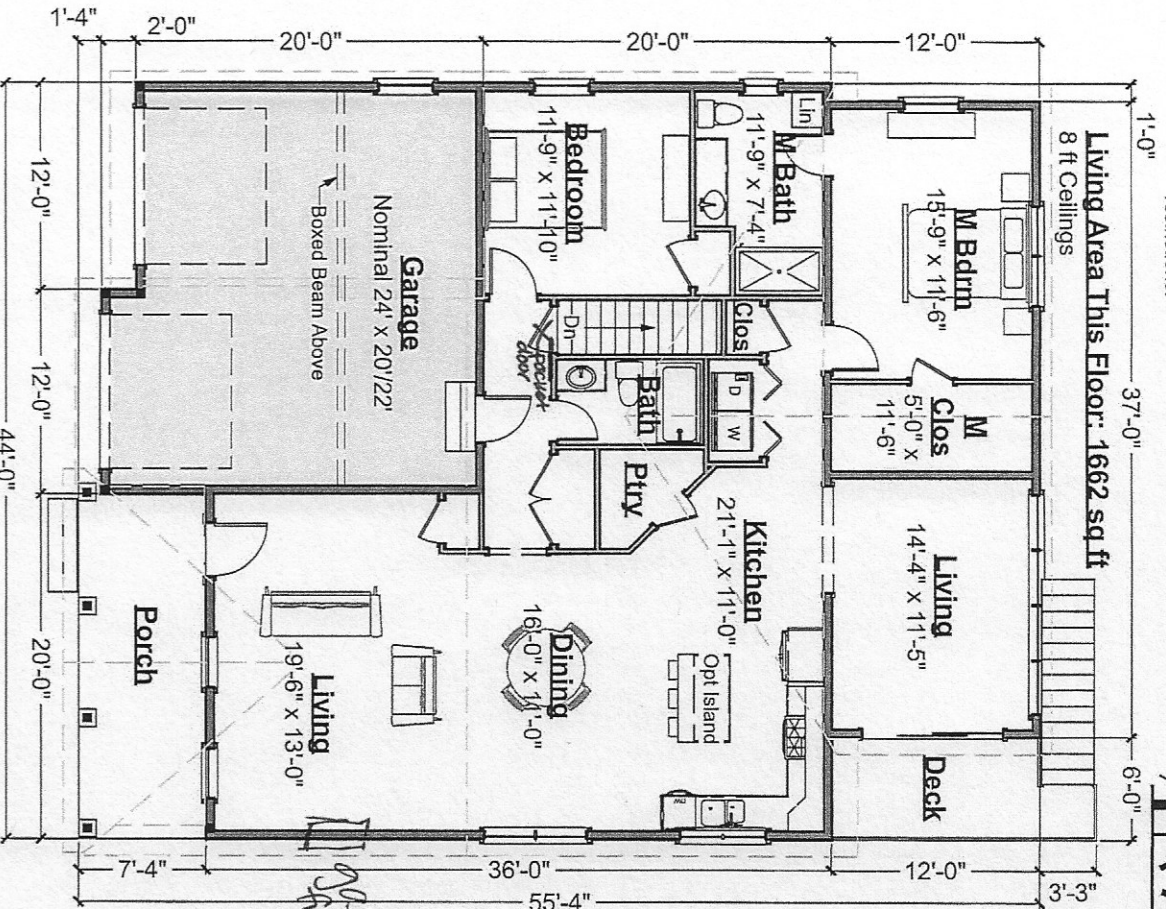

First Floor Plan - 3-Season Porch & Deck Option

Scale: 3/32" = 1'-0"

RB 08/11/20 9:37 AM EDT dotloop verified

LB 08/11/20 9:39 AM EDT dotloop verified

7/11/2019

Vanilla Grand Torte


594.124.v2 KR

(7/11/2019)

© 2013-2018 Art Form Architecture, Inc., all rights reserved .
You may not build this design without purchasing a license,
even if you make changes. This design may have geographic
restrictions.

Artform Home Plans

603-431-9559

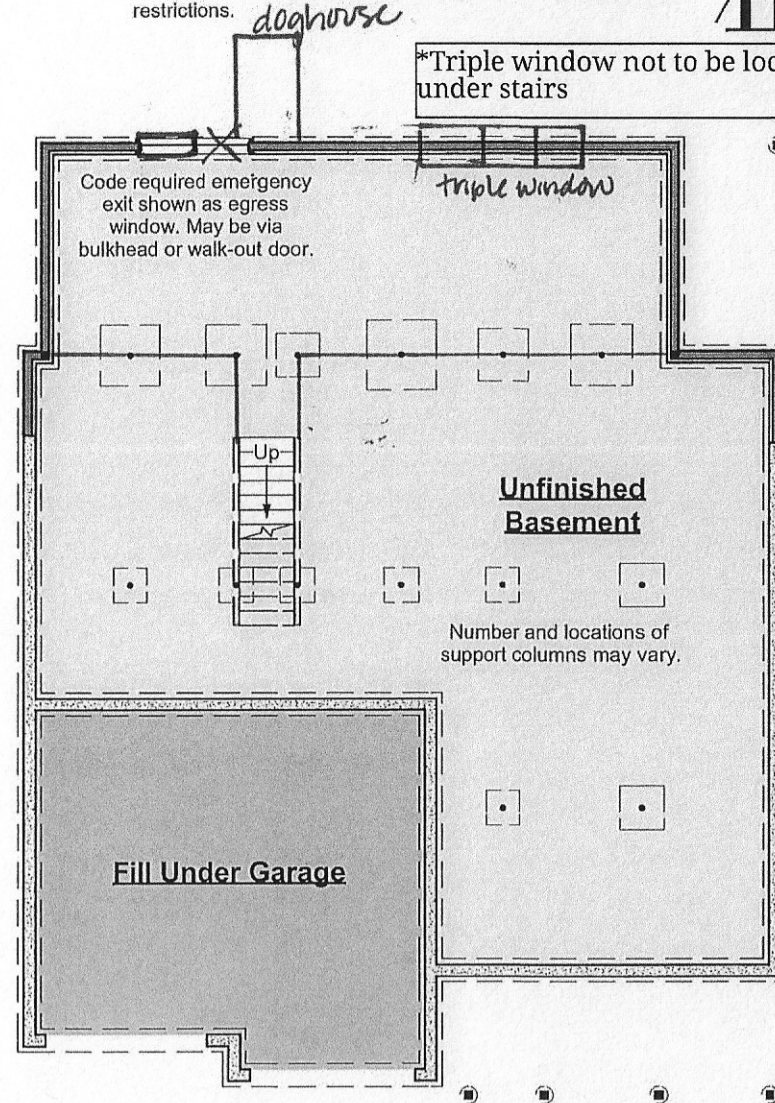

Foundation Plan

Scale: 3/32" = 1'-0"

RLB
08/11/20
9:37 AM EDT
dotloop verified

LB
08/11/20
9:39 AM EDT
dotloop verified