


Orkney
959.124 GR
(7/11/2019)

© 2018 Art Form Architecture, Inc., all rights reserved. You may not build this design without purchasing a license, even if you make changes. This design may have geographic restrictions.


4 Truck Drive

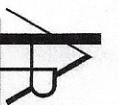

Artform Home Plans

603-431-9559

Living Area this Floor: 1158 sq ft
8 ft Ceiling Ht., unless noted otherwise

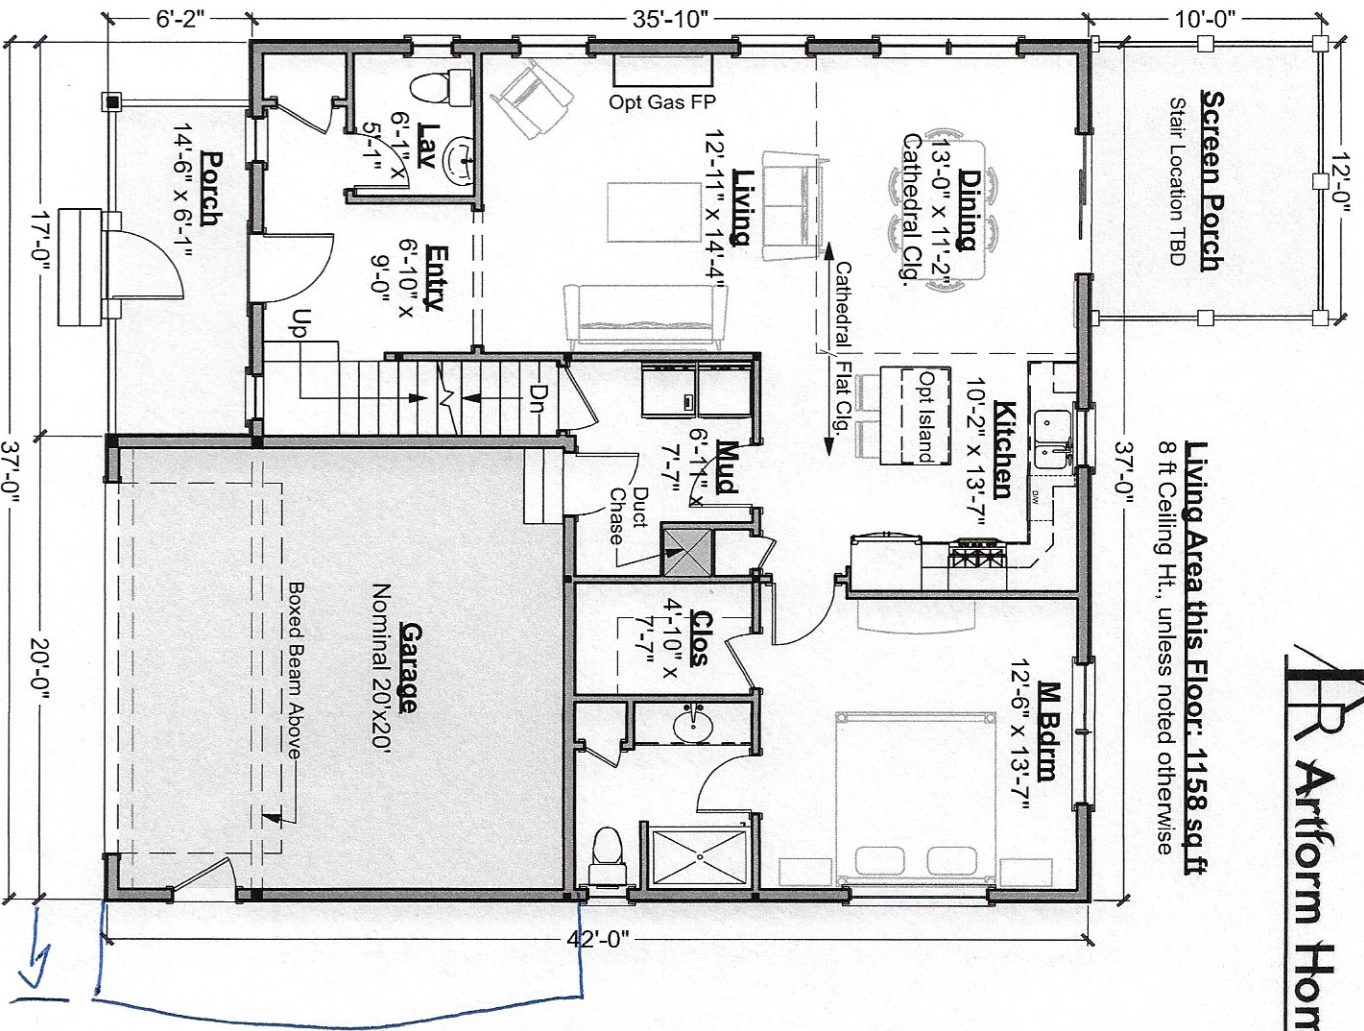

**First Floor Plan -
Screen Porch Option**
Scale: 1/8" = 1'-0"

41

7/11/2019

Orkney


959.124 GR
(7/11/2019)

© 2018 Art Form Architecture, Inc., all rights reserved. You may not build this design without purchasing a license, even if you make changes. This design may have geographic restrictions.



603-431-9559

Living Area this Floor: 798 sq ft
8 ft Ceiling Ht.

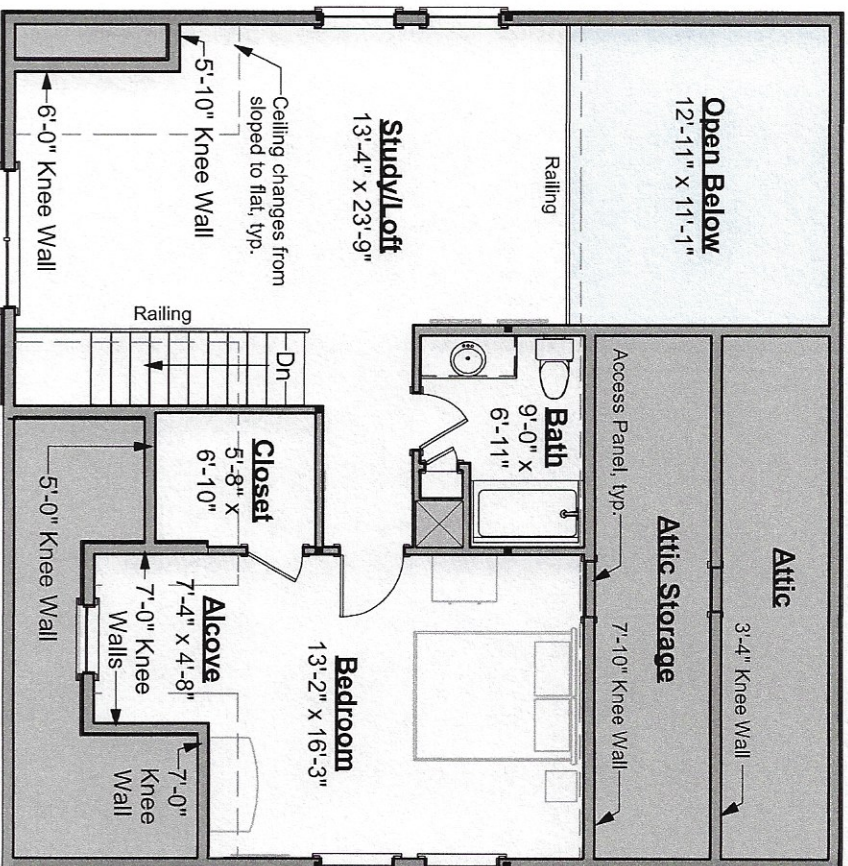

Second Floor Plan

Scale: 1/8" = 1'-0"