
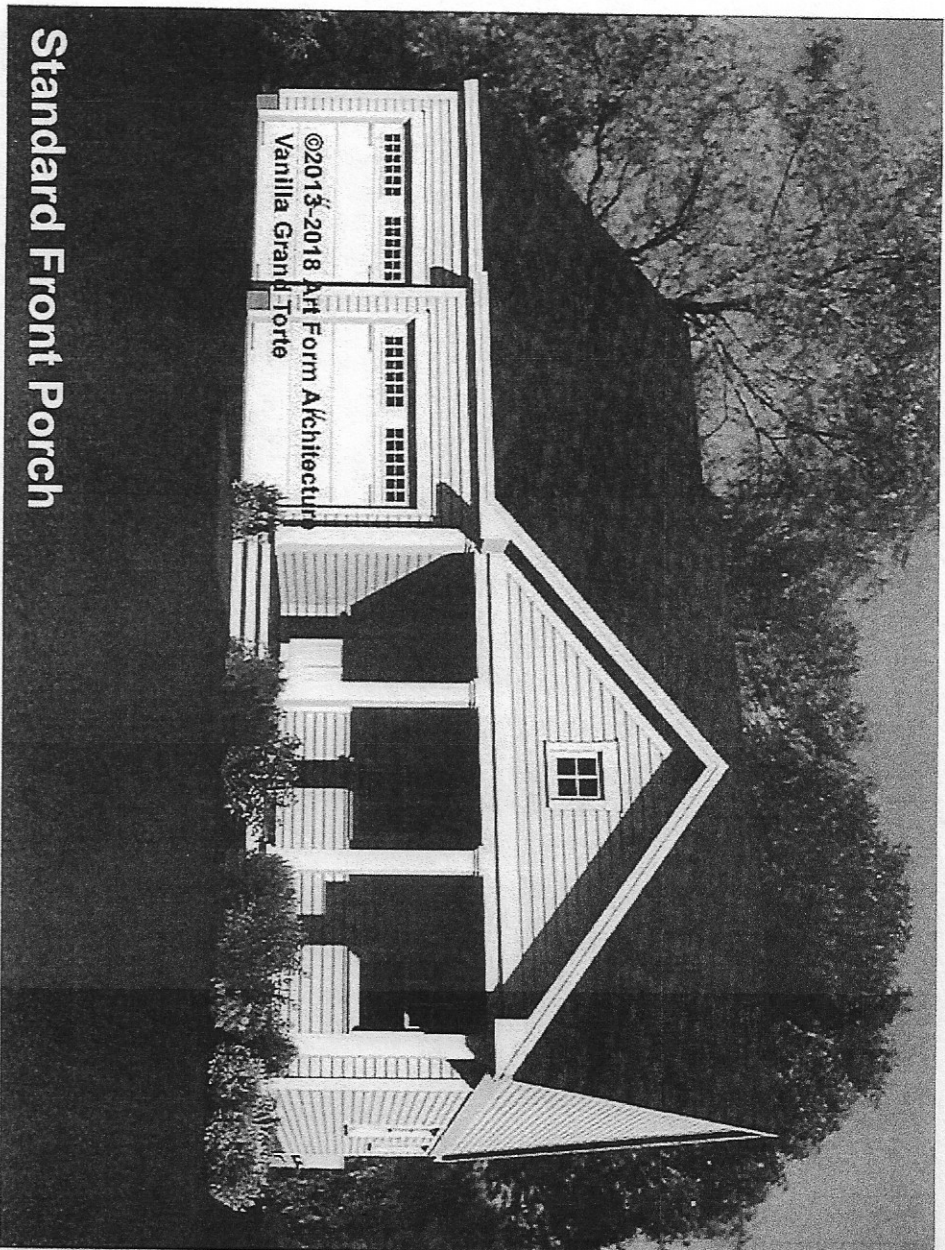


7/11/2019
Vanilla Grand Torte
594.124.v2 KR
(7/11/2019)

© 2013-2018 Art Form Architecture, Inc., all rights reserved.
You may not build this design without purchasing a license,
even if you make changes. This design may have geographic
restrictions.

 **Artform Home Plans**

603-431-9559



Standard Front Porch

garage
right

Some items shown are optional and/or may vary. Builder's written specifications always govern.

1. Gas fireplace and it's surround or mantel
2. Kitchen - island, cabinet style & trim, countertop material, etc.
3. Door styles and trim
4. Window grilles and trim, window treatments
5. Stair balusters or low walls at stairs
6. Lighting
7. Material selections (flooring, siding, roofing, paint colors, etc.)
8. Other furnishings
9. Landscaping, paving and walkways
10. Gutters, shutters and other exterior trim components
11. Deck size, railing style, stair location, etc.
12. Amount of exposed basement and/or wood framed walls at basement.

These images are not of any specific building site. Sun and view through windows will vary, as will the site around the house on the exterior and the slope of the land.


06/16/20
8:34 PM EDT
dotloop verified

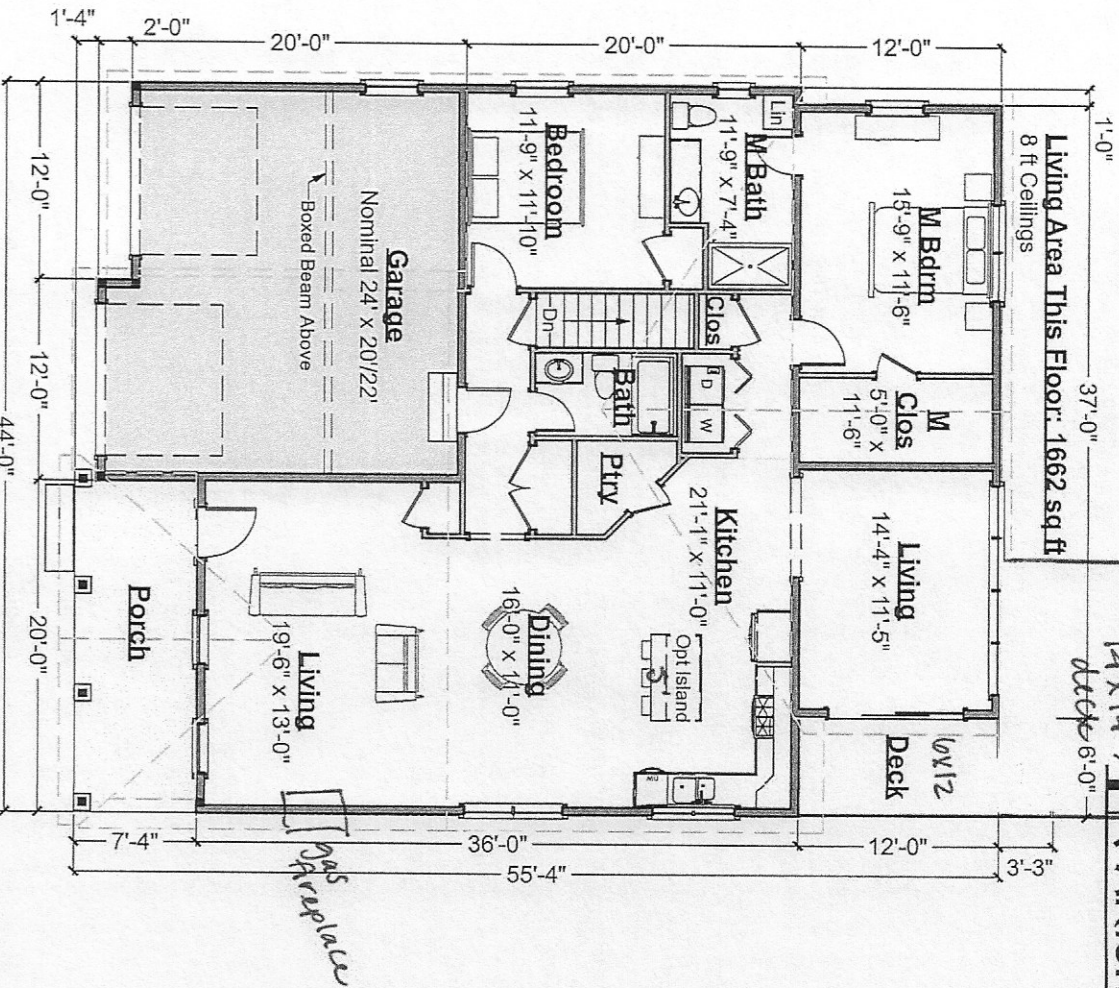

06/16/20
8:37 PM EDT
dotloop verified



7/11/2019
Vanilla Grand Torte
 594.124.v2 KR
 (7/11/2019)

© 2013-2018 Art Form Architecture, Inc., all rights reserved.
 You may not build this design without purchasing a license,
 even if you make changes. This design may have geographic
 restrictions.

Artform Home Plans
 603-431-9559



First Floor Plan - 3-Season Porch & Deck Option

Scale: 3/32" = 1'-0"

06/16/20 8:34 PM EDT
 06/16/20 8:37 PM EDT
 Artform verified