


7/11/2019

# Vanilla Grand Torte


594.124.v2 KR

(7/11/2019)

© 2013-2018 Art Form Architecture, Inc., all rights reserved. You may not build this design without purchasing a license, even if you make changes. This design may have geographic restrictions.

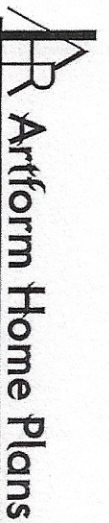

603-431-9559

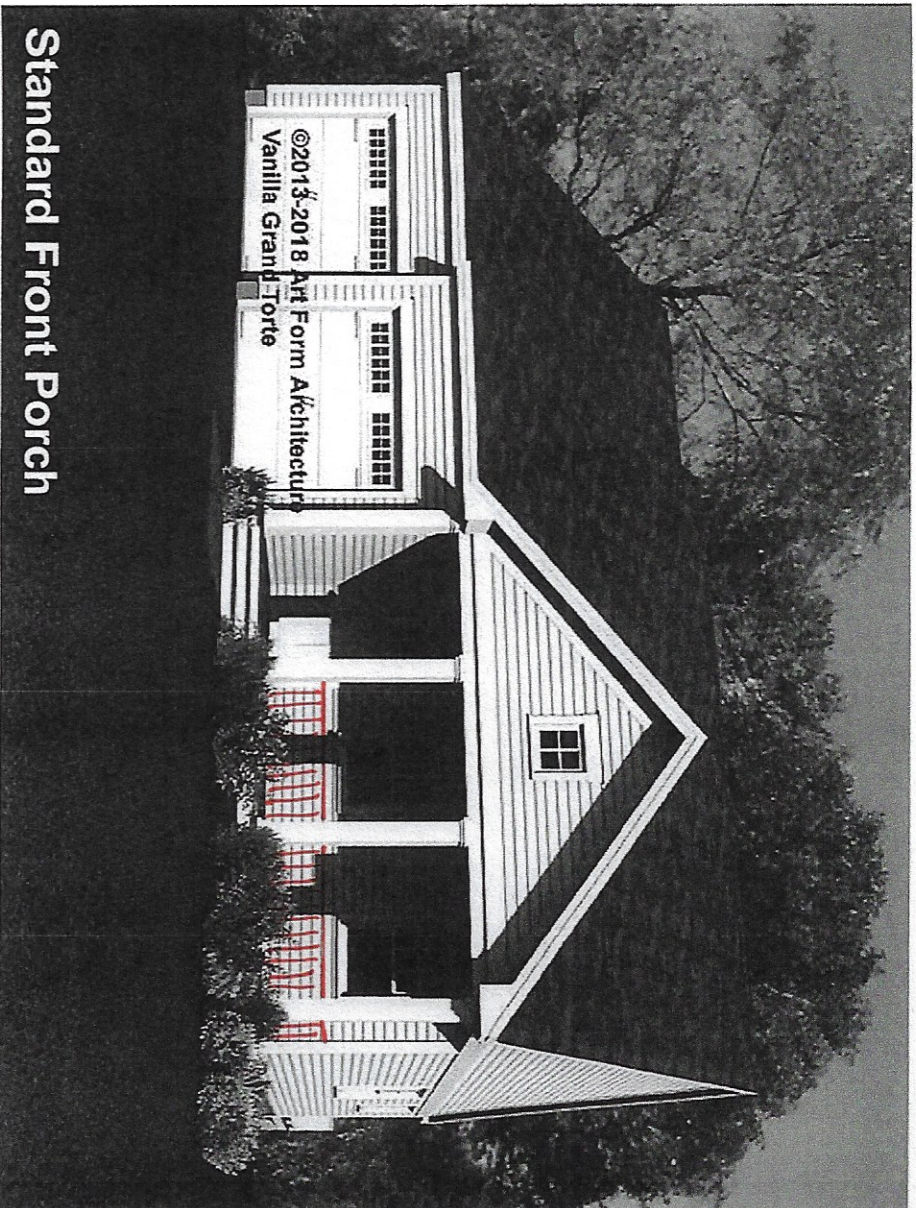

## Standard Front Porch

Some items shown are optional and/or may vary. Builder's written specifications always govern.

1. Gas fireplace and it's surround or mantel
2. Kitchen - island, cabinet style & trim, countertop material, etc.
3. Door styles and trim
4. Window grilles and trim, window treatments
5. Stair balusters or low walls at stairs
6. Lighting
7. Material selections (flooring, siding, roofing, paint colors, etc.)
8. Other furnishings
9. Landscaping, paving and walkways
10. Gutters, shutters and other exterior trim components
11. Deck size, railing style, stair location, etc.
12. Amount of exposed basement and/or wood framed walls at basement.

These images are not of any specific building site. Sun and view through windows will vary, as will the site around the house on the exterior and the slope of the land.

9B	9B
09/15/20 8:30 PM EDT dotloop verified	09/15/20 8:28 PM EDT dotloop verified

9#2




7/11/2019  
**Vanilla Grand Torte**  
**594.124.v2 KR**  
(7/11/2019)

© 2013-2018 Art Form Architecture, Inc., all rights reserved.  
You may not build this design without purchasing a license,  
even if you make changes. This design may have geographic  
restrictions.

**Artform Home Plans**

603-431-9559

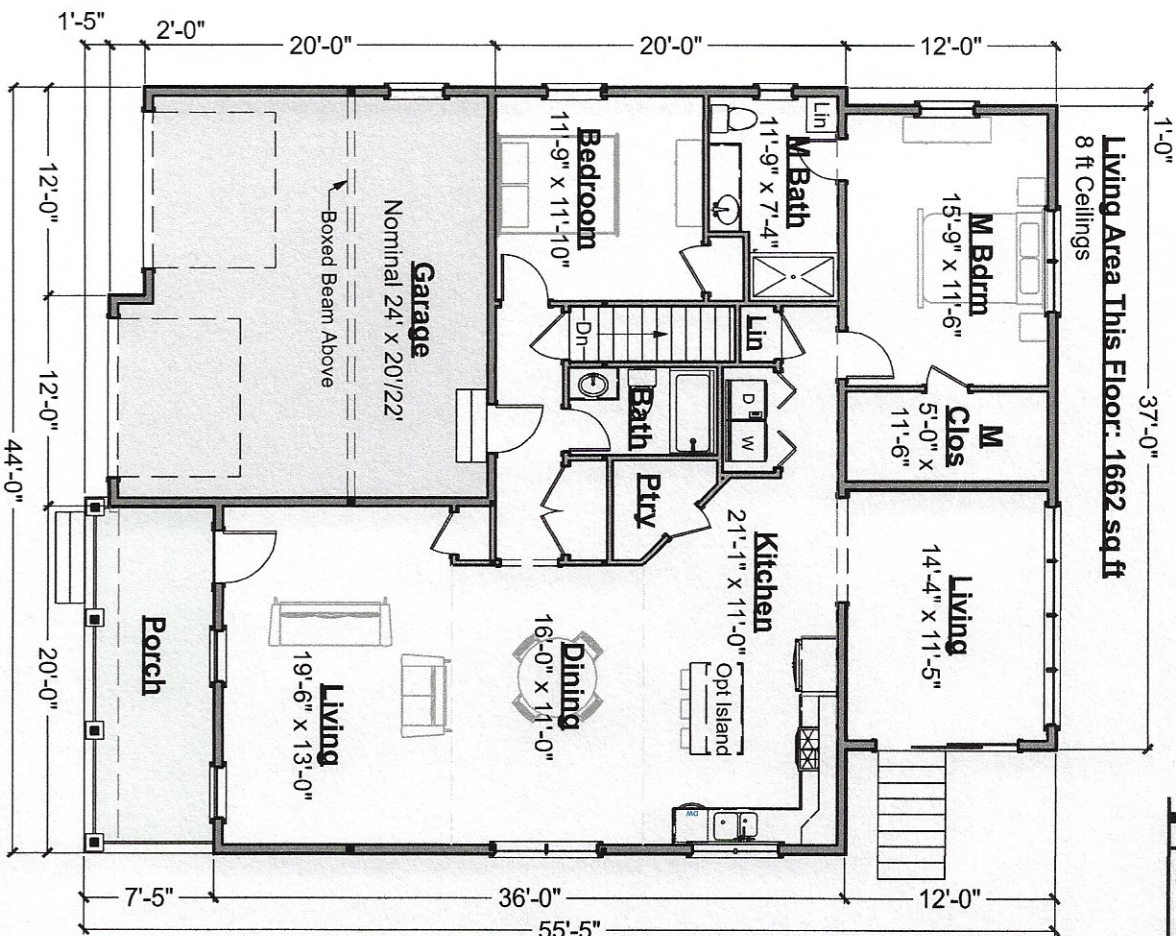

**First Floor Plan - 3-Season Porch Option**

Scale: 3/32" = 1'-0"

09/15/20 823 PM EDT dotloop verified	09/15/20 823 PM EDT dotloop verified
--	--



7/11/2019

# Vanilla Grand Torte

594.124.v2 KR  
(7/11/2019)

© 2013-2018 Art Form Architecture, Inc., all rights reserved.  
You may not build this design without purchasing a license,  
even if you make changes. This design may have geographic  
restrictions.


*doghouse*

*2 foundation windows*

Code required emergency  
exit shown as egress  
window. May be via  
bulkhead or walk-out door.

*12x20*

*finished room*

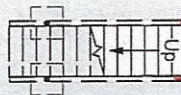

Unfinished  
Basement

Number and locations of  
support columns may vary.

Fill Under Garage

**Artform Home Plans**

603-431-9559

<i>92</i>	<i>92</i>
09/15/20 8:30 PM EDT dotloop verified	09/15/20 8:28 PM EDT dotloop verified

*92*

**Foundation Plan**  
Scale: 3/32" = 1'-0"