
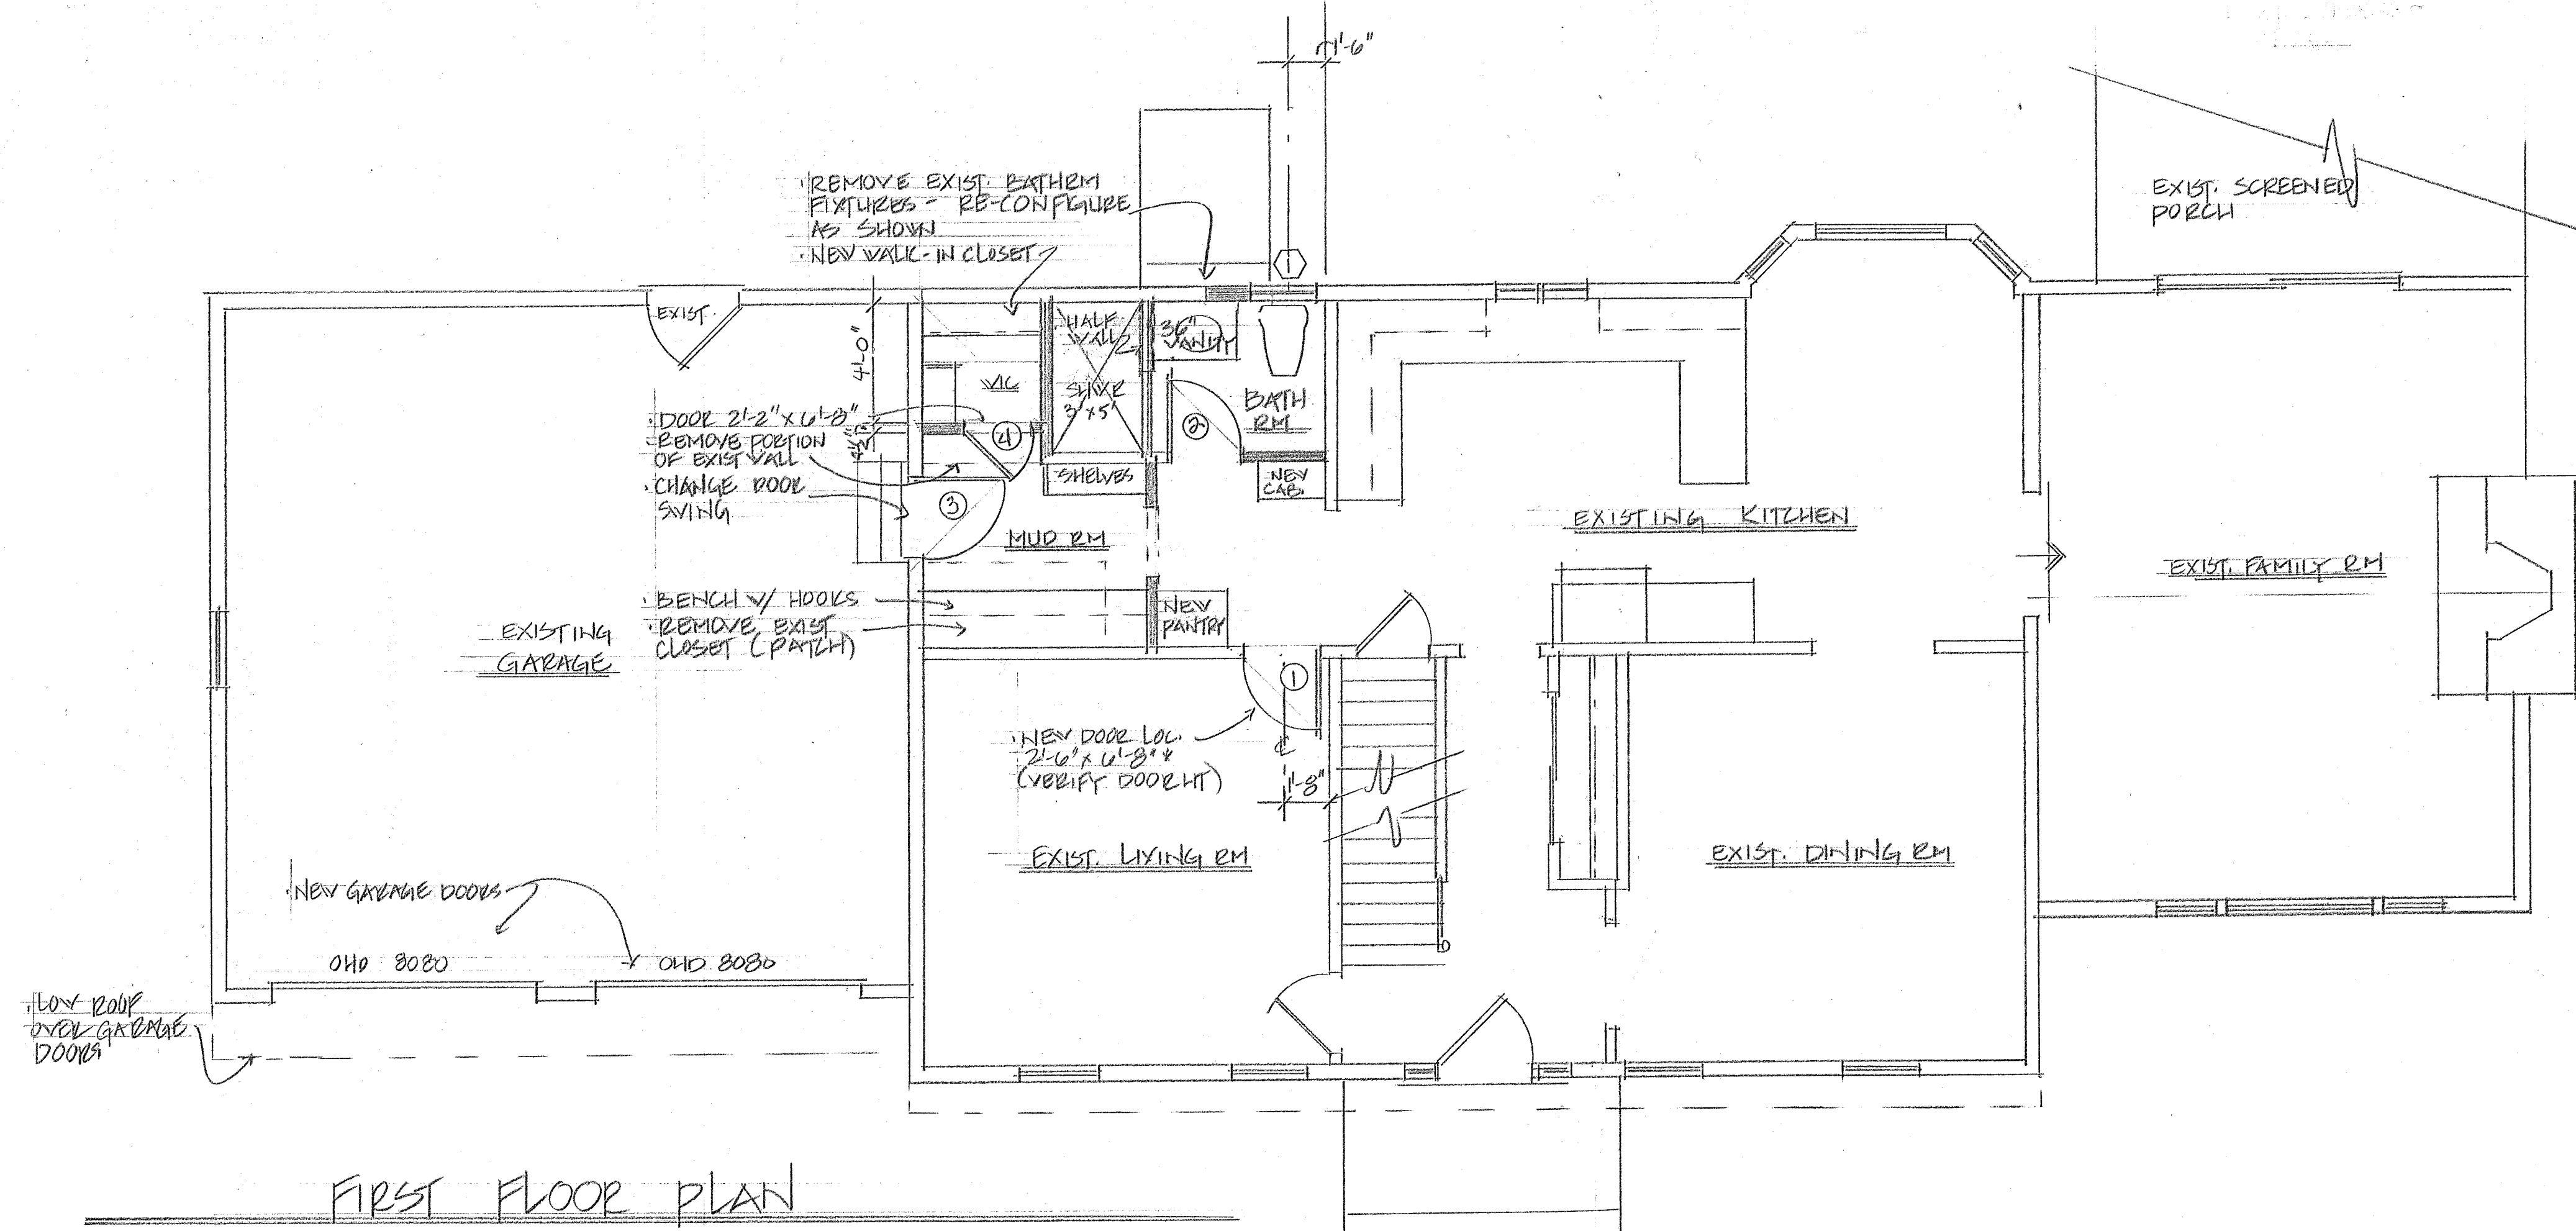


NOTES:

REMOVE EXIST. MASTER BATHRM
CLOSET - (ALL DRYWALL PARTITIONS)
RAISE VALL HT IN NEW MASTER
SUITE OVER GARAGE.
ALIGN VALL HEIGHT w/
EXISTING ON REAR OF HOUSE
* LOWER BAYE HT ON GARAGE
FRONT.

FAMILY BATH NOTES:

RECESS NEW VANITY IN BATHRM
AS SHOWN
REMOVE SHOWER - INSTALL NEW TUB

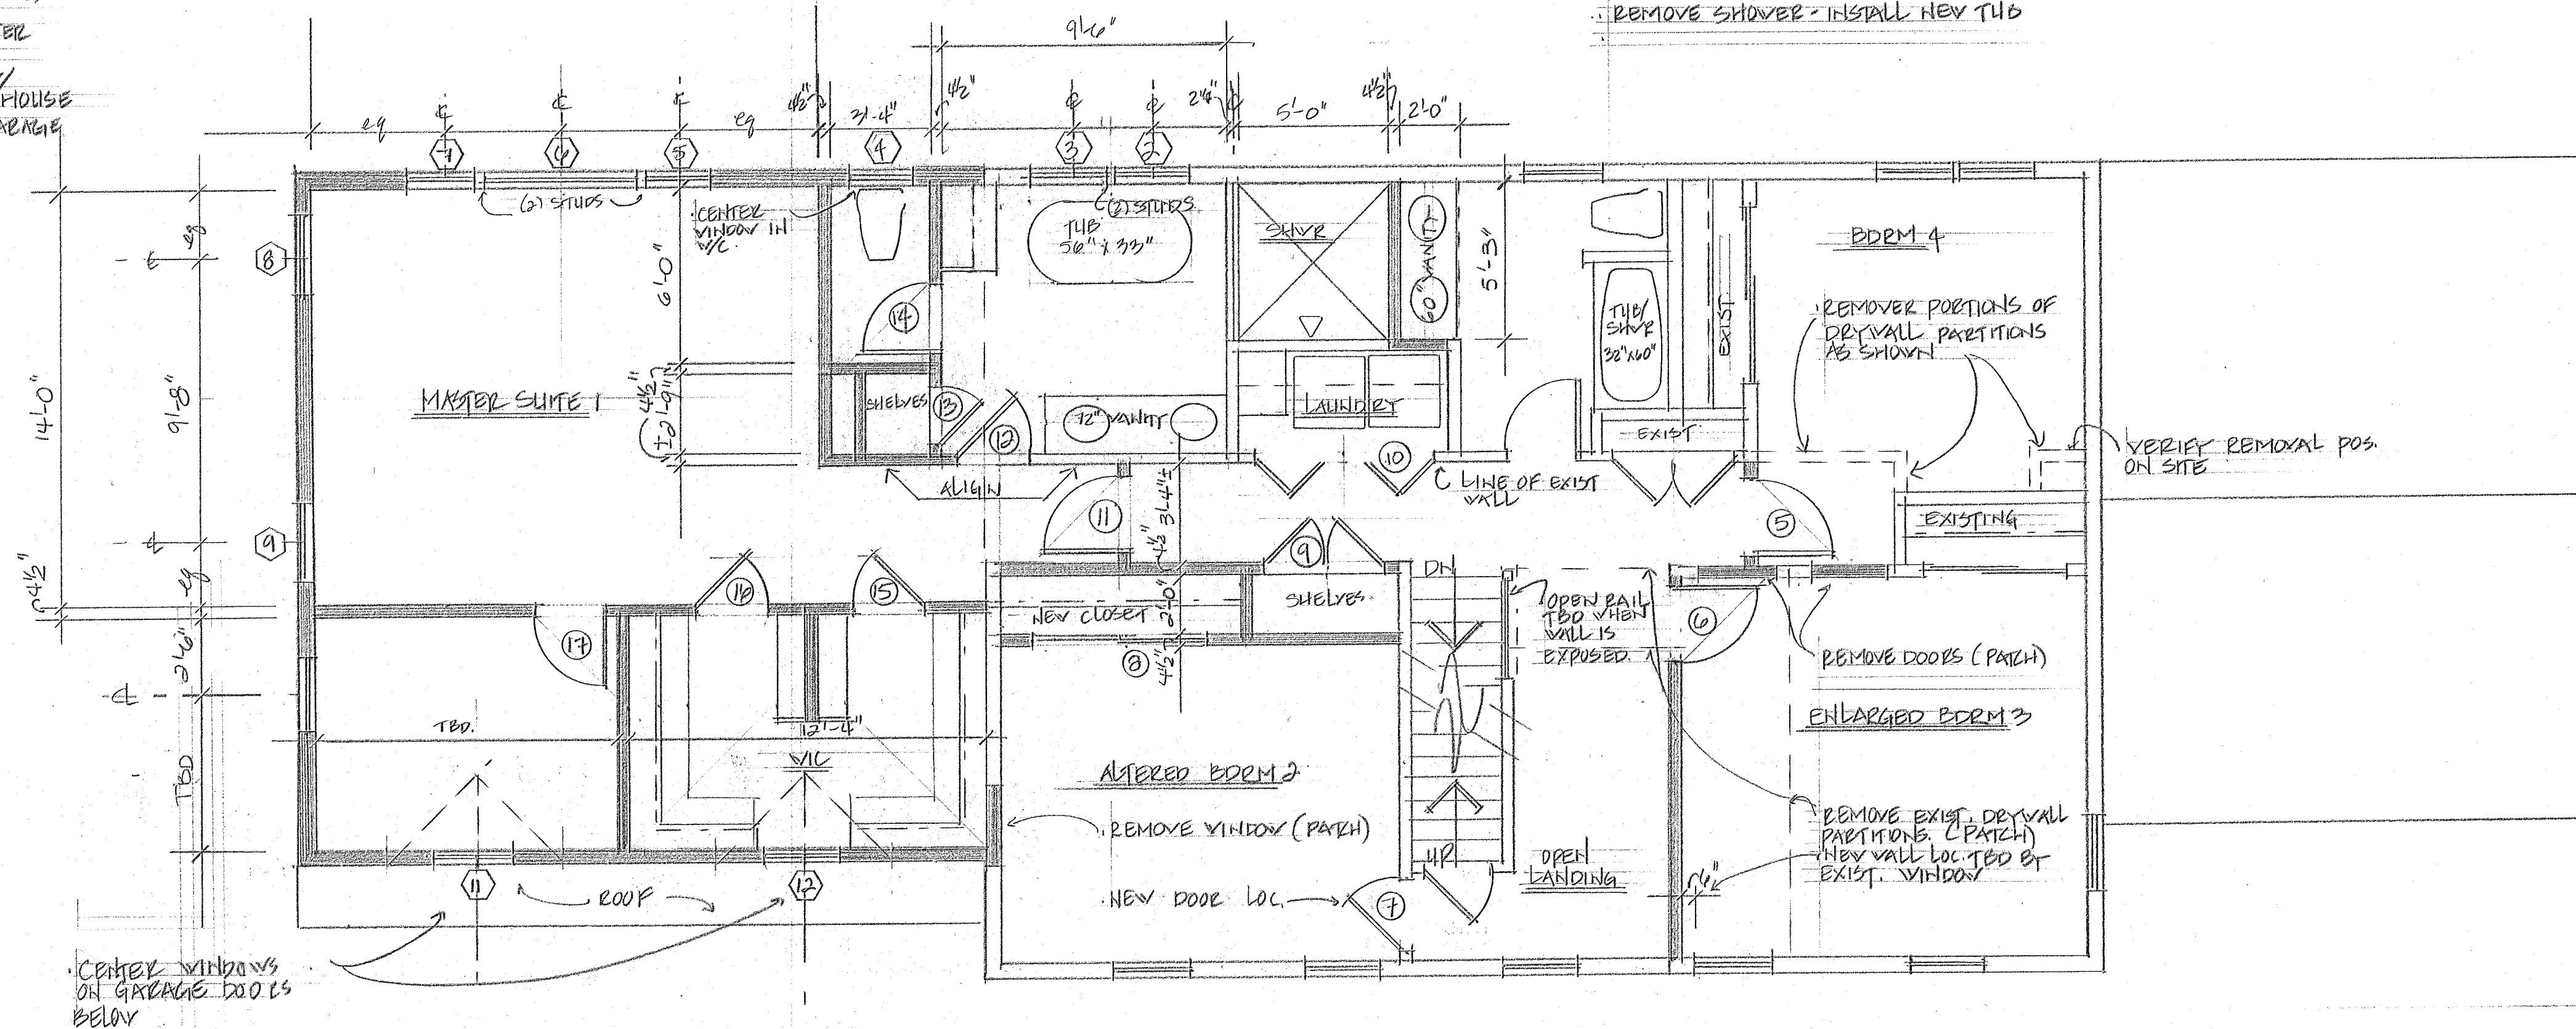

REVISIONS	BY

DZUIRA RESIDENCE

7 DOLAN DR., GROTON, MA

FLOOR PLANS

DRAWN
CHECKED
DATE
SCALE 1/4" = 1'-0"
JOB NO.
SHEET
OF SHEETS


REVISIONS	BY



NOTE: WINDOWS ON EXISTING NOT SHOWN CORRECTED AFTER SITE MEASURE. (SEE 2ND FL. PLAN AS-BUILT FOR CORRECT MEASUREMENTS.)

*WINDOW MANUF. TYP.
*ADJUST WINDOW SIZES IF BRAND AS NEEDED

WINDOW SCHEDULE			
NO	FO DIMENSION	DESCRIPTION	LOCATION
1	2'-2 1/2" x 2'-1"	DEL HUNG 6/6 USE EXIST IF POSS.	1ST FL. EXTERIOR
2	2'-6" x 4'-5"	DEL HUNG 6/1 TEMPERED	MASTER BATH
3			
4	2'-2 1/2" x 2'-1"	DEL HUNG 6/6	
5	2'-2 1/2" x 4'-9"		MASTER SUITE
6	5'-0" x 4'-9"	PICTURE UNIT (gulls) TYP.	
7	2'-2 1/2" x 4'-9"	DEL HUNG 6/6	
8	2'-6" x 4'-5"		
9			
10			
11			
12			

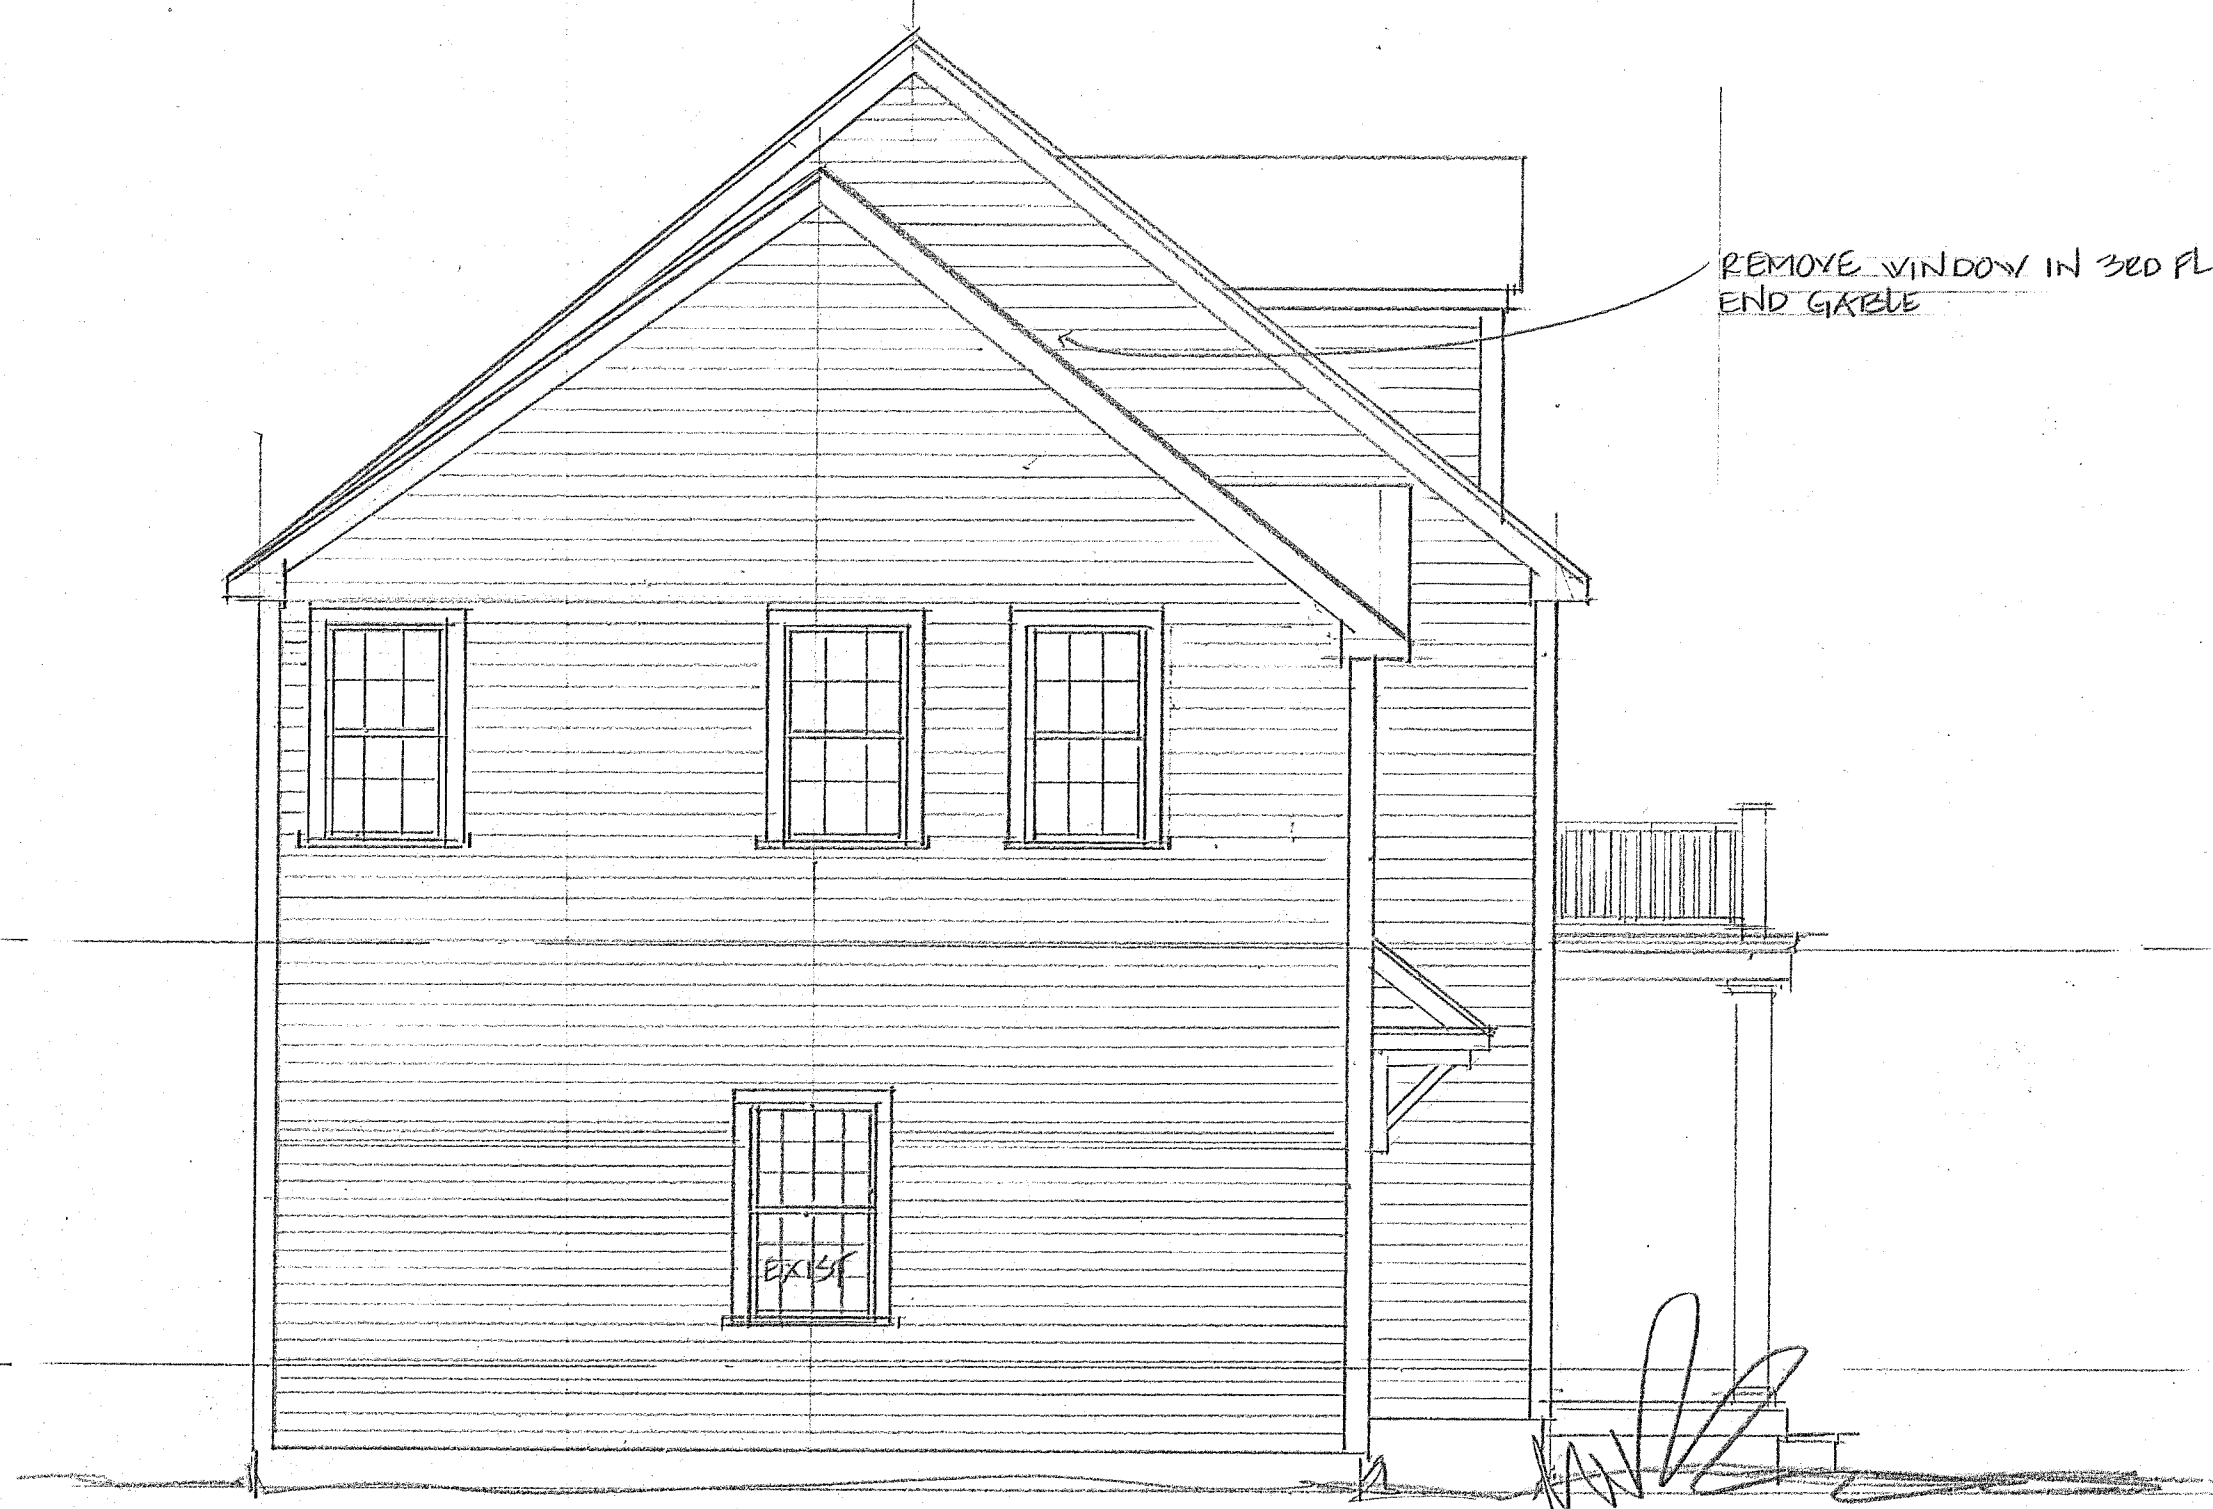


SIDE ELEVATION

DOOR SCHEDULE			
NO	UNIT DIMENSION	DESCRIPTION	LOCATION
1	2'-6" x 6'-8"	MATCH EXIST. INT. DOOR STYLE	LIVING RM
2			BATH RM
3	2'-8" x 6'-8"	STEEL	MUD RM
4	2'-2" x 6'-8"		
5	2'-6" x 6'-8"		BDRM 4
6			BDRM 3
7			BDRM 2
8	6'-0" x 6'-8"	SLIDING CL. DOORS	
9	(2x) 2'-0" x 6'-8"		LINEN CL
10	6'-0" x 6'-8" OPENING	BI-FOLD	LAUNDRY
11	2'-6" x 6'-8"		MASTERSUITE
12			
13	2'-0" x 6'-8"		
14	2'-4" x 6'-8"		
15			
16			
17	2'-6" x 6'-8"	INTERIOR FRENCH	

*NOTE: RE-USE EXISTING DOORS WHEN POSSIBLE

DZURA RESIDENCE
7 DULAN DR., GROTON, MA
ELEVATIONS


DRAWN
CHECKED
DATE
SCALE 1/4" = 1'-0"
JOB NO.
SHEET
OF SHEETS

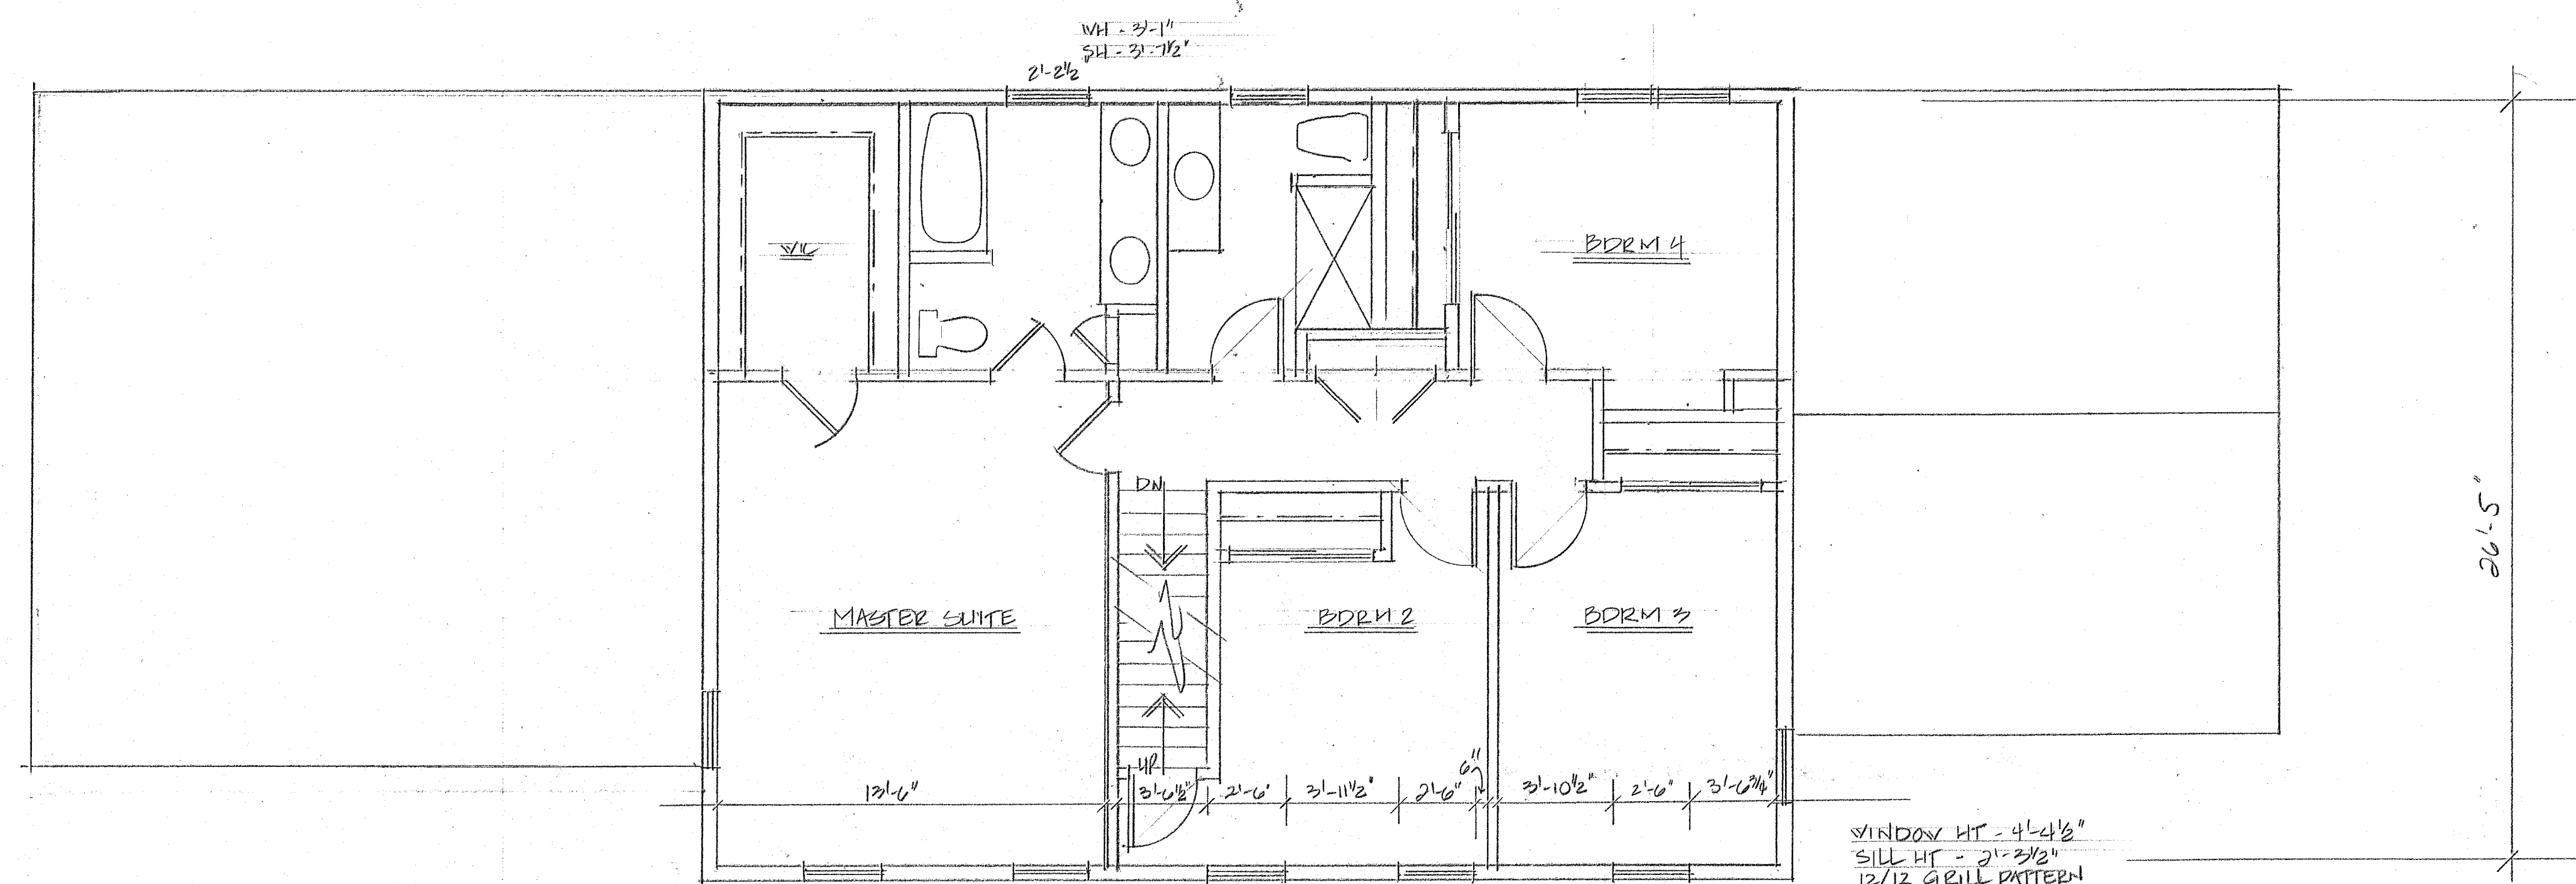

SECOND FLOOR PLAN AS-BUILT

NOTES:

- FIRST FLOOR CH = 7'-7"
- SECOND FL CH = 7'-7"
- THIRD FLOOR - PL. TV PROF BIDGE = 10'-1"
- THIRD FL ATTIC WINDOWS 3'-3 1/2" x 3'-9" H.
- WINDOW HEAD @ 6'-10" A.F.F.
- ROOF PITCH ± 12/9 1/2

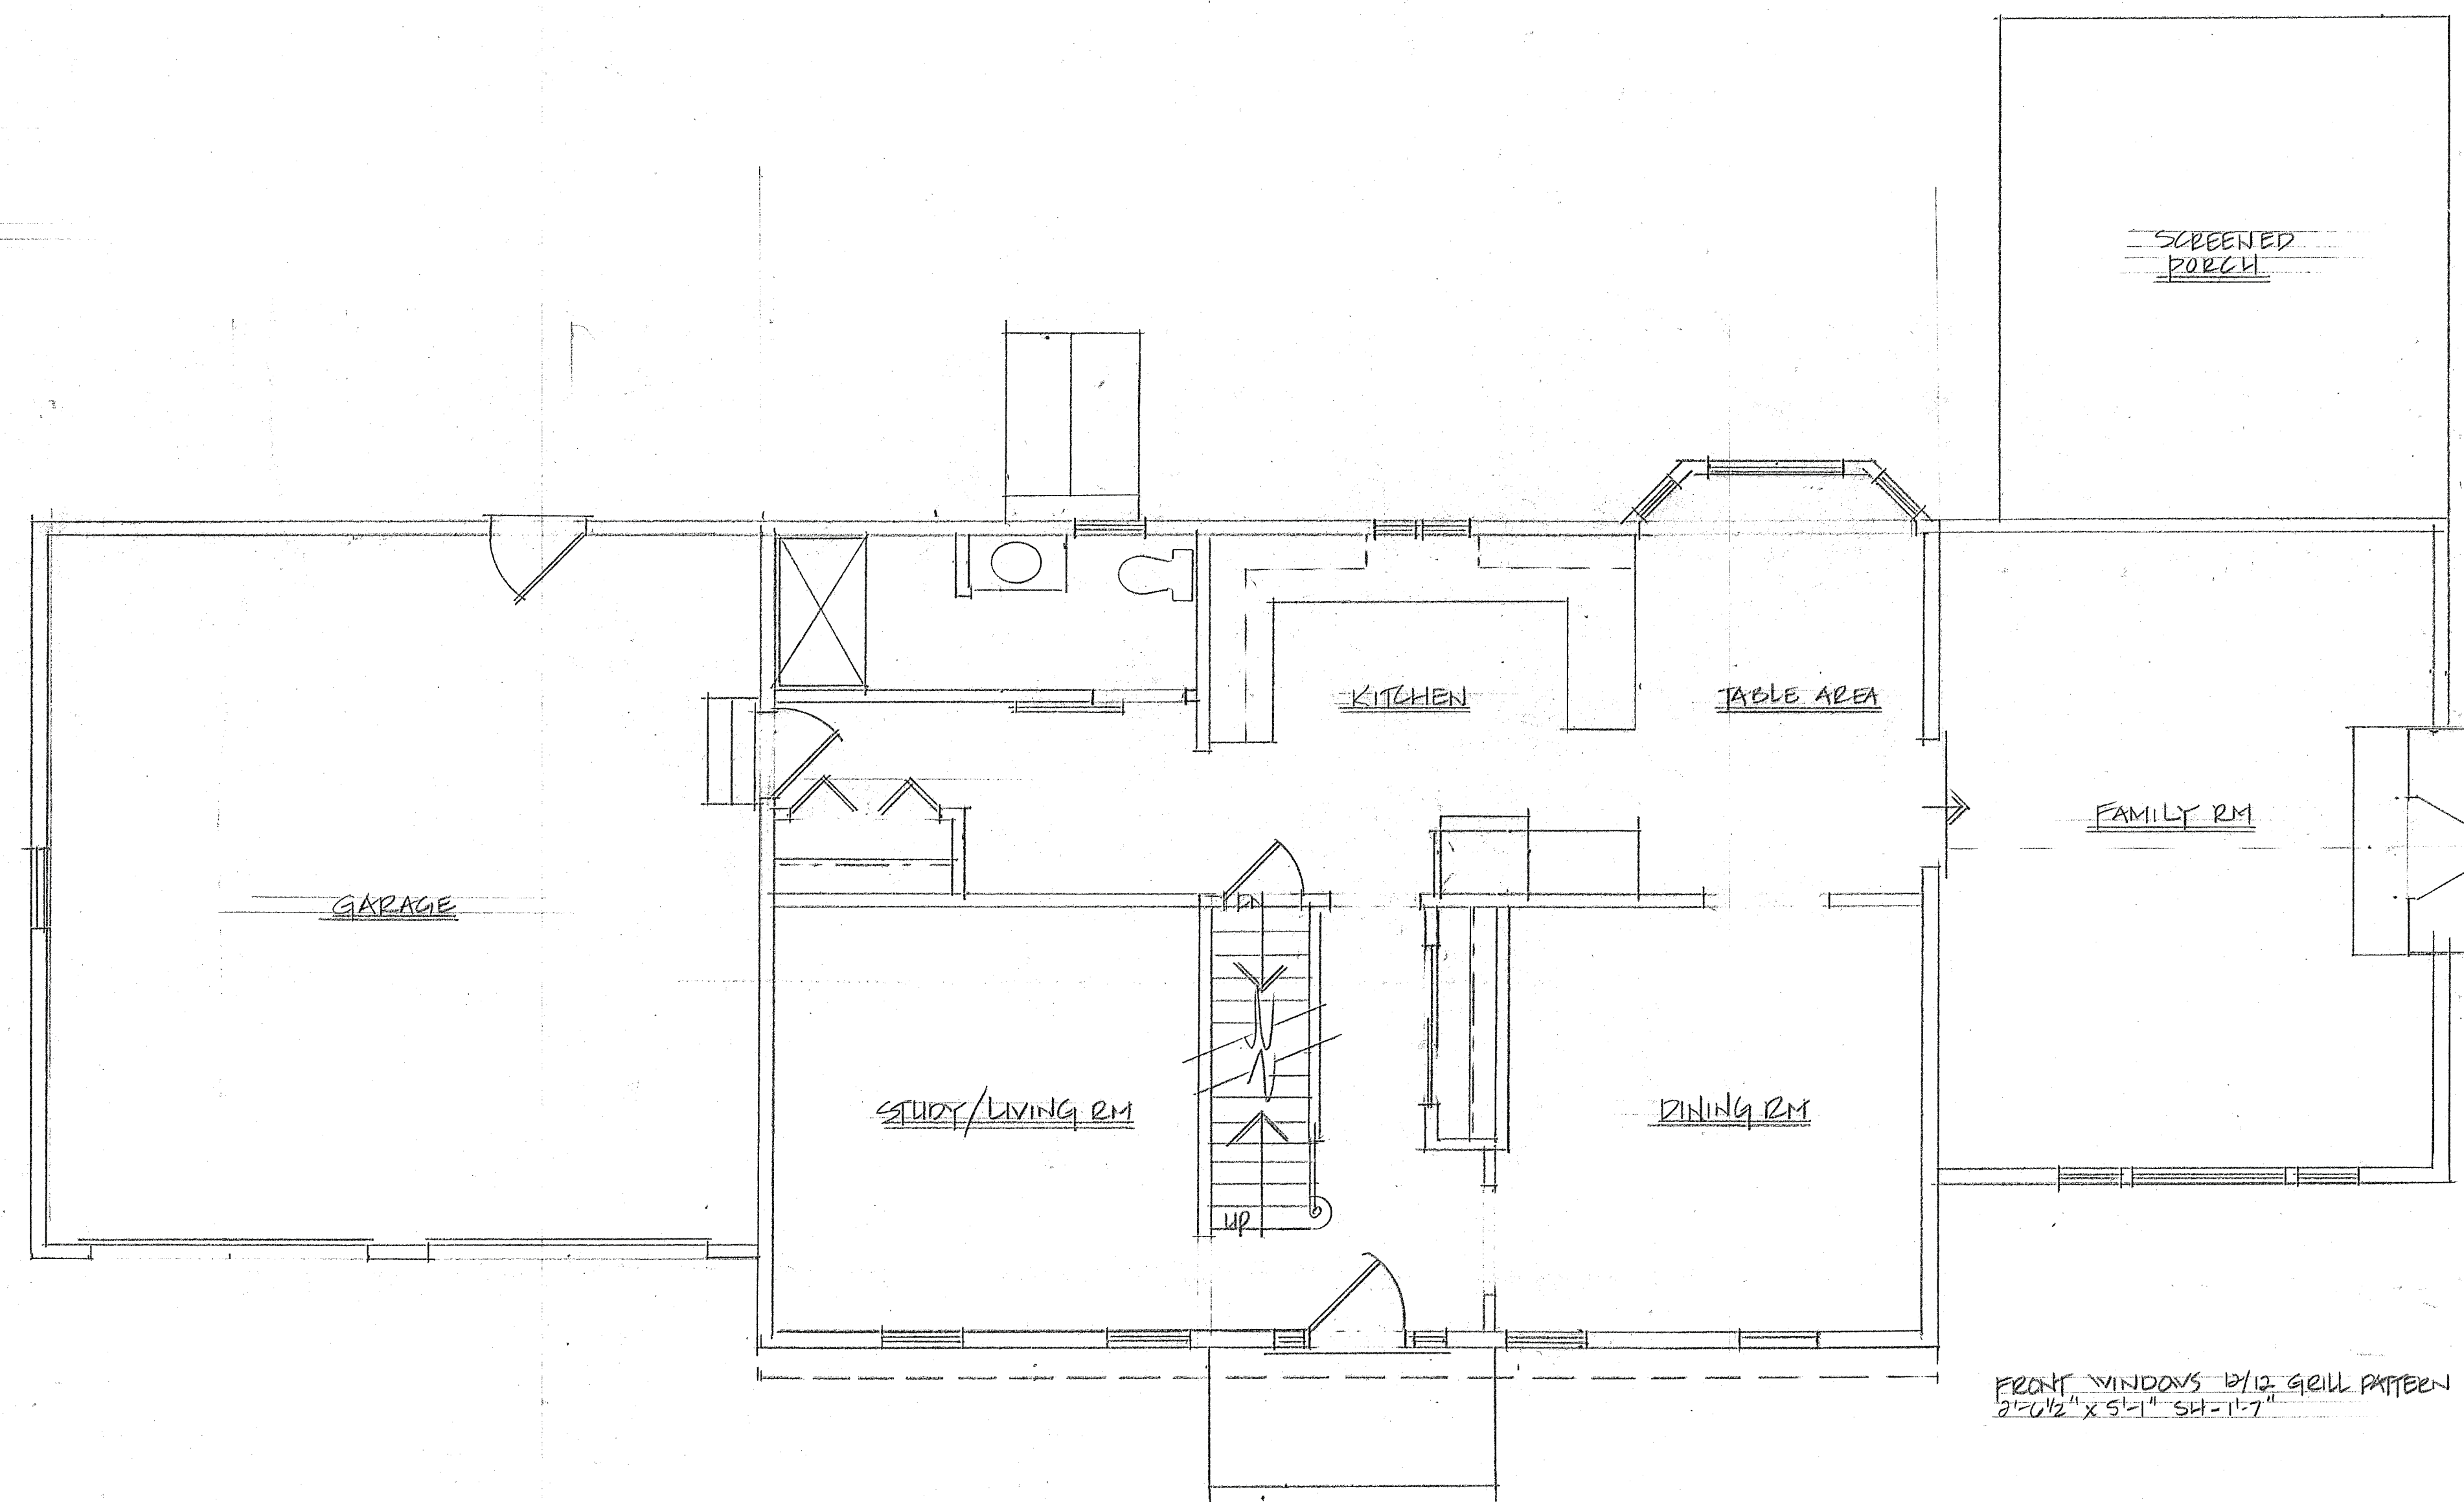

FIRST FLOOR PLAN AS-BUILT

REVISIONS	BY

DZILRA RESIDENCE
7 DOLAN DR., GROTON, MA
FLOOR PLANS AS-BUILT

DRAWN
CHECKED
DATE
SCALE 1/4" = 1'-0"
JOB NO.
SHEET
OF SHEETS



FRONT ELEVATION AS-BUILT