



Basement

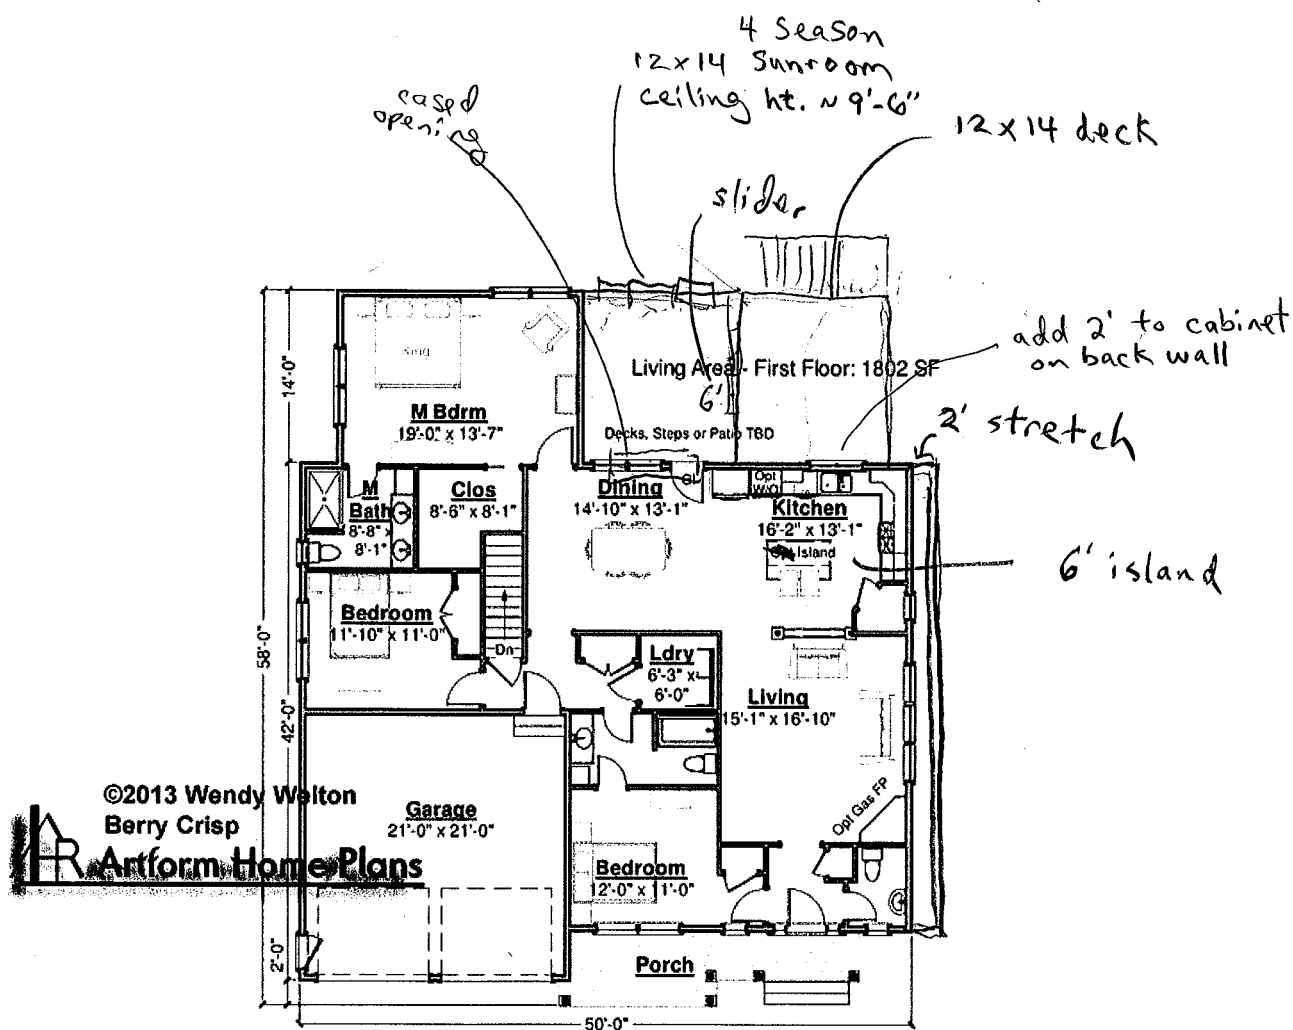

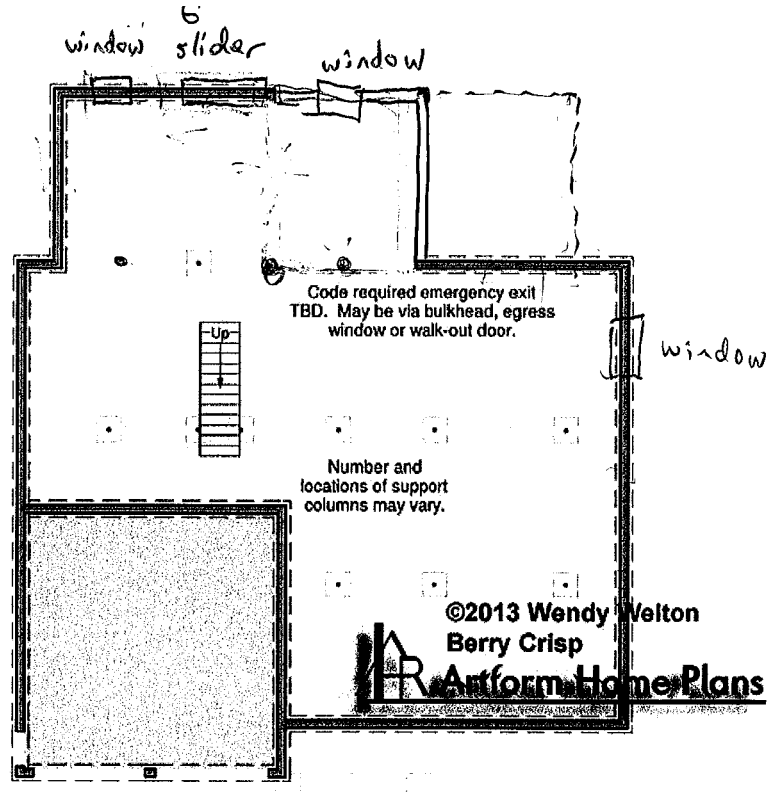

Heights

AFHP Default Grade *1
is 1'-9" below first floor
subfloor for consistency
in how we list height on
the web site. The
distance to grade is
often more. Talk to your
builder.

*3 Height for zoning
may be measured from
the grade at the front,
the lowest grade or an
average. Talk to your
builder and/or governing
officials.

