



959.124.v5 ER
(11/14/2019)

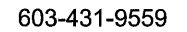

Window Grids - Top only
Slider + Kitchen - No grids
No Walk-out

Scale: 1/8" = 1'-0"

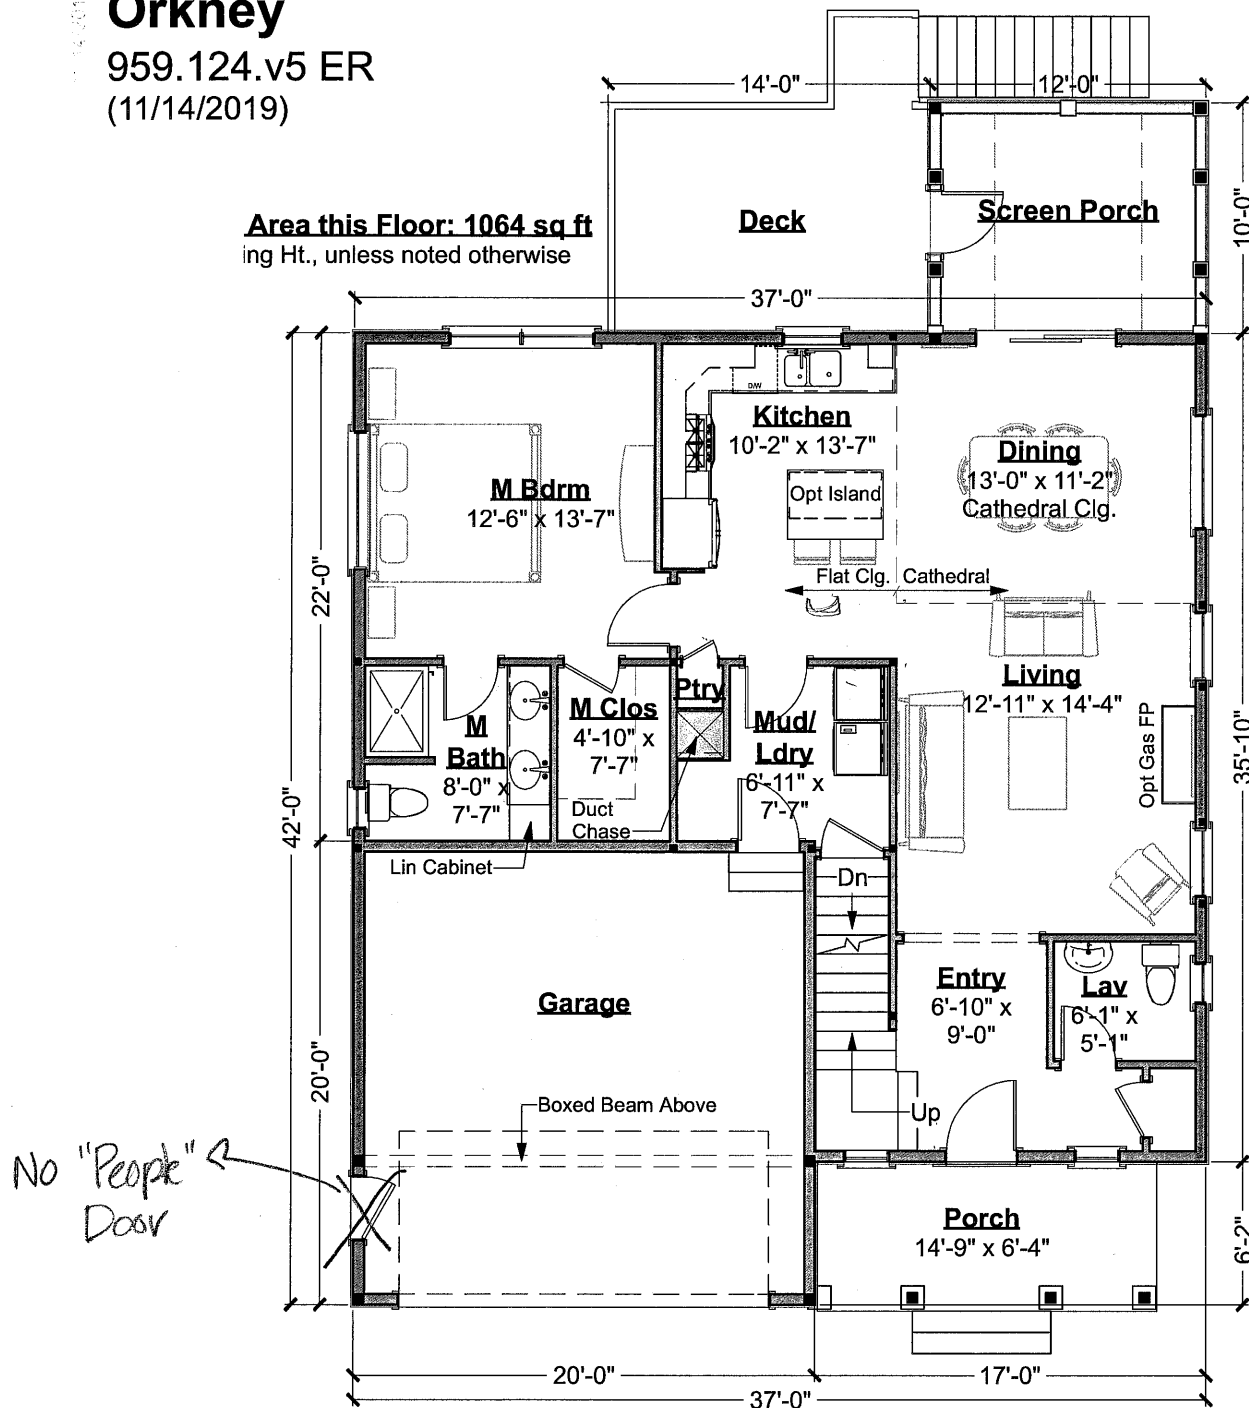

Orkney

959.124.v5 ER


(11/14/2019)



603-431-9559

© 2018-2019 Art Form Architecture, Inc., all rights reserved.
You may not build this design without purchasing a license,
even if you make changes. This design may have
geographic restrictions.

Living Area this Floor: 798 sq ft
8 ft Ceiling Ht

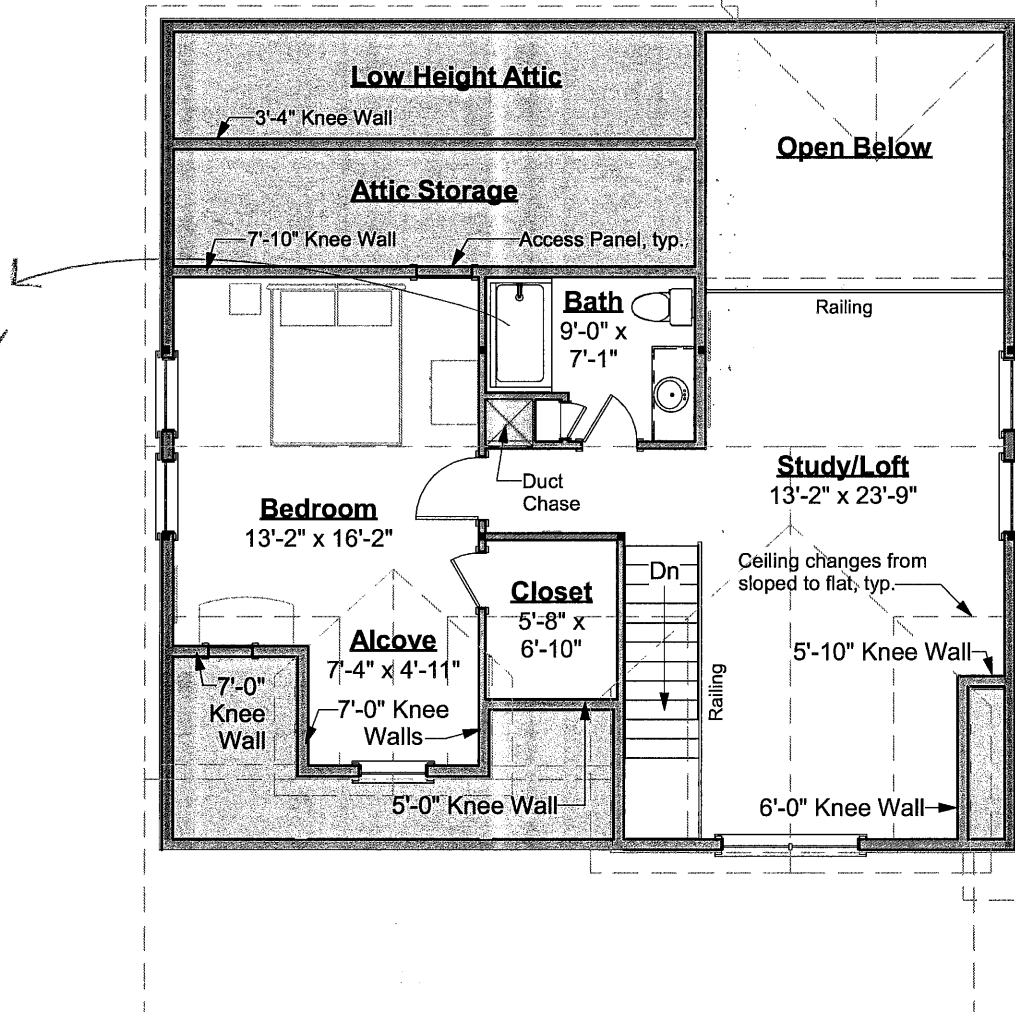

Second Floor Plan

Scale: 1/8" = 1'-0"