



7/11/2019

Orkney
959.124 GR
(7/11/2019)

© 2018 Art Form Architecture, Inc., all rights reserved. You may not build this design without purchasing a license, even if you make changes. This design may have geographic restrictions.

Artform Home Plans

603-431-9559

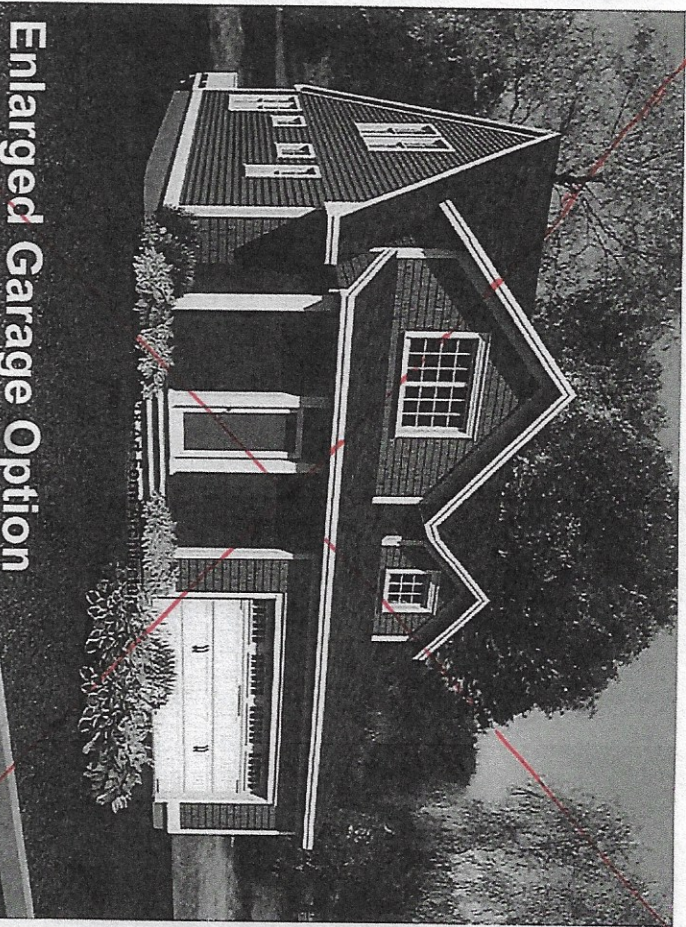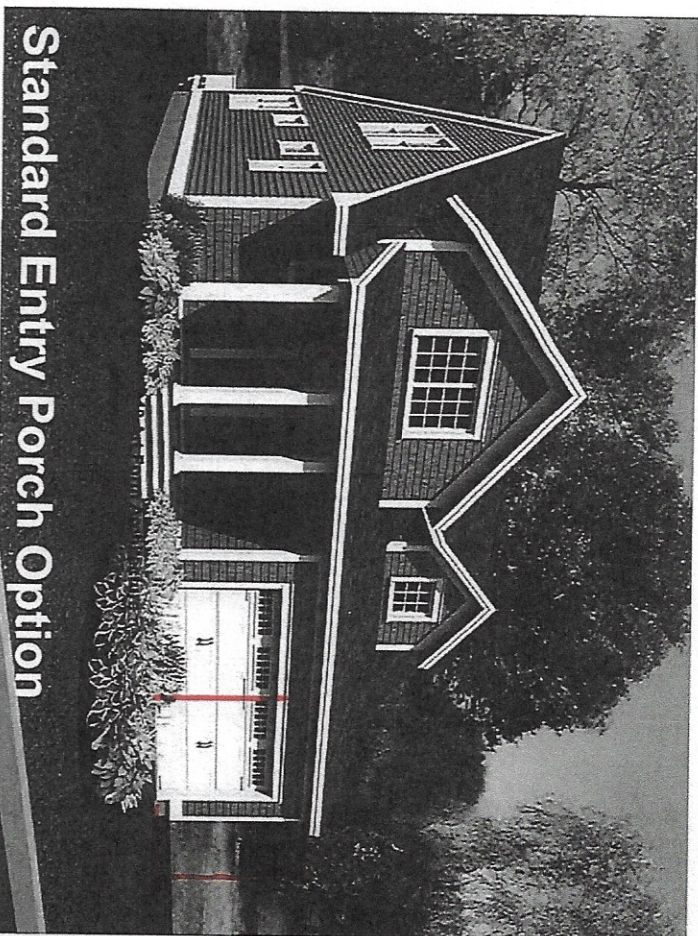

Standard Entry Porch Option

Enlarged Garage Option

2 ft garage expansion w/ 2 garage doors
windows on each side of front door to be
full size double hung windows



05/05/20
11:45 AM EDT
dotloop verified

Orkney

959.124 GR

(7/11/2019)


© 2018 Art Form Architecture, Inc., all rights reserved. You may not build this design without purchasing a license, even if you make changes. This design may have geographic restrictions.

Artform Home Plans


603-431-9559

First Floor Plan - Screen Porch & Deck Option

Scale: 1/8" = 1'-0"

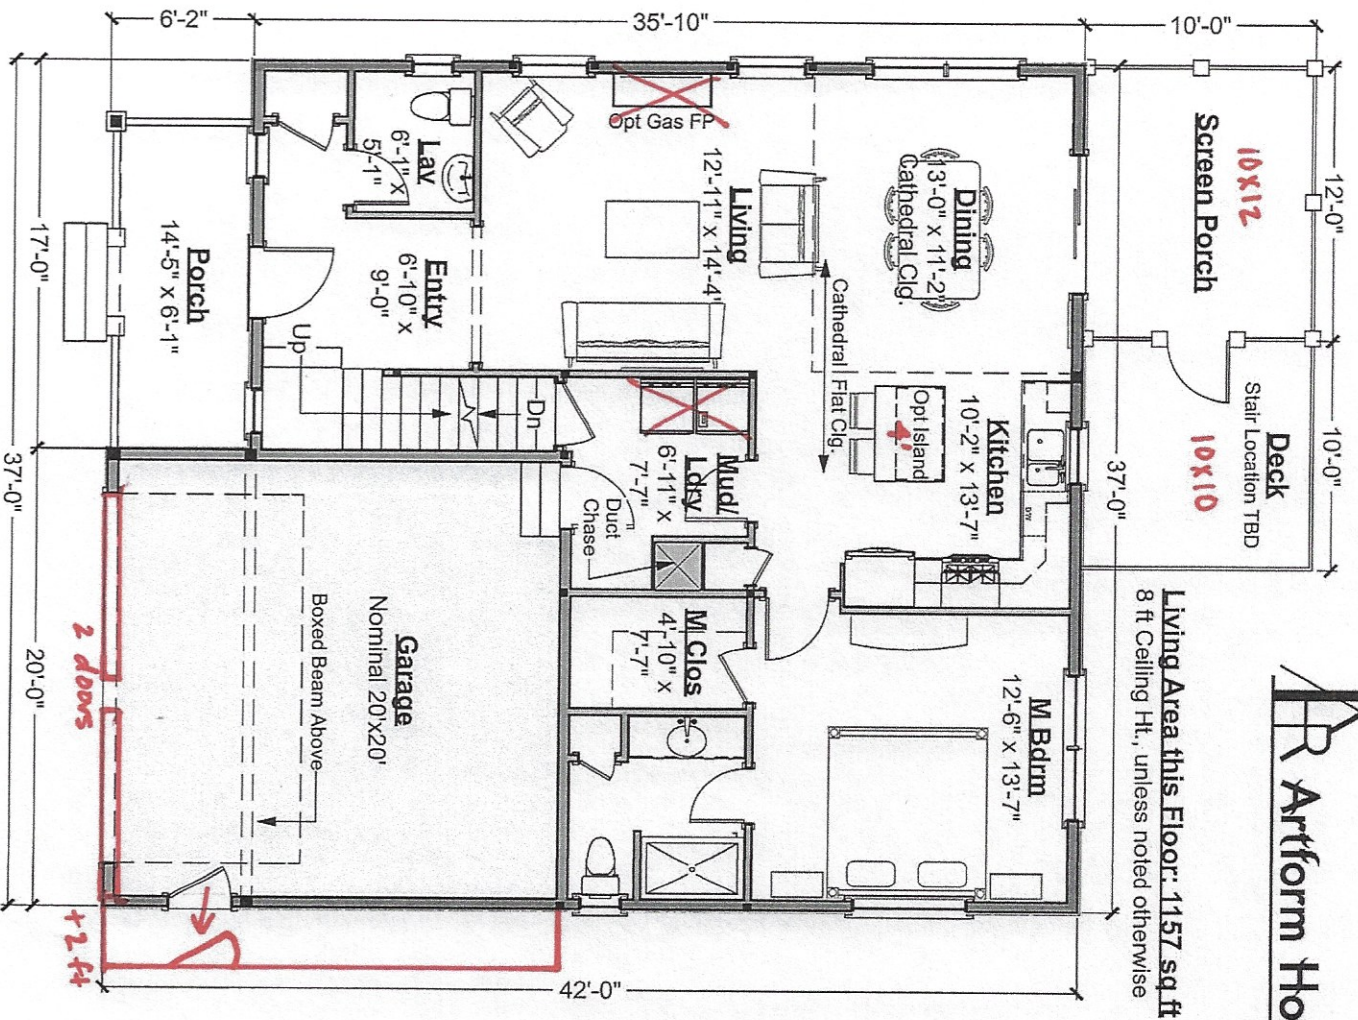

Living Area this Floor: 798 sq ft
8 ft Ceiling Ht.

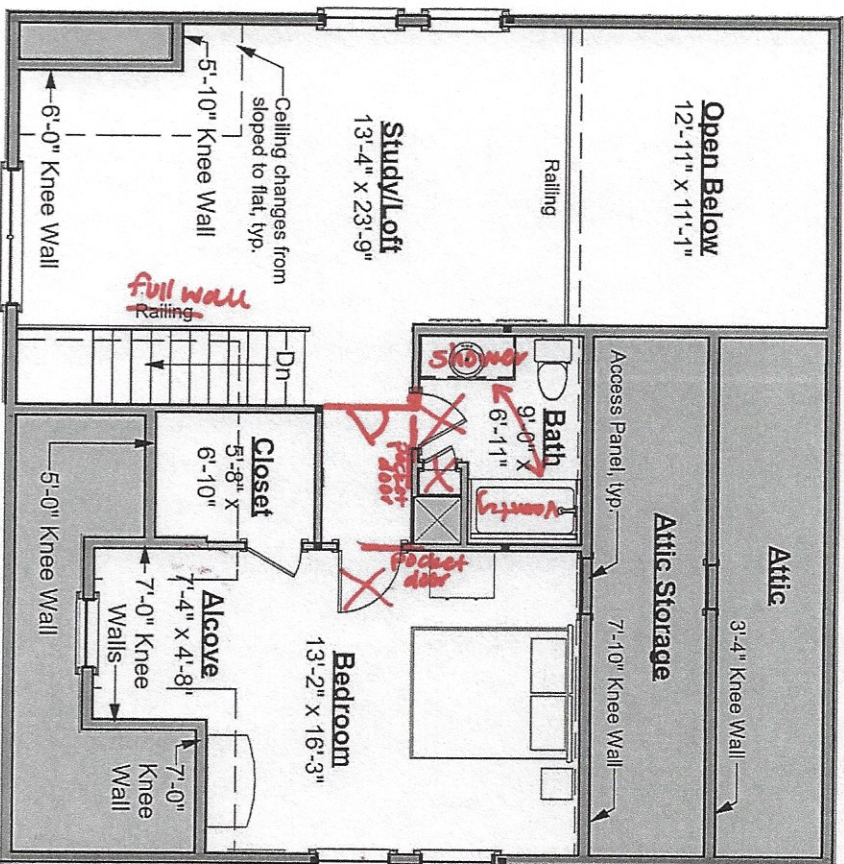

Second Floor Plan
Scale: 1/8" = 1'-0"