

A Calmer Captain

061.001

© 2013 Art Form Architecture, Inc. All Rights Reserved . <http://www.artformhomeplans.com>



First Floor

Living Area: 936 SF


Bedrooms: 0

Bathrooms: 0.5

Ceiling Height Shown: 8'-0"

Ceiling Height Possible*: 9'-0"

* - Increasing ceiling height requires a Major Change.

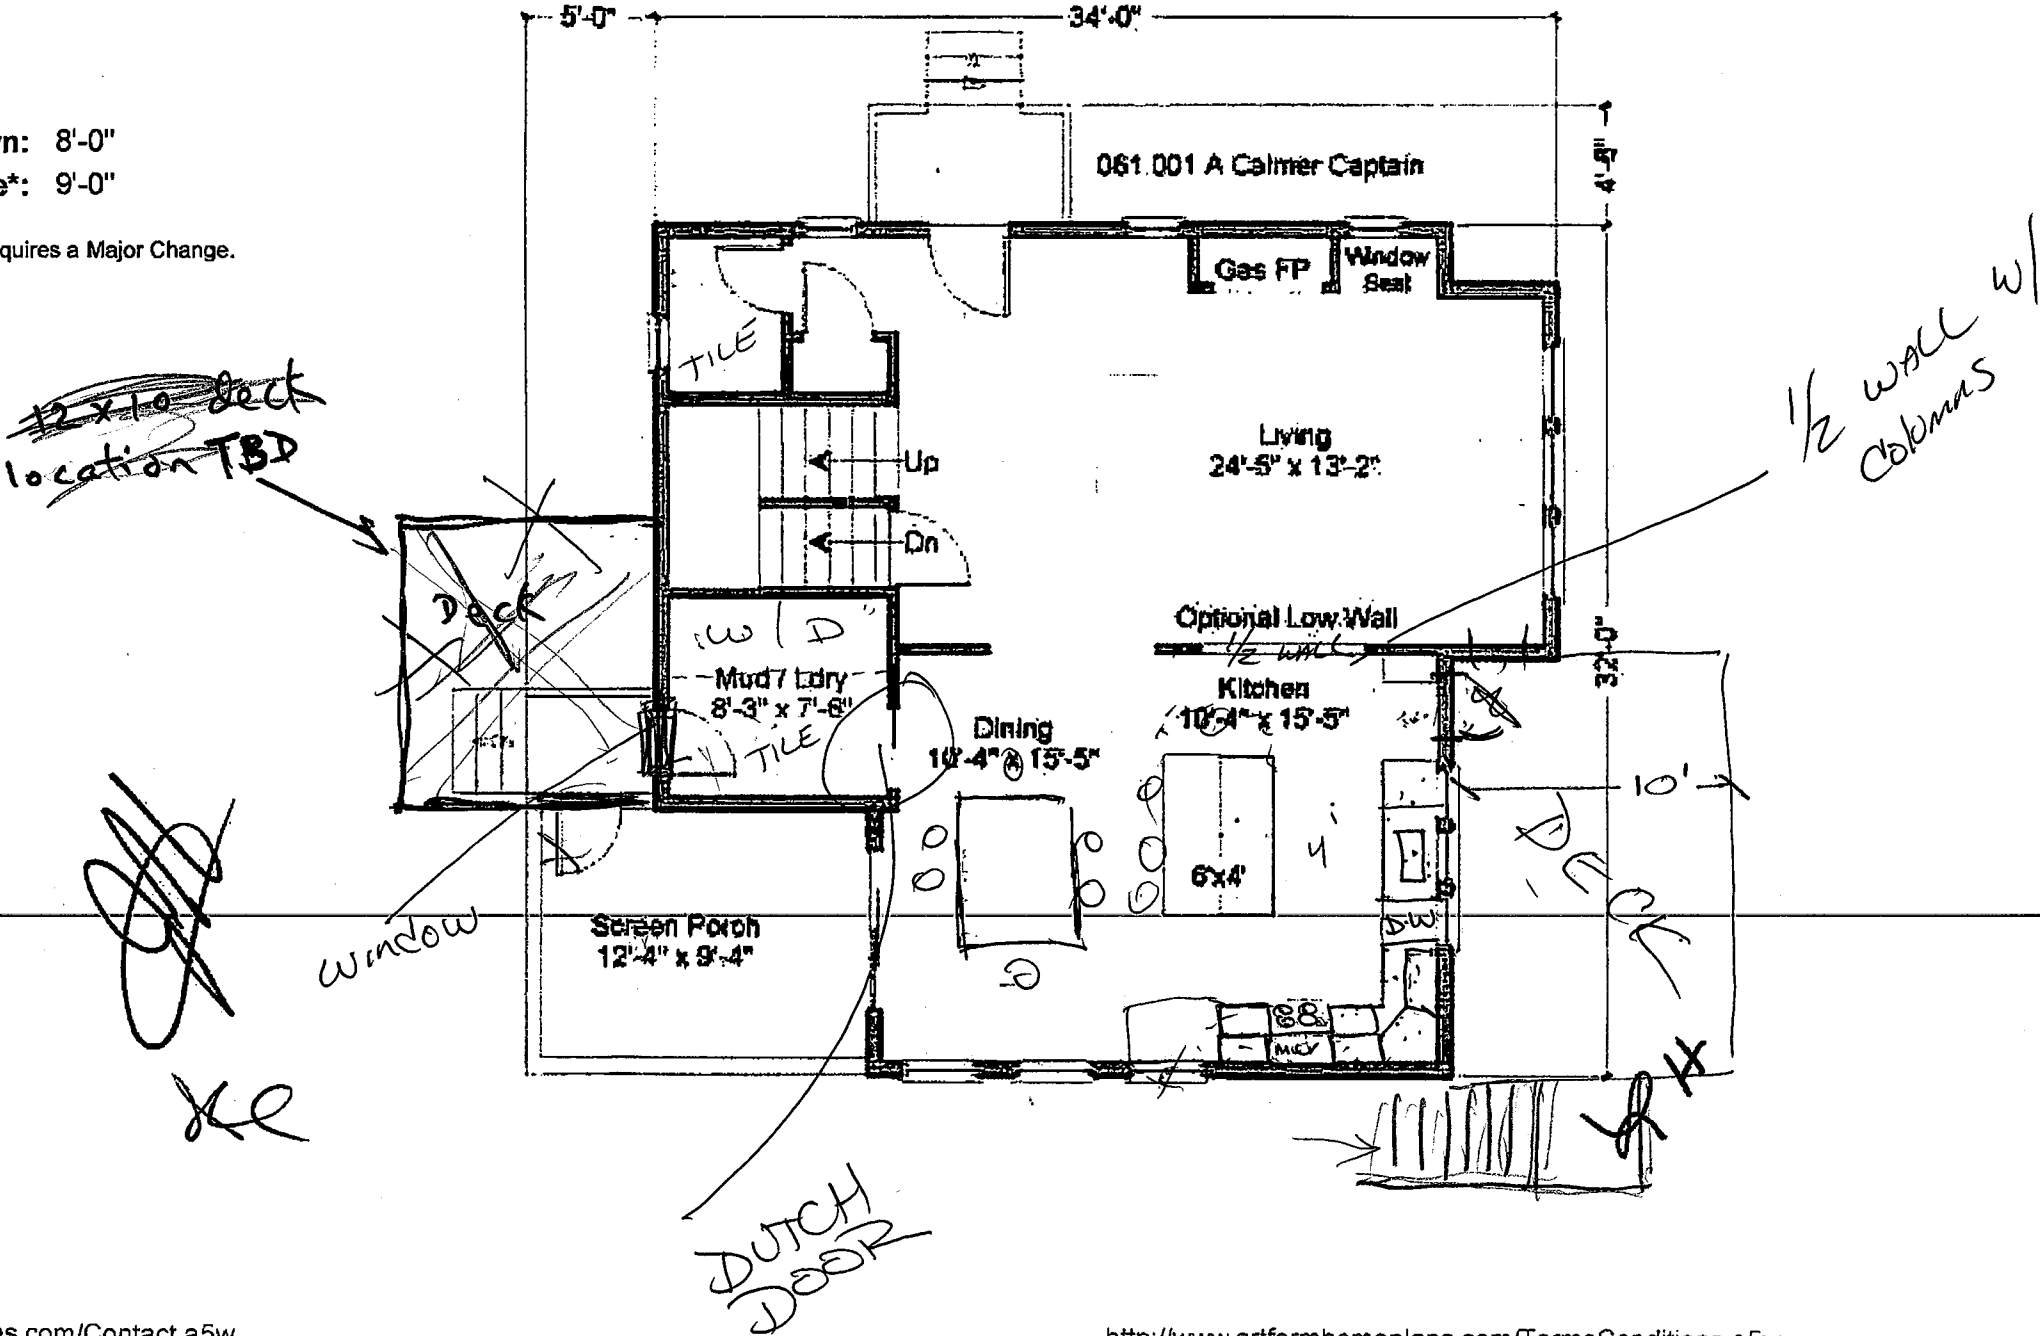

A Calmer Captain

061.001

© 2013 Art Form Architecture, Inc. All Rights Reserved . <http://www.artformhomeplans.com>



Second Floor

Living Area: 870 SF

Bedrooms: 3

Bathrooms: 2.0

Ceiling Height Shown: 8'-0"

Ceiling Height Possible*: 8'-0"

* – Increasing ceiling height requires a Major Change.

