



Opal Bronze with ~~Sun~~

362.005

© 2008-2011 Wendy Walton, all rights reserved

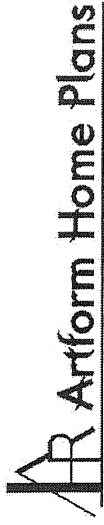

First Floor

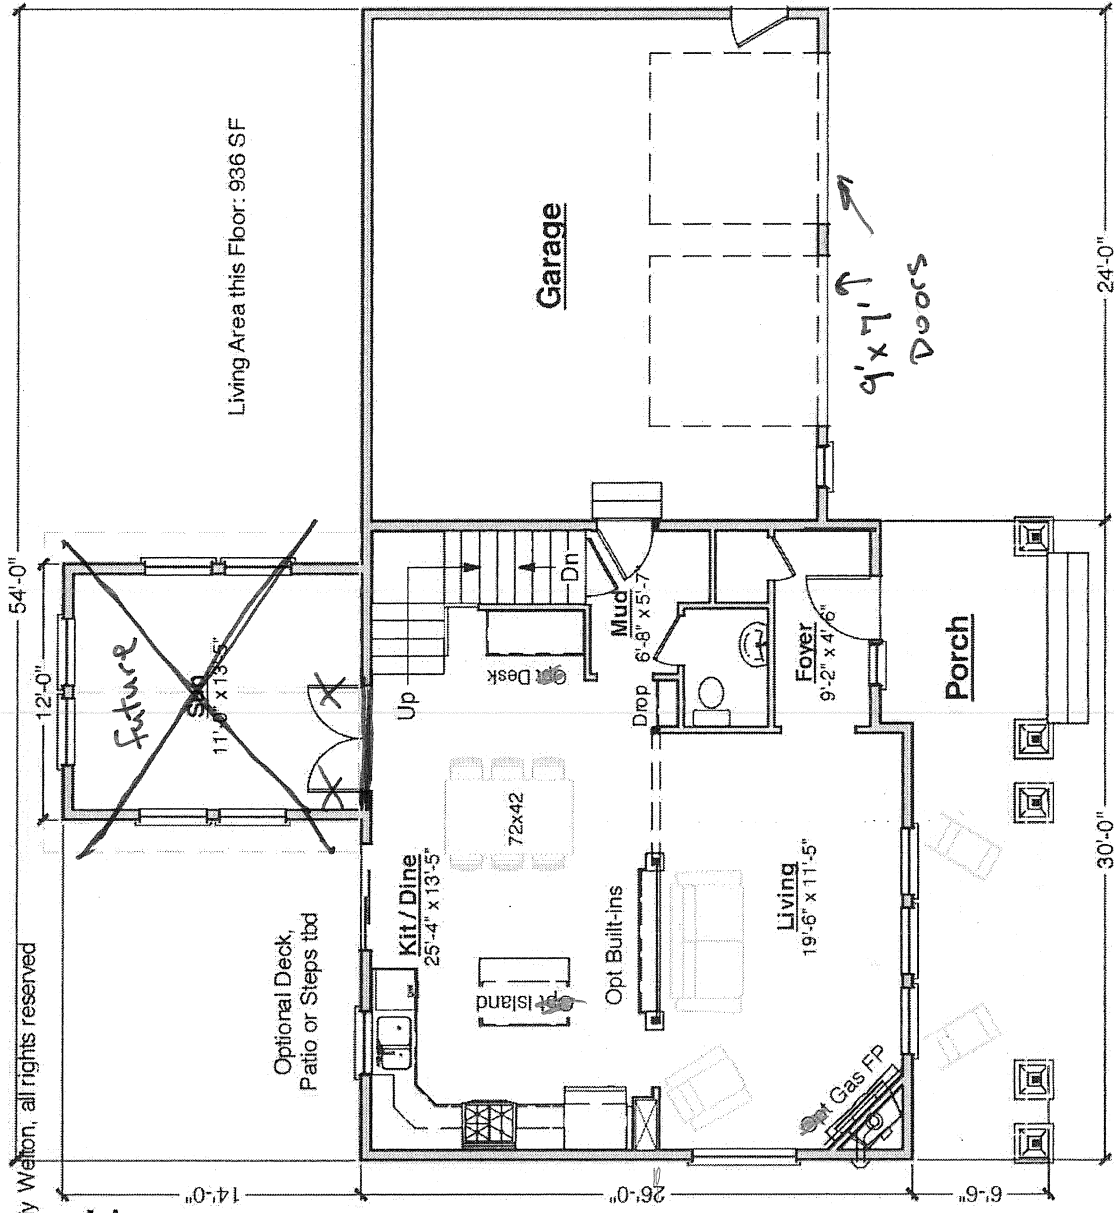

KC
JF
JF


Mirror image

Opal Bronze with Sun

362.005

© 2008-2011 Wendy Welton, all rights reserved


Second Floor

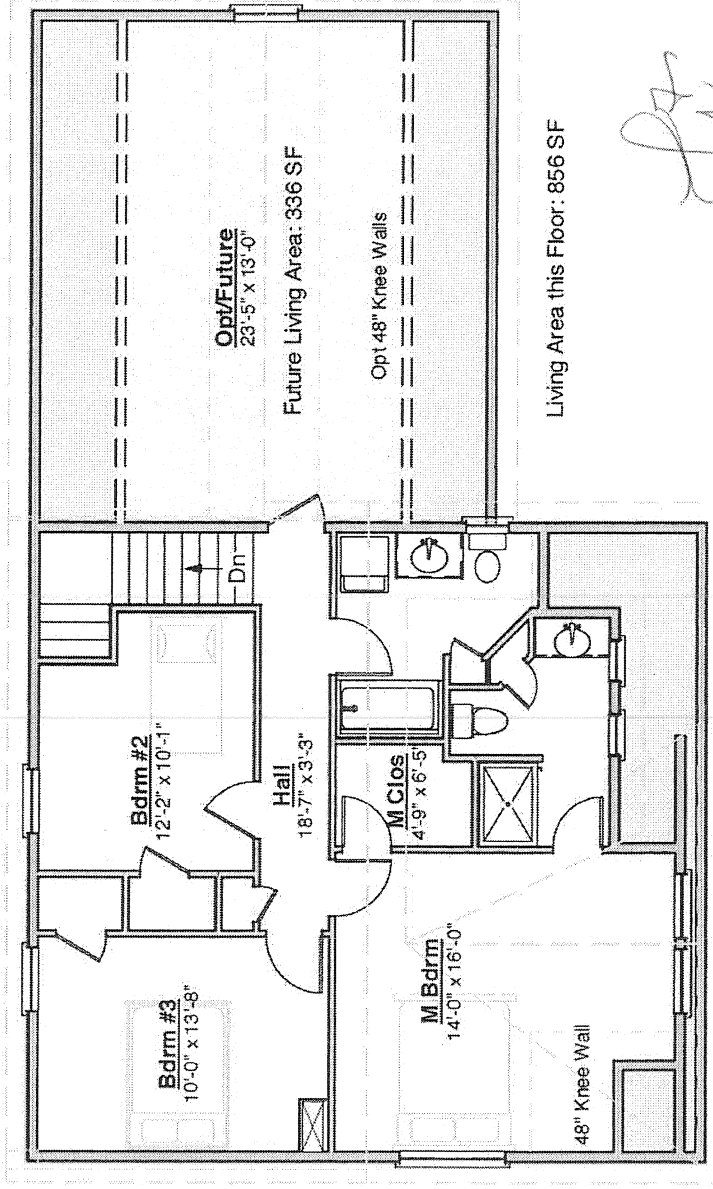

Opal Bronze with Sun


362.005

© 2008-2011 Wendy Welton, all rights reserved

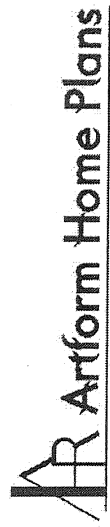

Lower Level

2' drop

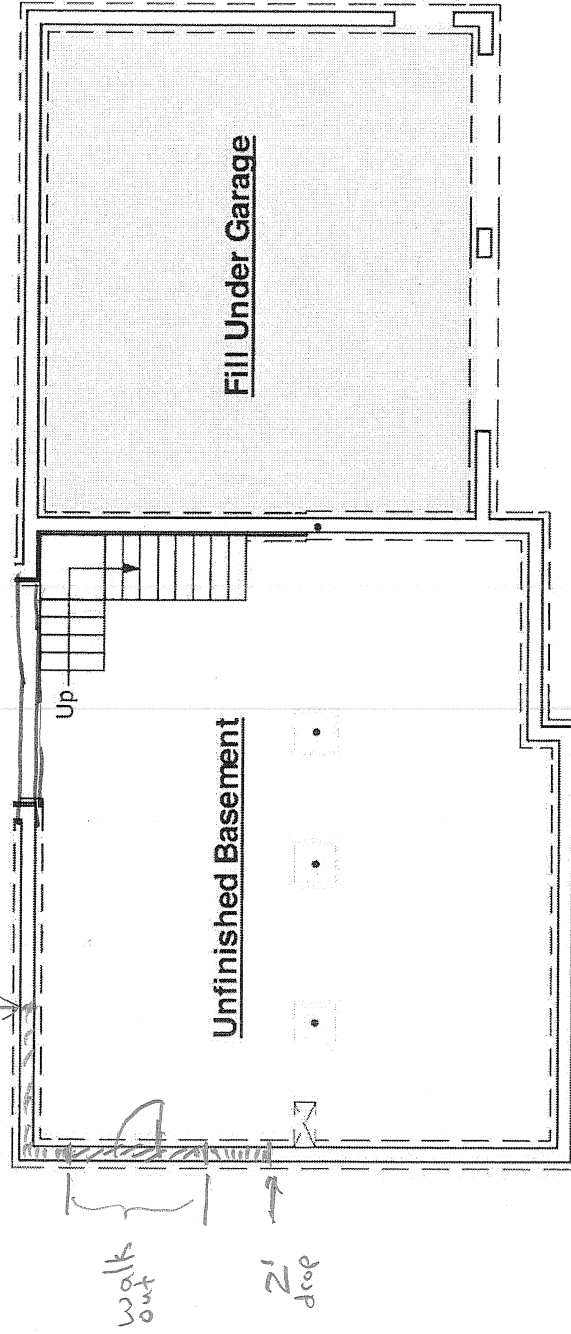

KCC

W. Welton

Opal Bronze with ~~Sun~~

362.005

© 2008-2011 Wendy Welton, all rights reserved

Artform Home Plans

Some items shown are optional and/or may vary. Builder's written specifications always govern.

1. Gas fireplace and it's surround or mantel
2. Kitchen - island, cabinet style & trim, countertop material, etc.
3. Door styles and trim
4. Window grilles and trim, window treatments
5. Stair balusters or low walls at stairs
6. Lighting
7. Material selections (flooring, siding, roofing, paint colors, etc.)
8. Other furnishings
9. Landscaping, paving and walkways
10. Gutters, shutters and other exterior trim components
11. Deck - size, railing style, stair location, etc.
12. Amount of exposed basement and/or wood framed walls at basement.

These images are not of any specific building site. Sun and view through windows will vary, as will the site around the house on the exterior and the slope of the land.

