
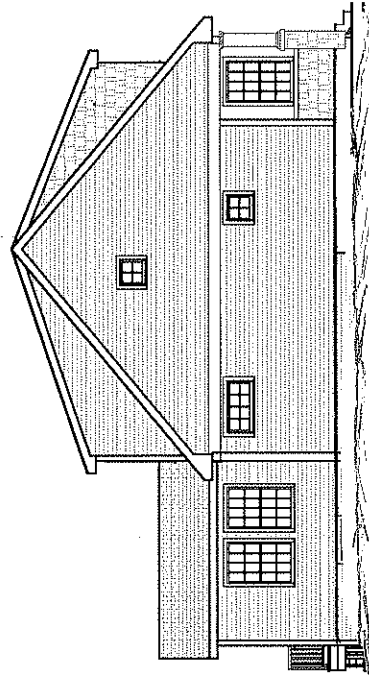
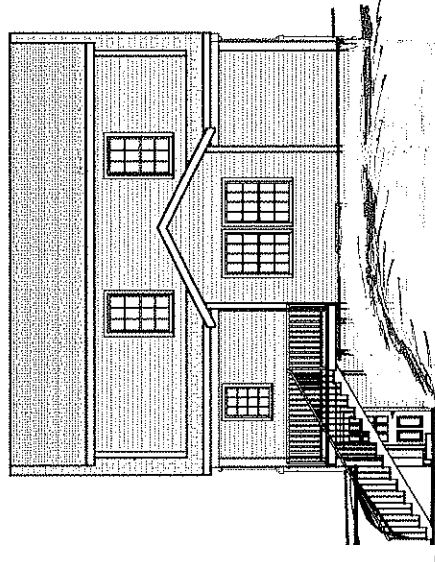
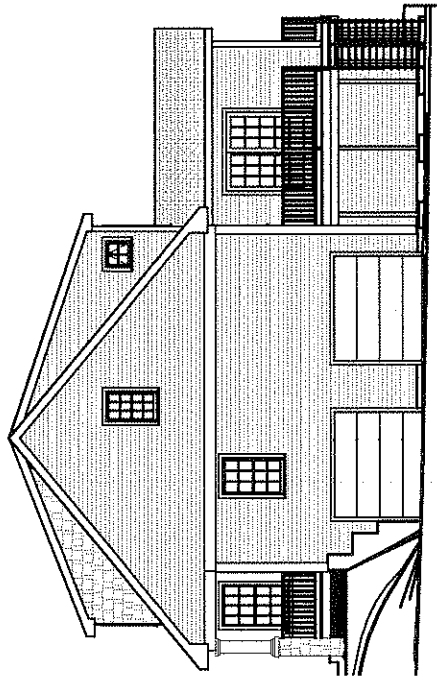


Calla Bungalow

190.007-R

© 2006-2012 Wendy, all rights reserved. You may not build this design without purchasing a license, even with changes. Some Artform designs have geographic restrictions. Contact the Builder or RE Agent at 603-431-9559

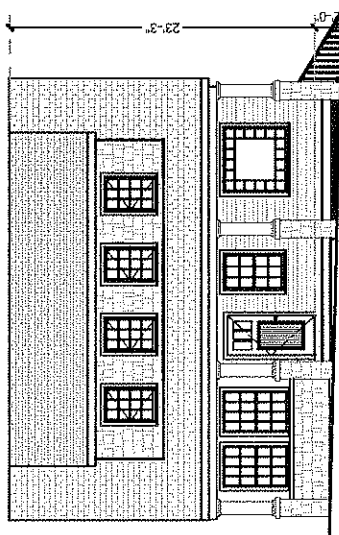

Final Grading to be determined on site.

XC

Builder's written specifications

always govern. Some items shown are optional or may vary, including but not limited to:


- Gas fireplace and surround
- Kitchen - island, cabinet style & trim, counter material, etc.
- Bath - vanity size, number / style of sinks, tub or shower...
- Other built-ins.
- Door styles and trim
- Window grilles and trim, window treatments
- Stair balusters or low walls at stairs
- Lighting
- Material selections (flooring, siding, roofing, paint colors...)
- Landscaping, paving and walkways
- Gutters, shutters and other exterior trim components
- Deck - size, railing style, stair location, etc.
- Amount of exposed basement and/or wood framed walls at basement.

These images are not of any specific building site. Sun and view through windows will vary, as will the site surrounding the house and the slope of the land.


Calla Bungalow

190.007-R


© 2006-2012 Wendy, all rights reserved. You may not build this design without purchasing a license, even with changes. Some Artform designs have geographic restrictions. Contact the Builder or RE Agent or call Artform at 603-431-9559

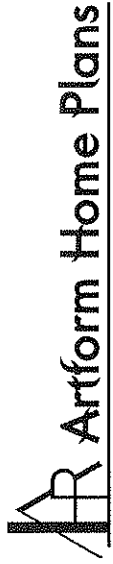

First Floor

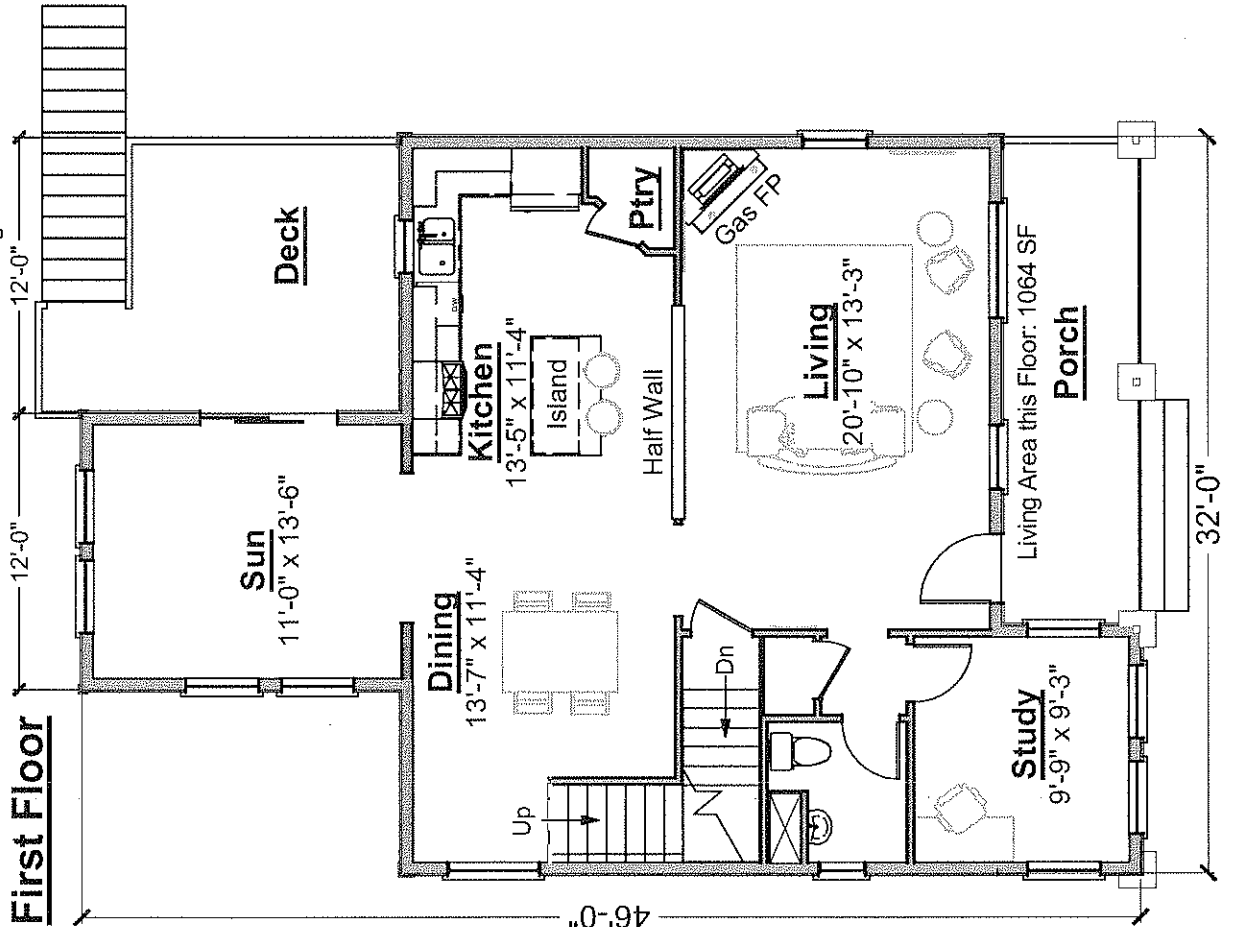

Second Floor

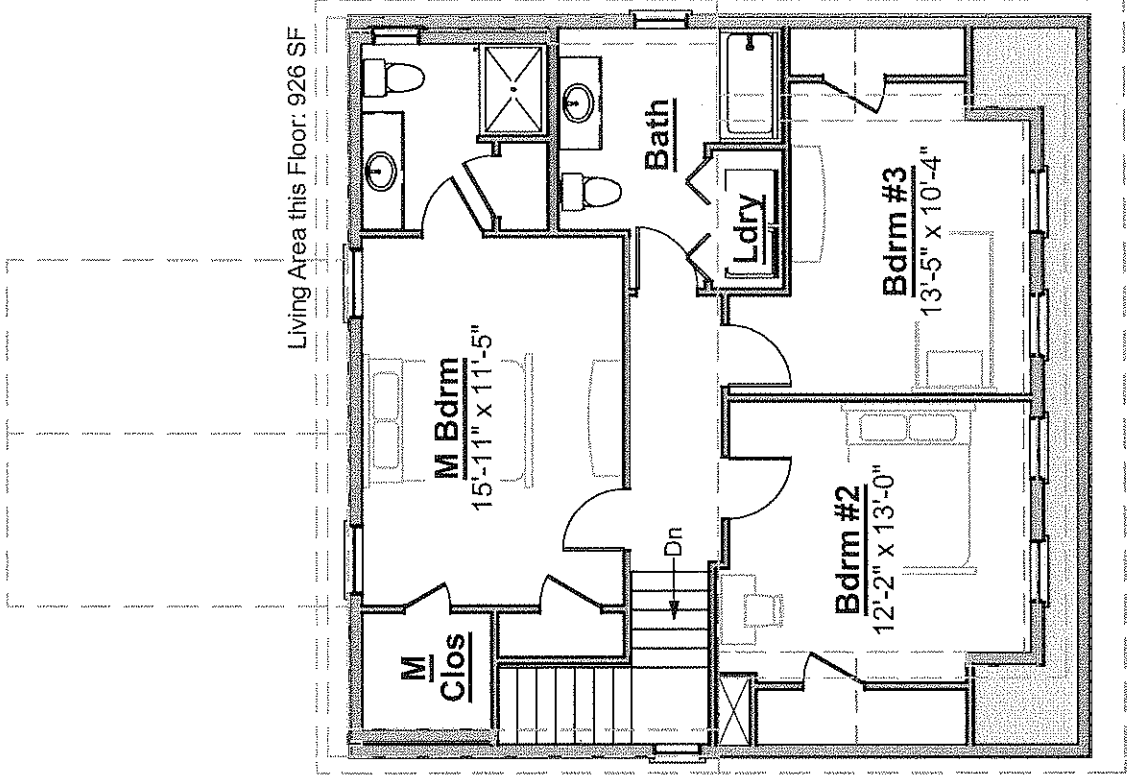


XC


Calla Bungalow

190.007-R

© 2006-2012 Wendy, all rights reserved. You may not build this design without purchasing a license, even with changes. Some Artform designs have geographic restrictions. Contact the Builder or RE Agent or call Artform at 603-431-9559

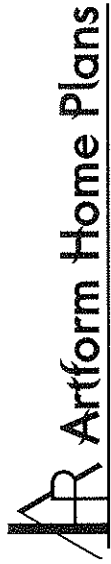

Lower Level

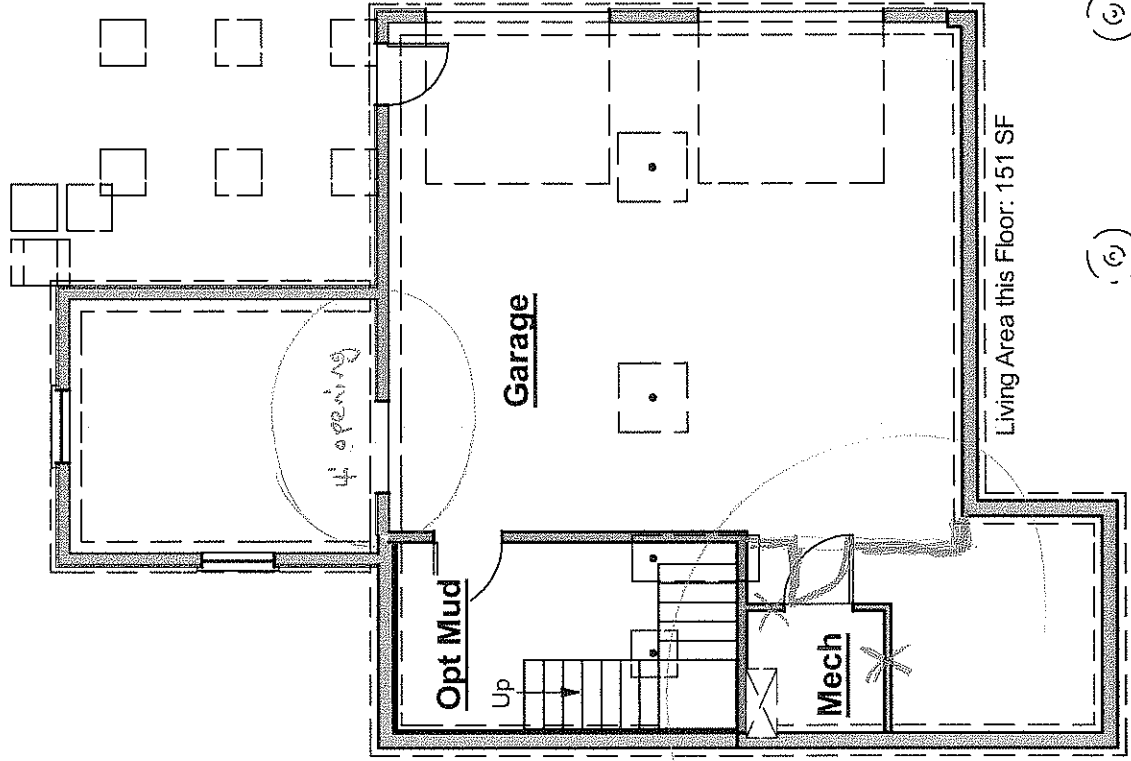

(c) (c)

AC