


Basement Floor Plan

Artform Home Plans

© 2008-2011 Wendy Welton
256.001 Harbor Rose

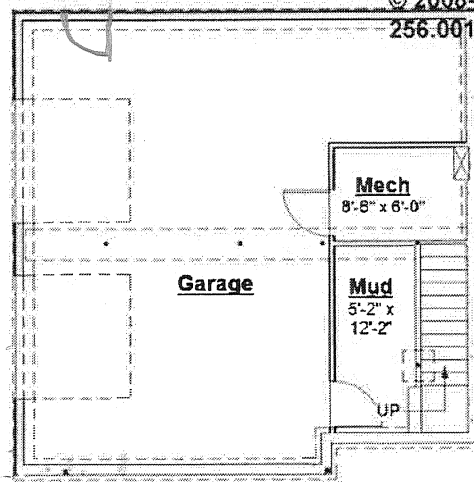

mirror image

Elevations




XC
LR

[Terms of Use](#) | [Privacy Policy](#) | [Pay Invoice](#) | [About Us](#) | [Contact Us](#) | [Sitemap](#)


© 2007 - 2012 Art Form Architecture, Inc. All Rights Reserved.

Web design by Artform Home Plans and Steele Marketing Services and AlphaBase Solutions, LLC on a framework by AlphaToGo.

First Floor Plan

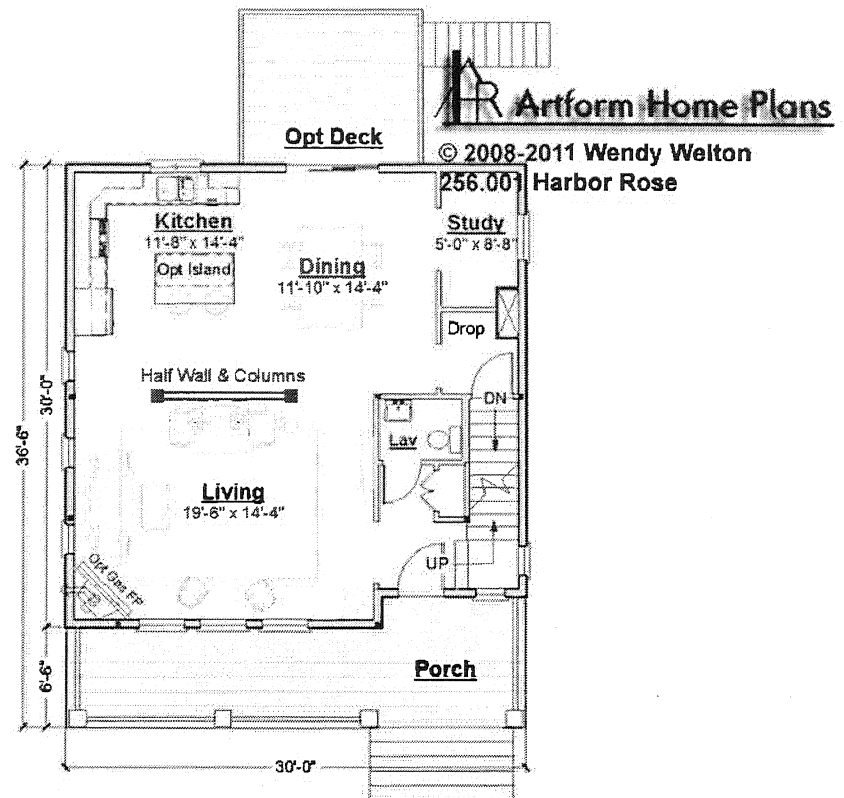

Second Floor Plan

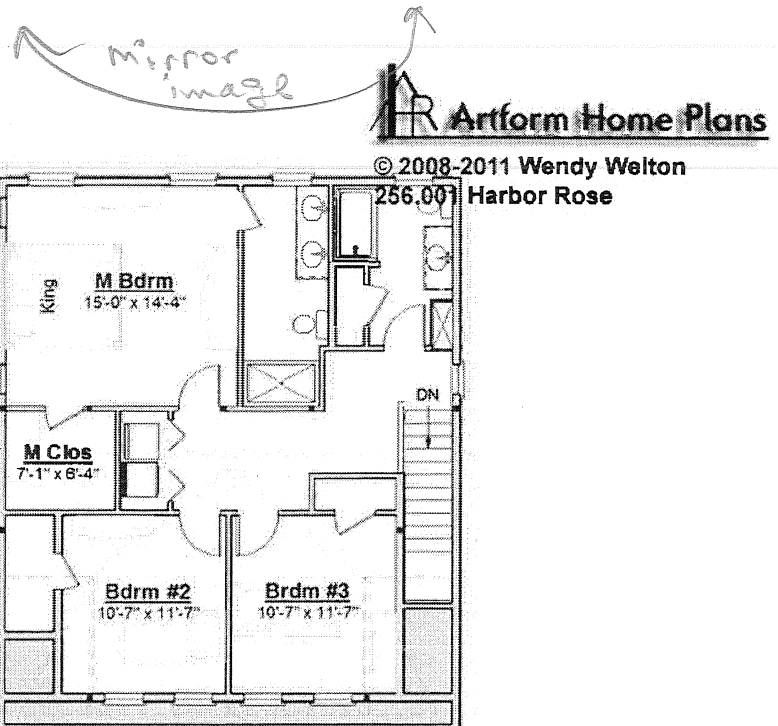

XC YH