



Opal Bronze

362.003

© 2008-2011 Wendy Welton, all rights reserved

Artform Home Plans

Some items shown are optional and/or may vary. Builder's written specifications always govern.

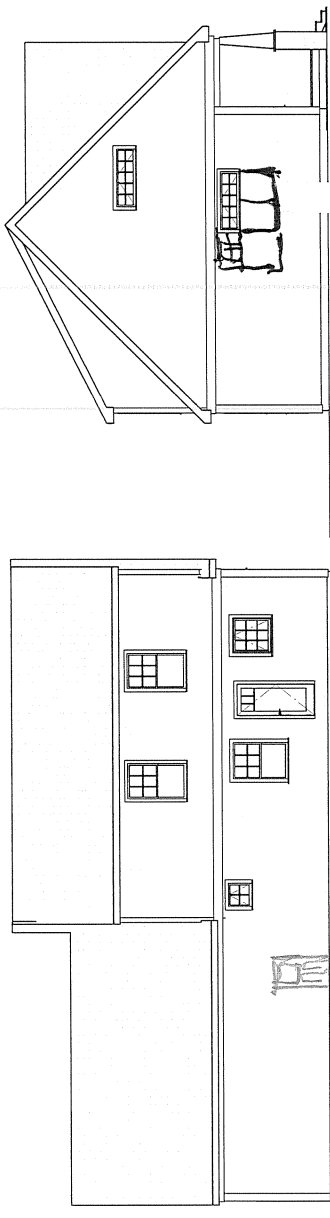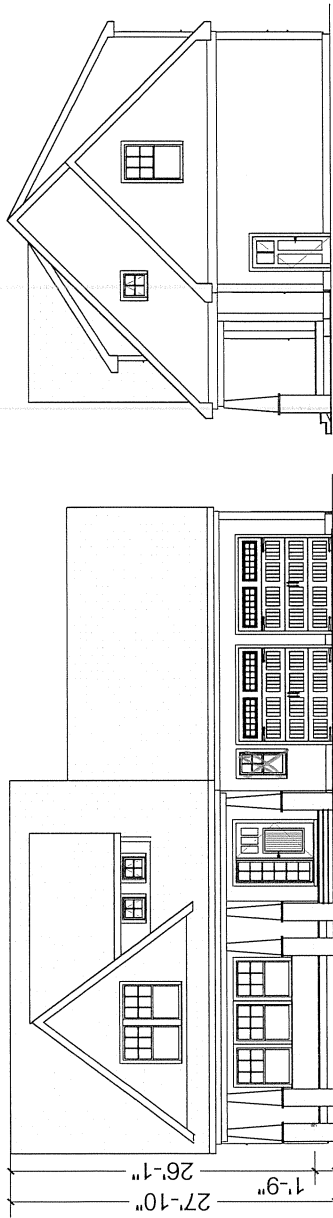

- ~~1.~~ Gas fireplace and it's surround or mantel
- ~~2.~~ Kitchen - island, cabinet style & trim, countertop material, etc.
- 3. Door styles and trim
- 4. Window grilles and trim, window treatments
- 5. Stair balusters or low walls at stairs
- 6. Lighting
- 7. Material selections (flooring, siding, roofing, paint colors, etc.)
- 8. Other furnishings
- 9. Landscaping, paving and walkways
- 10. Gutters, shutters and other exterior trim components
- 11. Deck - size, railing style, stair location, etc.
- 12. Amount of exposed basement and/or wood framed walls at basement.

These images are not of any specific building site. Sun and view through windows will vary, as will the site around the house on the exterior and the slope of the land.

same window treatment as in the front.

x KLC x KV
x ~~AD~~


Opal Bronze

362.003
© 2008-2011 W

First Floor

large slider windows
(12x12 porch (unfinished))

extra door
1' for rear door

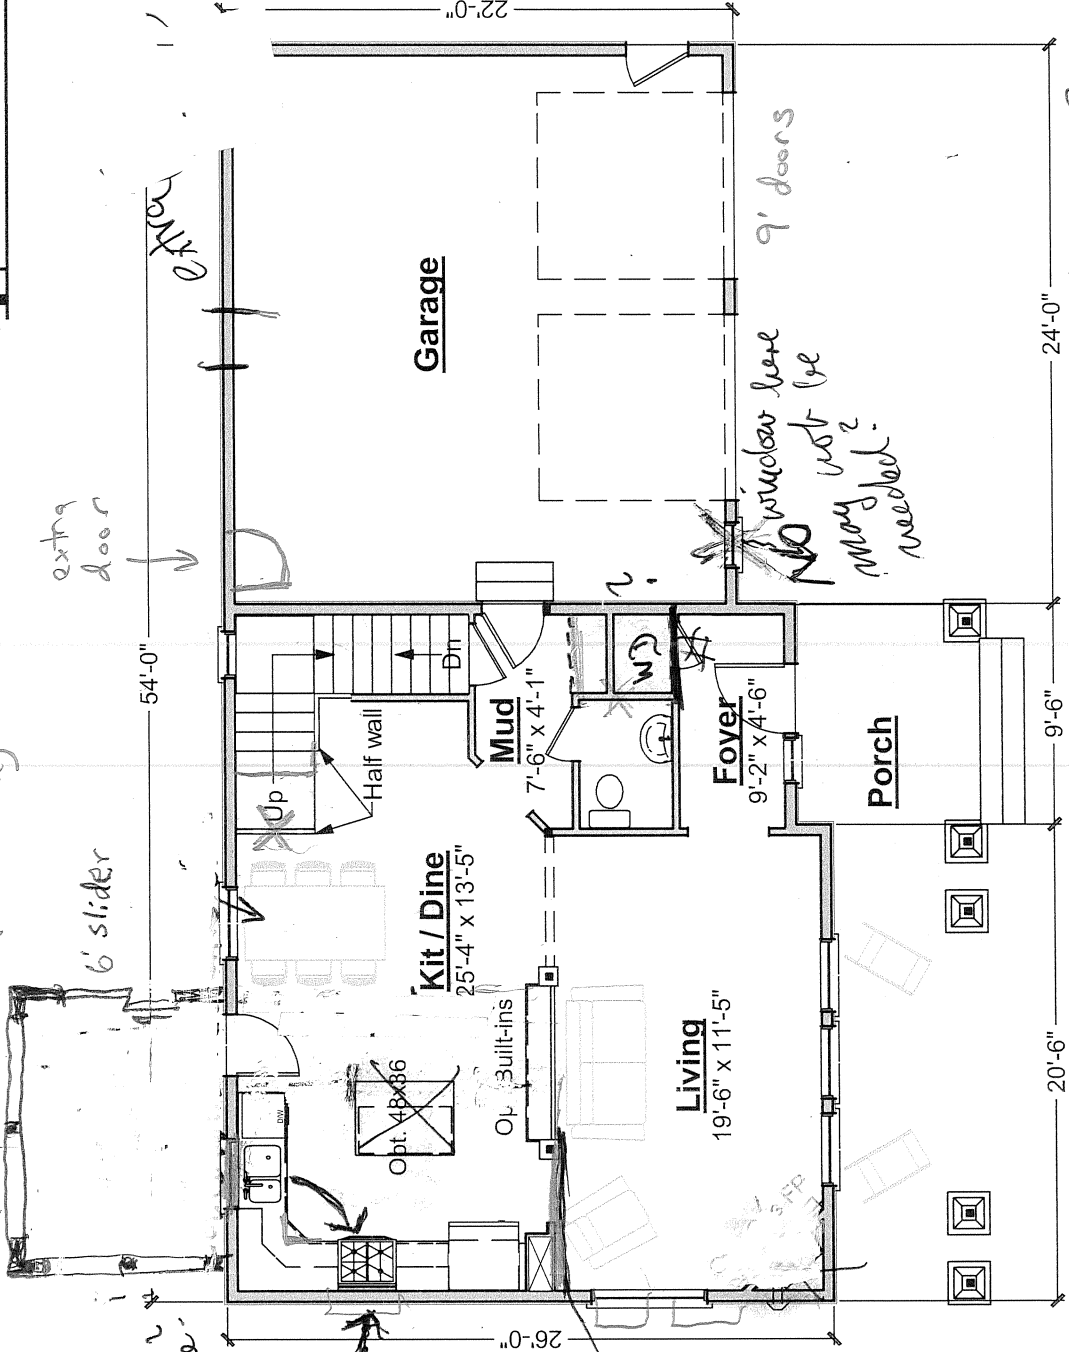

Window here?
Slide & Stair
No open wall
Space will be
eng. work

x AC
x AP
x KL

Wall & 5' archway possible?
Buffet measure 62"


Opal Bronze

362.003

© 2008-2011 Wendy Welton, all rights reserved



Second Floor

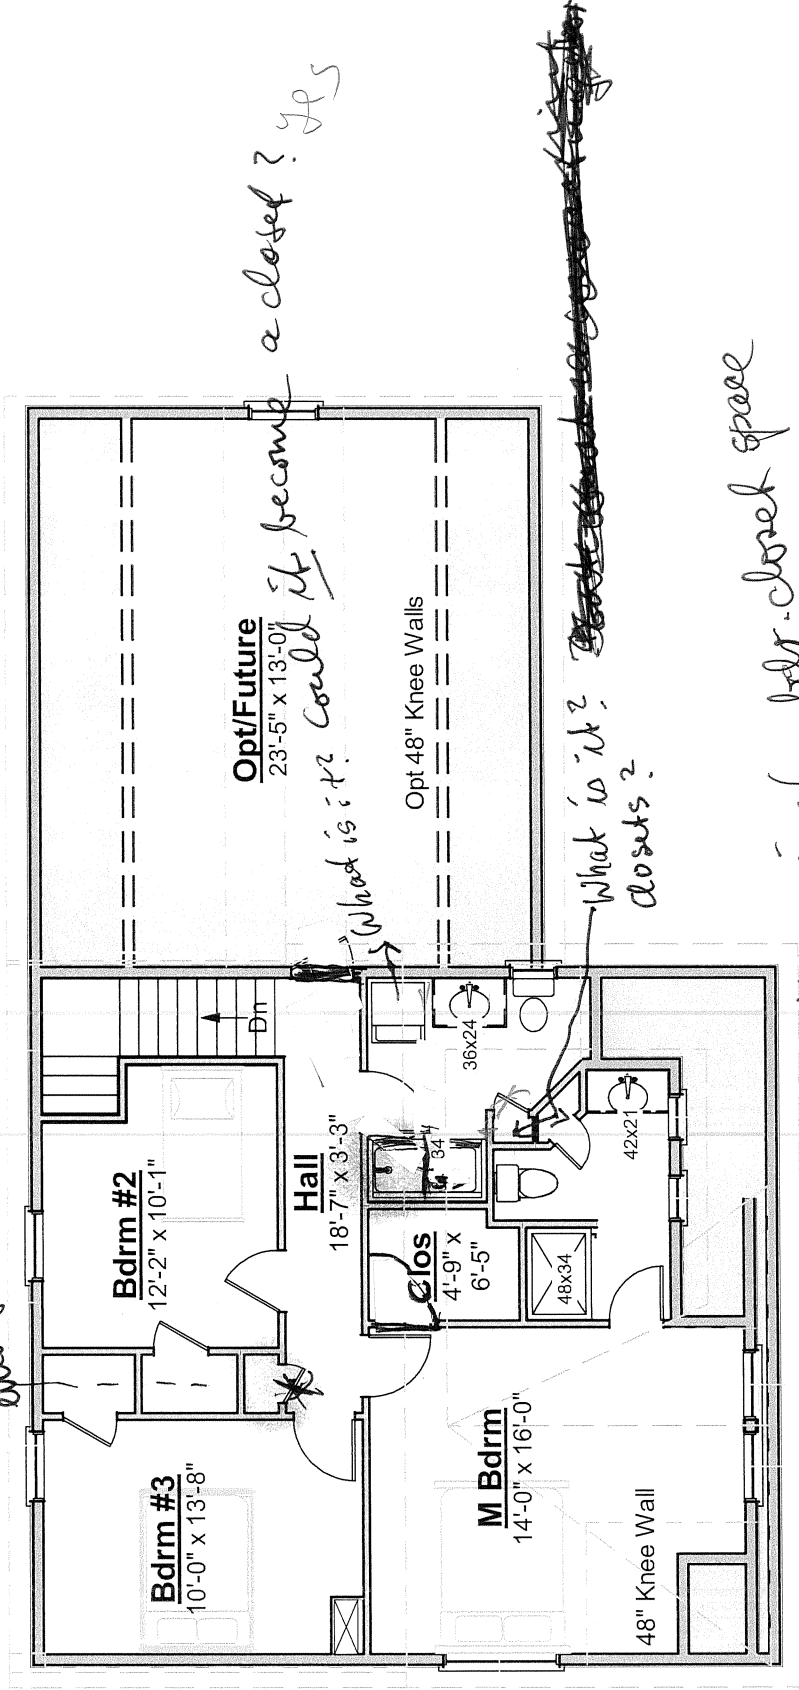


Opal Bronze

362.003

© 2008-2011 Wendy Welton, all rights reserved



Lower Level

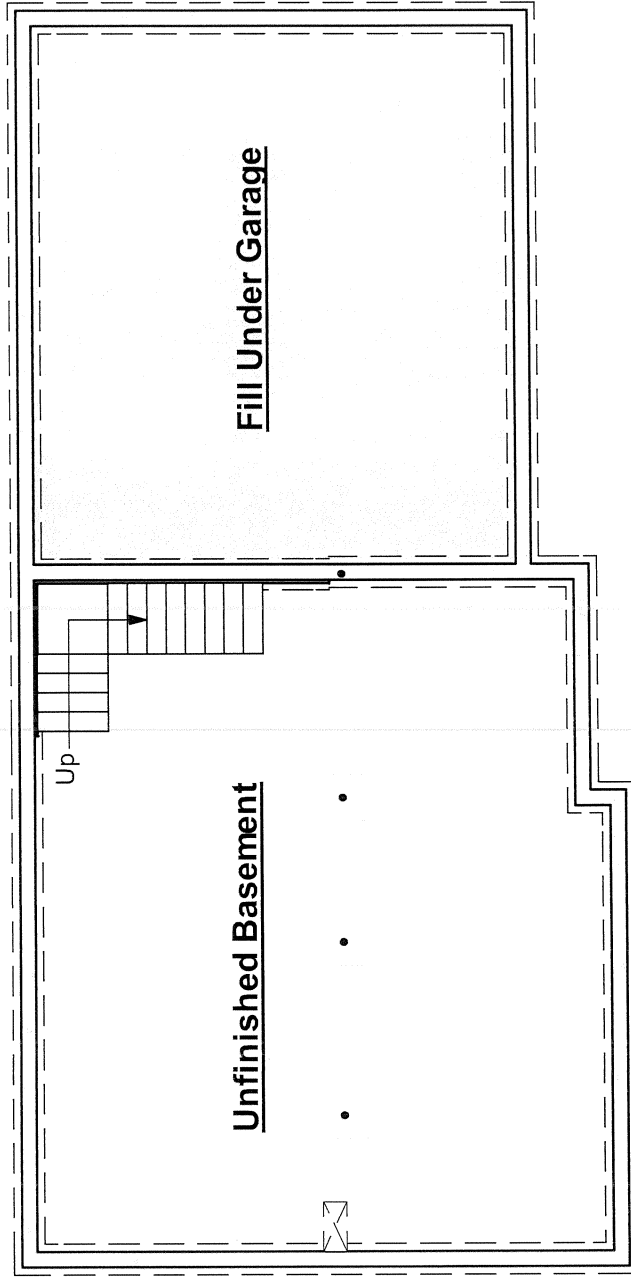

• • • • •

x MC
+ ~~KL~~
+ KL