


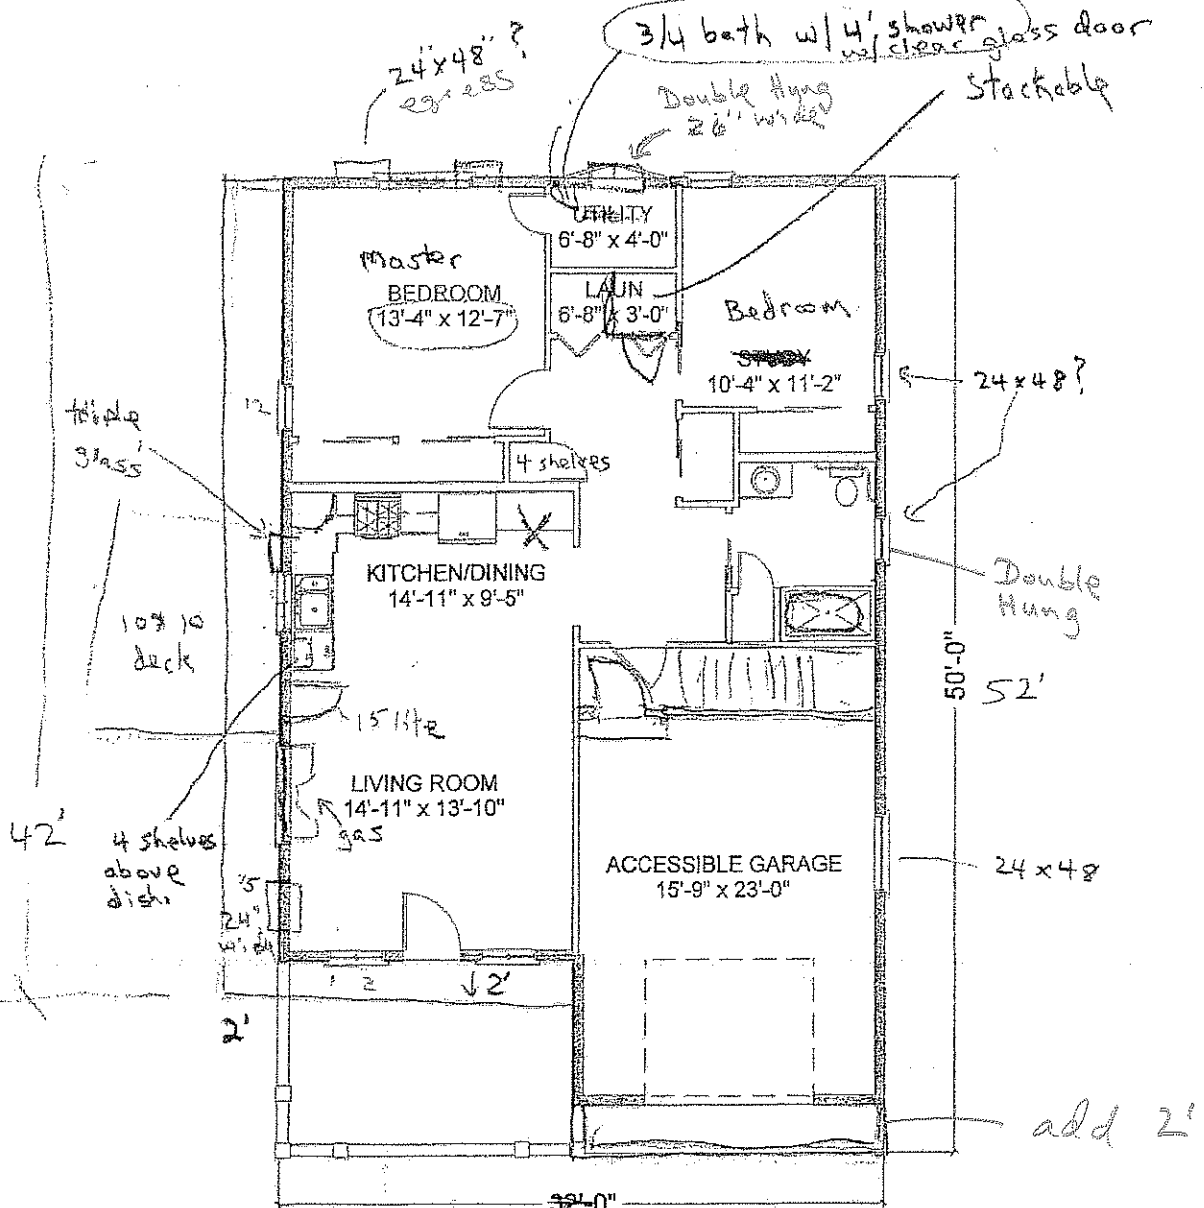

JK

LWC