


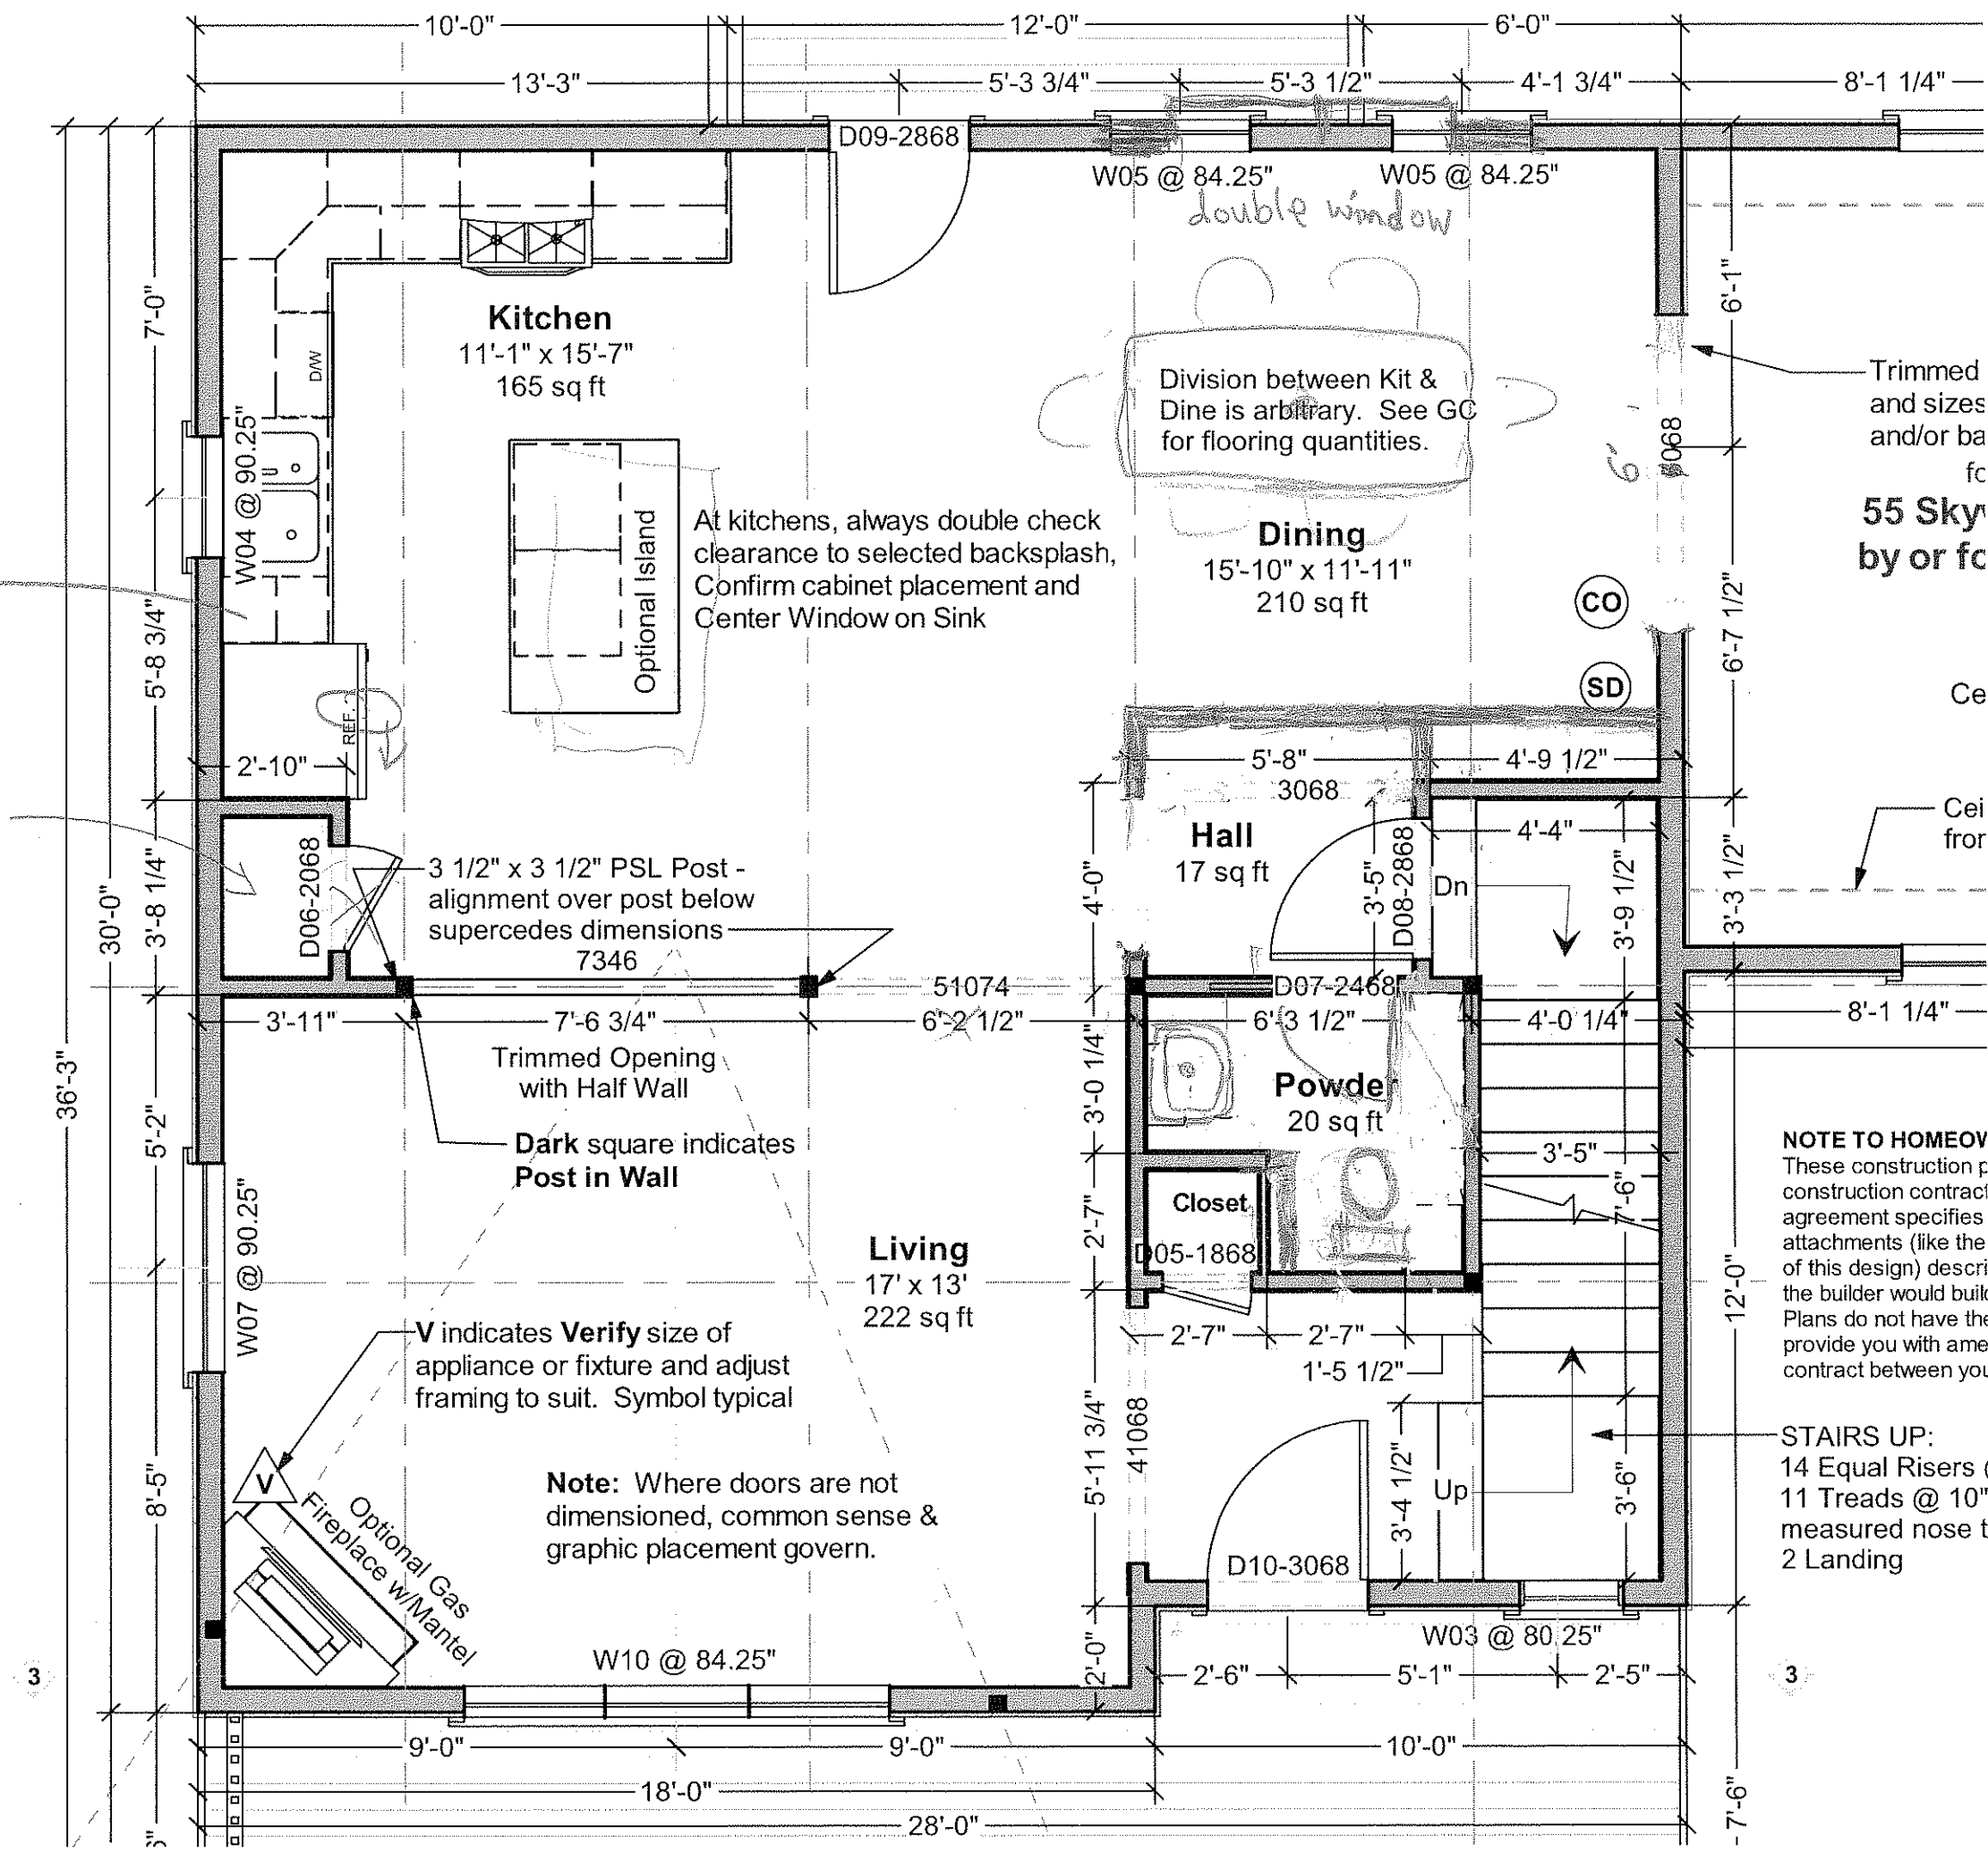

add to this cabinet

24" pantry cabinet

Division between Kit & Dine is arbitrary. See GC for flooring quantities.

Trimmed and sizes and/or ba
fc
55 Sky
by or fc

NOTE TO HOMEOWNER
These construction p
construction contract
agreement specifies
attachments (like the
of this design) descri
the builder would buil
Plans do not have the
provide you with ame
contract between you

STAIRS UP:
14 Equal Risers (
11 Treads @ 10"
measured nose t
2 Landing

At kitchens, always double check clearance to selected backsplash, Confirm cabinet placement and Center Window on Sink

3 1/2" x 3 1/2" PSL Post - alignment over post below supercedes dimensions 7346

Trimmed Opening with Half Wall

Dark square indicates Post in Wall

V indicates Verify size of appliance or fixture and adjust framing to suit. Symbol typical

Note: Where doors are not dimensioned, common sense & graphic placement govern.

