

Aaron Solo Prime

279.003

© 2013 Art Form Architecture, Inc. All Rights Reserved . <http://www.artformhomeplans.com>

Second Floor

Living Area: 937 SF


Bedrooms: 3

Bathrooms: 2.0

Ceiling Height Shown: 8'-0"

Ceiling Height Possible*: 8'-0"

* -- Increasing ceiling height requires a Major Change.

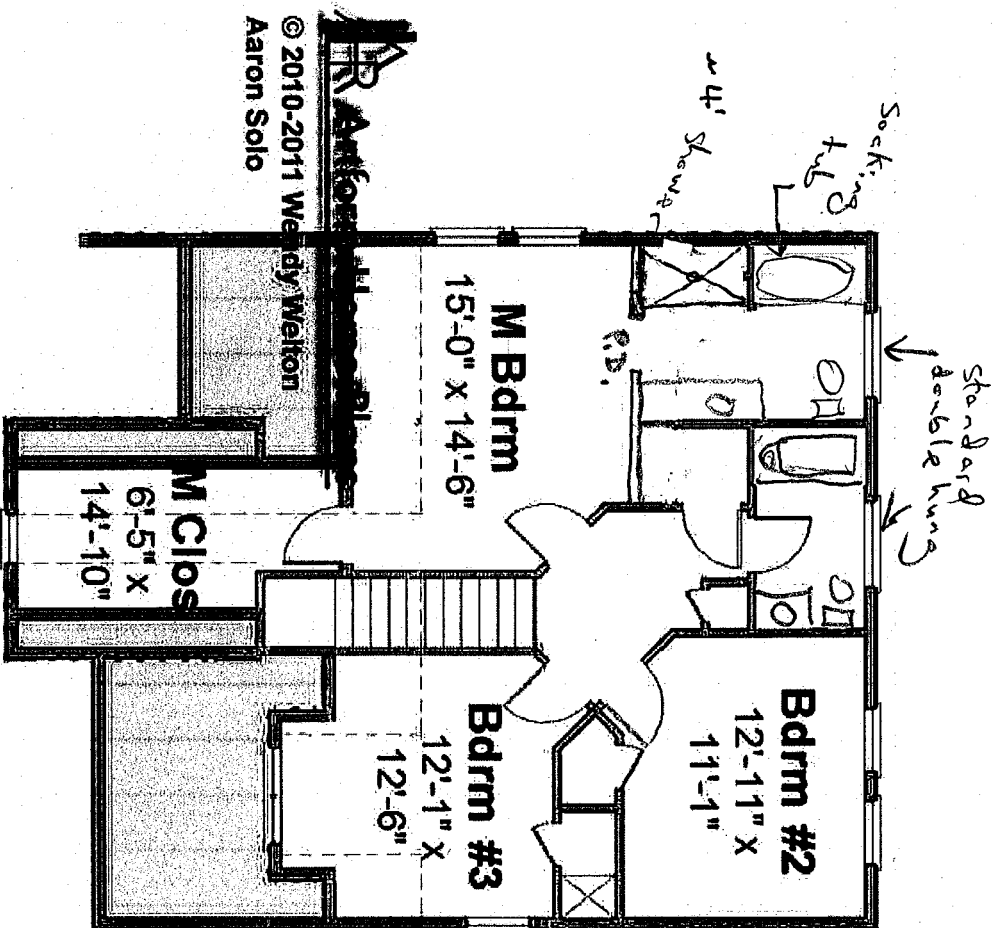

Aaron Solo Prime

279.003

© 2013 Art Form Architecture, Inc. All Rights Reserved . <http://www.artformhomeplans.com>

Basement Floor

Living Area: 0 SF



Bedrooms: 0

Bathrooms: 0.0

Ceiling Height Shown: 7'-8"

Ceiling Height Possible*: 9'-0"

* -- Increasing ceiling height requires a Major Change.

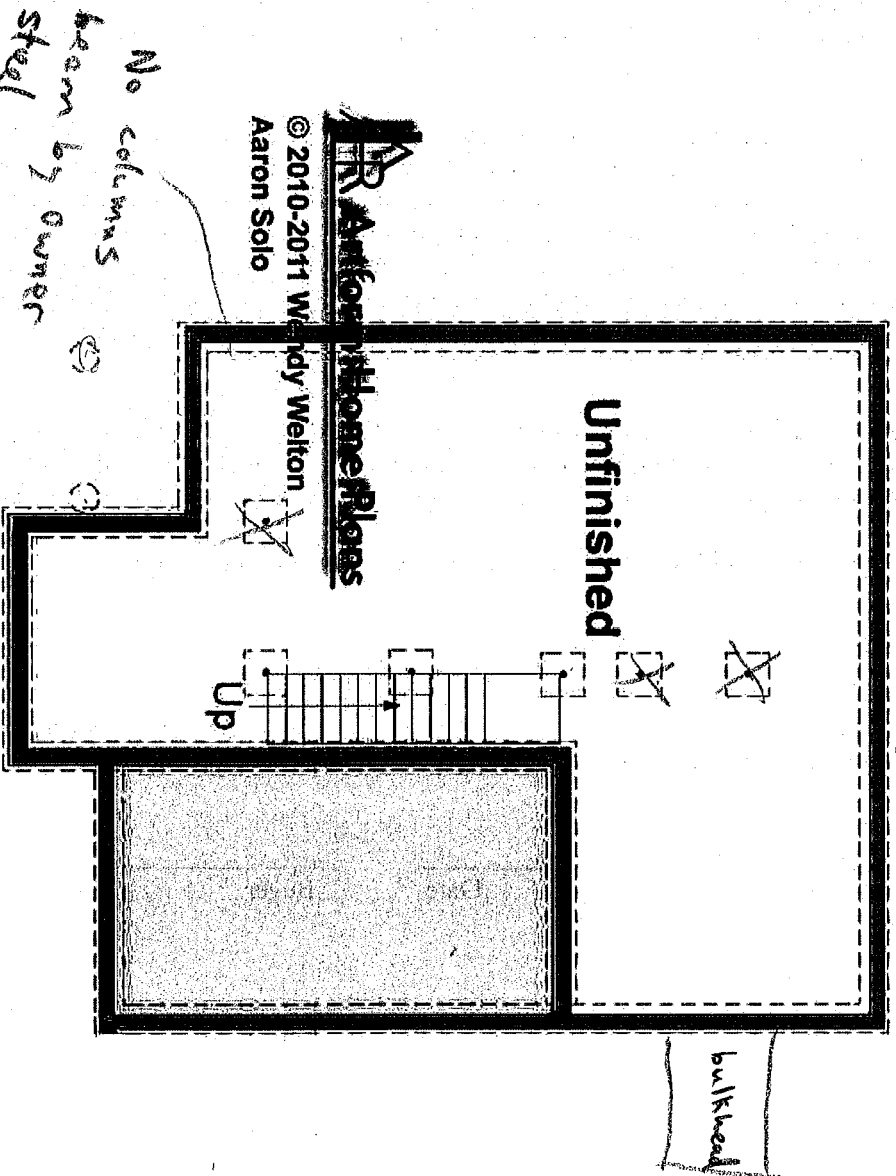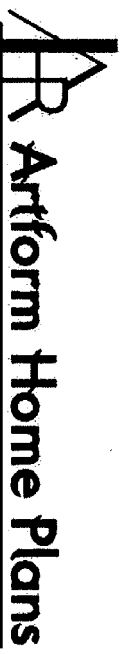

© 2010-2011 Wendy Welton
Aaron Solo

Aaron Solo Prime

279.003

© 2013 Art Form Architecture, Inc. All Rights Reserved . <http://www.artformhomeplans.com>

First Floor

Living Area: 896 SF


Bedrooms: 1

Bathrooms: 1.0

Ceiling Height Shown: 8'-0"

Ceiling Height Possible*: 9'-0"

* - Increasing ceiling height requires a Major Change.

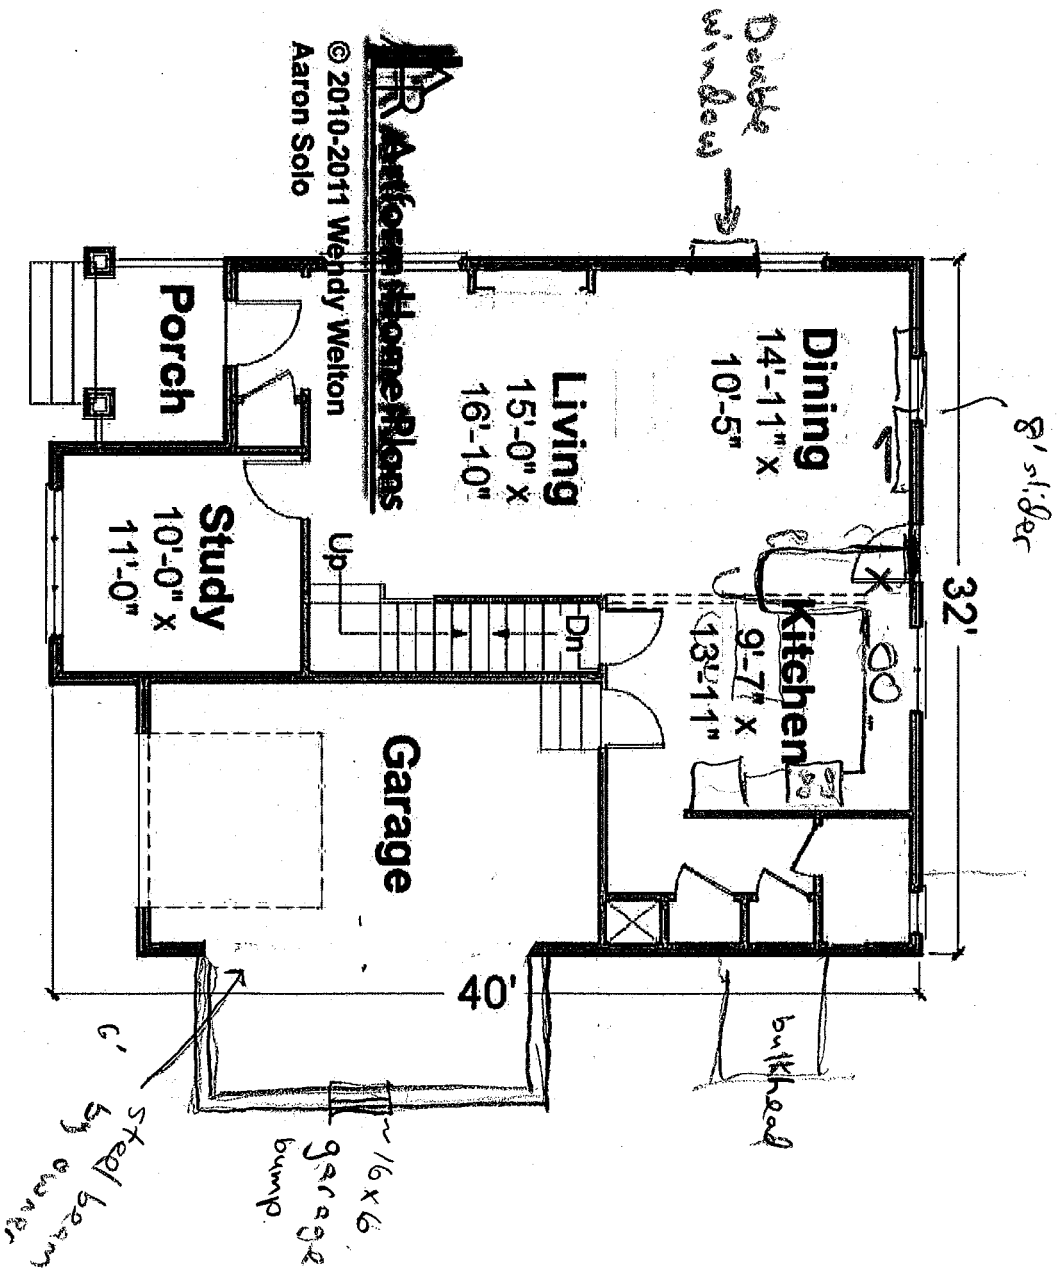


Aaron Solo Prime

279.003

© 2013 Art Form Architecture, Inc. All Rights Reserved . <http://www.artformhomeplans.com>

Elevations

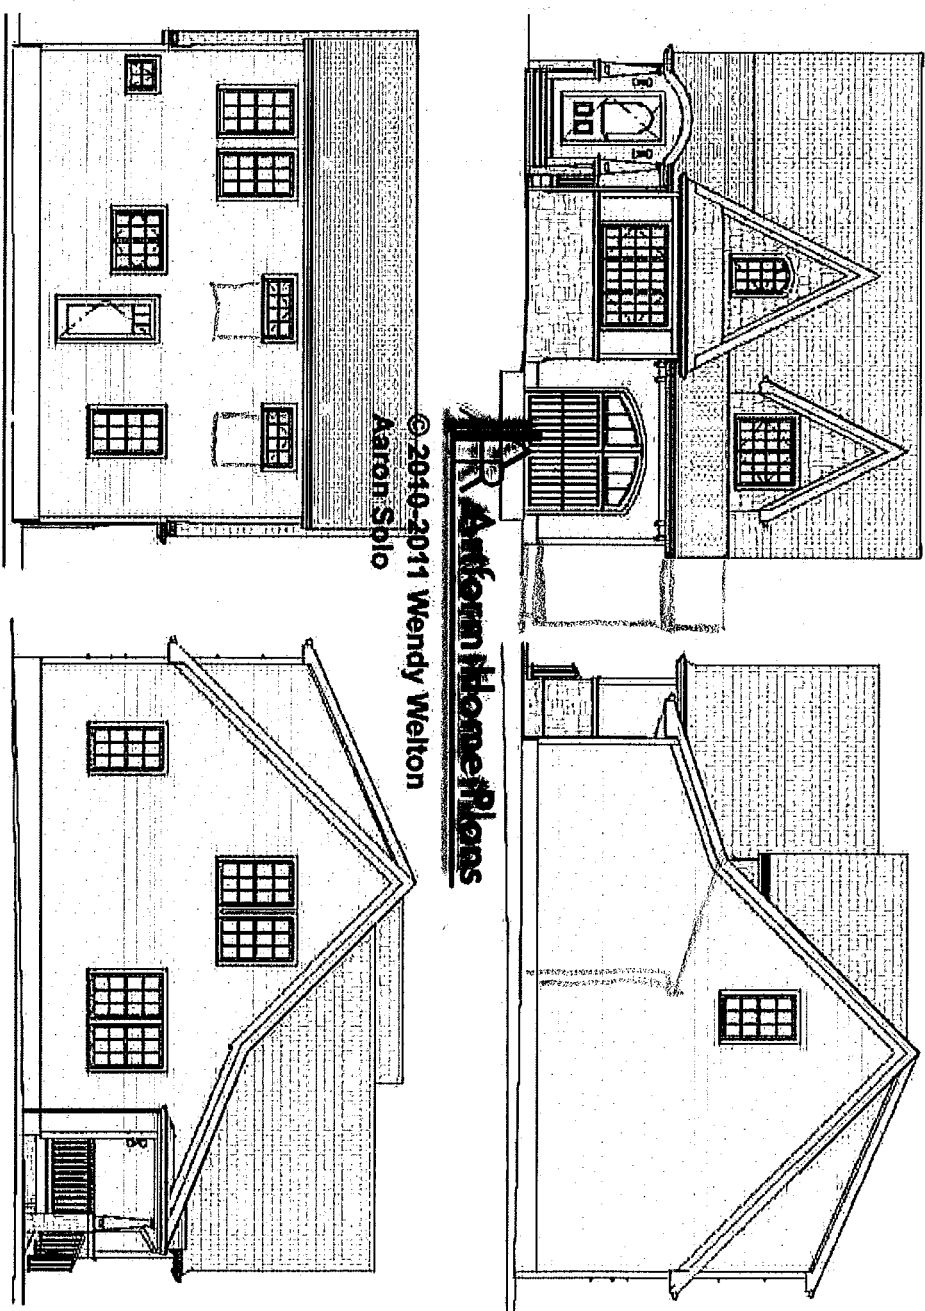


© 2010-2011 Wendy Welton
Aaron Solo

Aaron Solo Prime

279.003

© 2013 Art Form Architecture, Inc. All Rights Reserved . <http://www.artformhomeplans.com>

Elevations

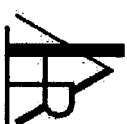 Artform Home Plans

