

Alexander

449.002

© 2013 Art Form Architecture, Inc. All Rights Reserved . <http://www.artformhomeplans.com>

First Floor

Living Area: 1211 SF


Bedrooms: 1

Bathrooms: 1.0

Ceiling Height Shown: 8'-0"

Ceiling Height Possible*: 8'-0"

* -- Increasing ceiling height requires a Major Change.

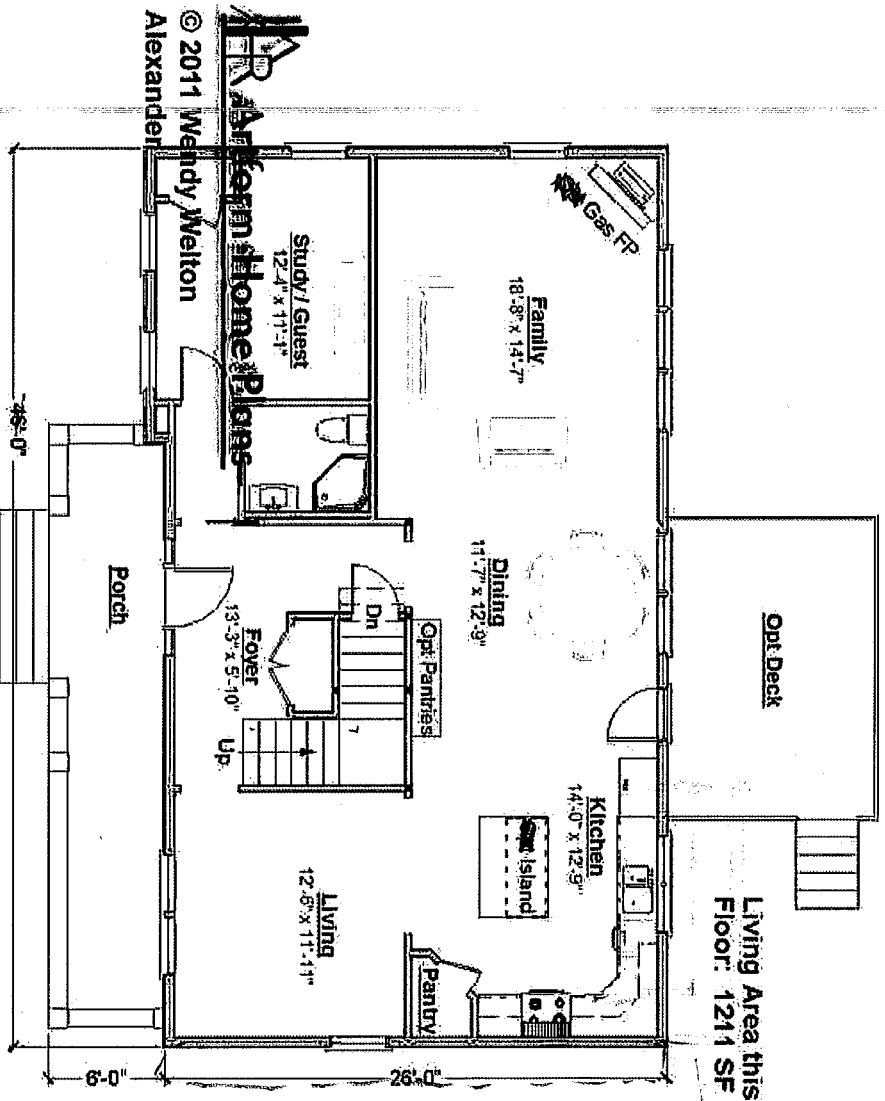

Mirror
Image home
see bl

Alexander

449.002

© 2013 Art Form Architecture, Inc. All Rights Reserved . <http://www.artformhomeplans.com>

Second Floor

Living Area: 1224 SF


Bedrooms: 3

Bathrooms: 2.0

Ceiling Height Shown: 8'-0"

Ceiling Height Possible*: 8'-0"

* - Increasing ceiling height requires a Major Change.

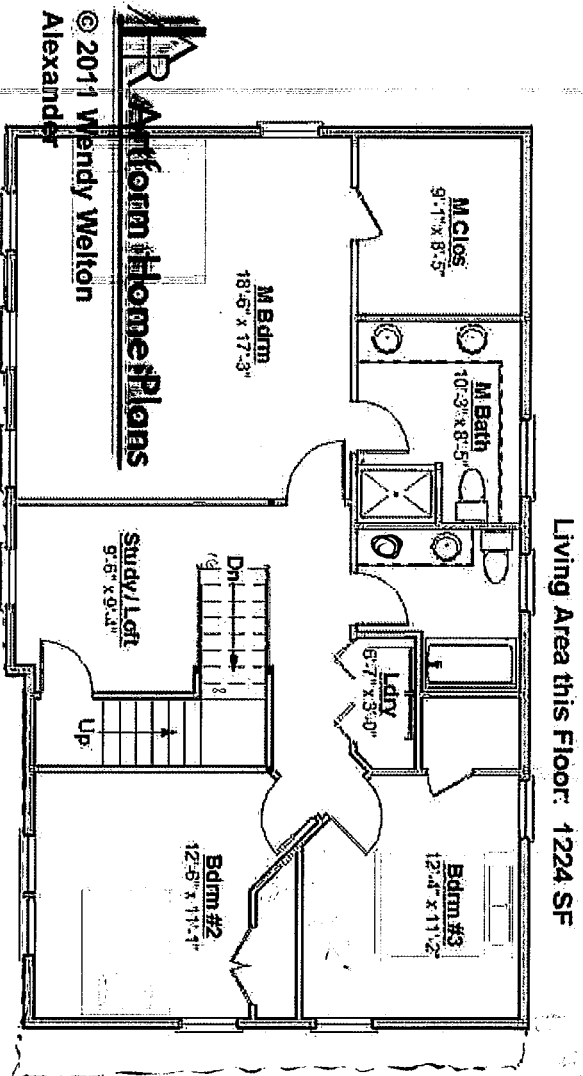

4'8"

8'6"

Alexander

449.002

© 2013 Art Form Architecture, Inc. All Rights Reserved . <http://www.artformhomeplans.com>

Basement Floor

Living Area: 0 SF

Bedrooms: 0

Bathrooms: 0.0

Ceiling Height Shown: 7'-8"


Ceiling Height Possible*: 7'-8"

* - Increasing ceiling height requires a Major Change.



© 2014 Wendy Welton

Alexander

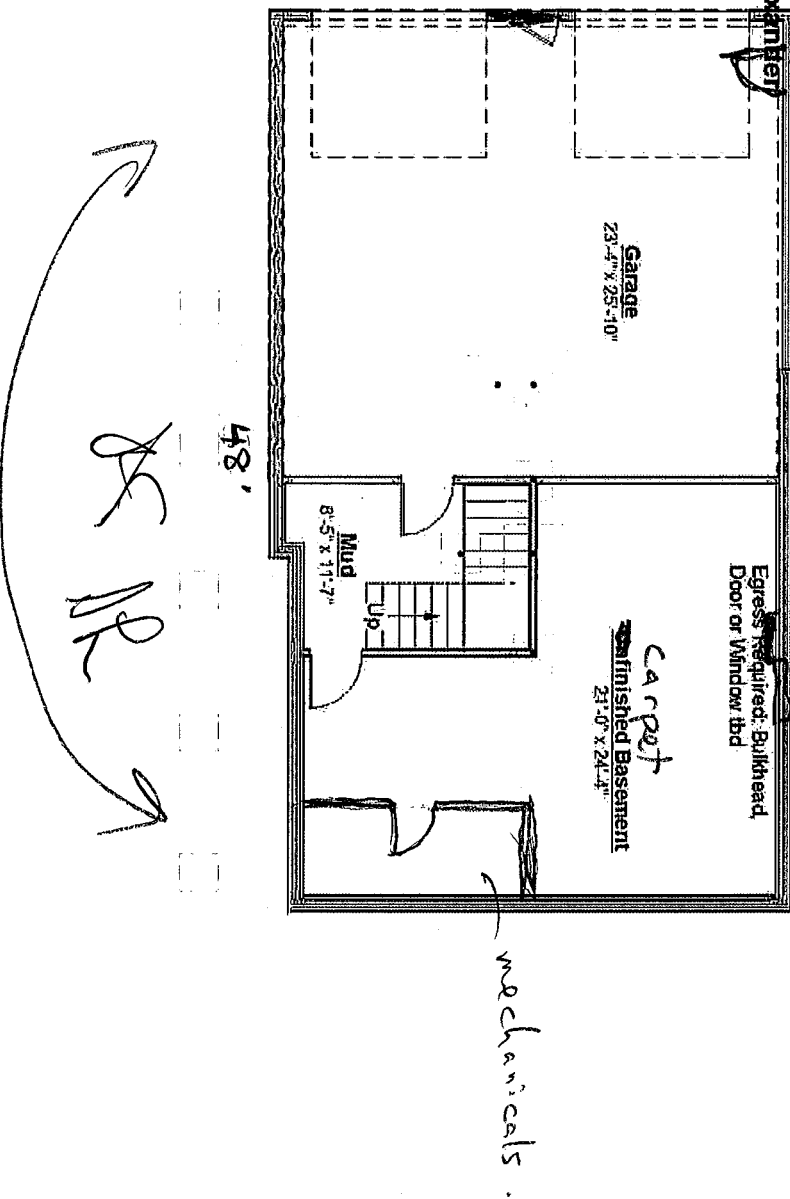

Alexander

449.002

© 2013 Art Form Architecture, Inc. All Rights Reserved . <http://www.artformhomeplans.com>

Attic Floor

Living Area: 804 SF


Bedrooms: 2

Bathrooms: 1.0

Ceiling Height Shown: 8'-0"

Ceiling Height Possible*: 8'-0"

* -- Increasing ceiling height requires a Major Change.





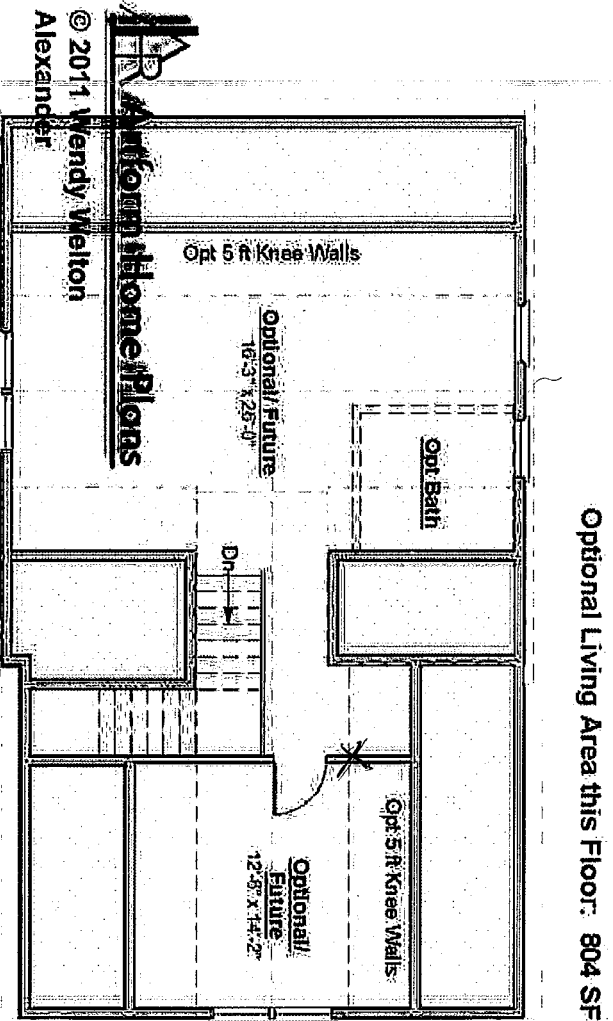


Alexander

449.002

© 2013 Art Form Architecture, Inc. All Rights Reserved . <http://www.artformhomeplans.com>

Elevations

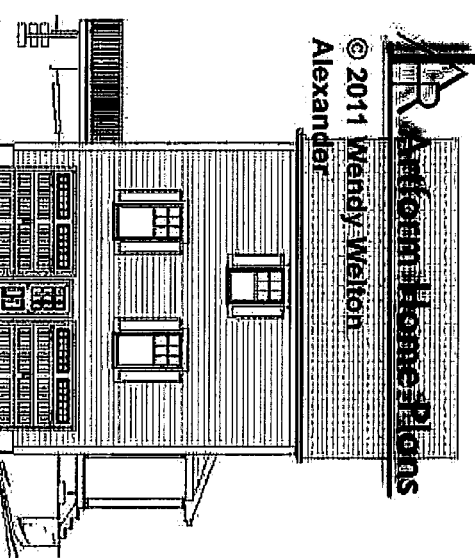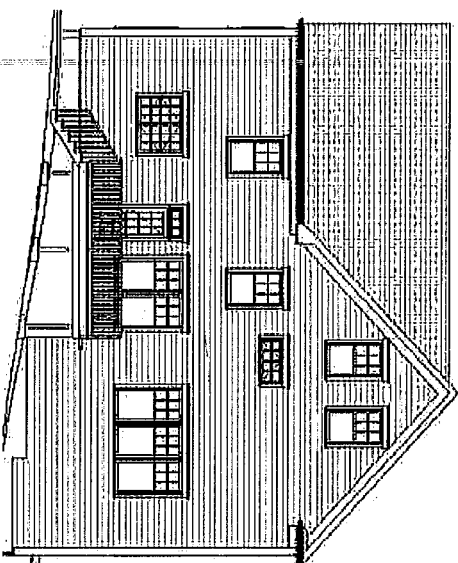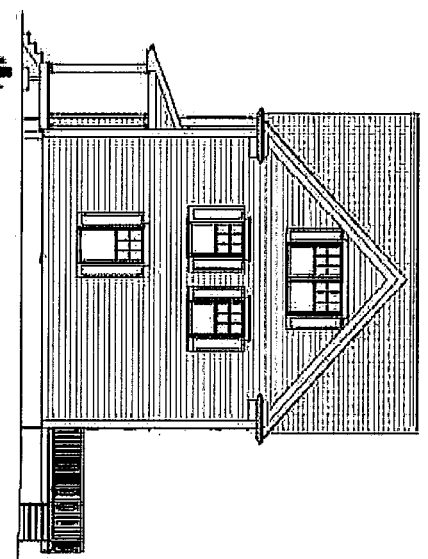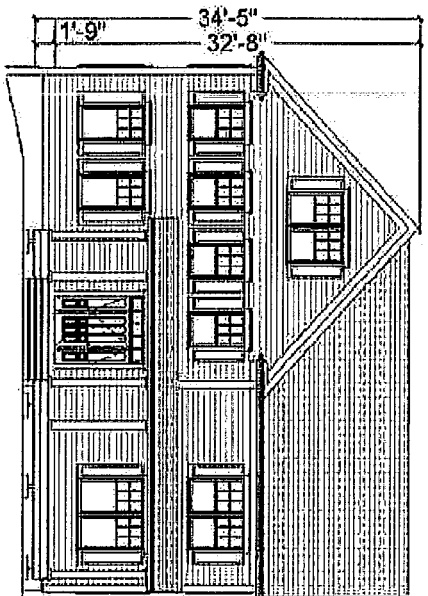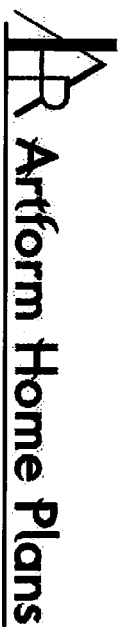

Handwritten initials or signature.