

## Changes to Rev 1

### First Floor:

Add Deck from 3 season to front porch, stairs to yard

3 Season Porch: Add 36"W door to deck.

Increase window length.

Cathedral ceiling

Gable end to match house (Overhang).

Family Room: Move fireplace to the center of back wall of family room.

Place window on each side of fireplace, please leave space between FP and window for exterior trim.

Study: One window on back wall, center of the room.

One window on side wall, center of the room.

Bathroom: Larger window (Pella 2-8/2-6 min)

What is the size of shower?

Kitchen: Put a return wall for fridge.

Note: We are planning on using Pella vinyl windows 350 series. We would like to discuss proposed window sizing before finalizing the plans. We would like DR, FR and Study windows to be same size. We would like the FR, and Study back windows to line up with 2<sup>nd</sup> floor BR windows. We are curious why the 2<sup>nd</sup> floor is 9over9 DH and 1<sup>st</sup> floor is 6over6 DH? We would like BR #1 & #2 windows to be same size (need to be smaller than 1<sup>st</sup> floor windows).

### Second Floor:

MBR Closet: Add window (Pella 2-8/2-6)

Bedroom #1: Move FP location from side to back wall, centered between windows.

Bedroom #2: Back wall window, move to center of the room (Line up with first floor).

Bathroom: Window to be same as MBR closet.

# High Skipper


389.120j.v5

© 2014 Wendy Welton, all rights reserved. You may not build this design without purchasing a license, even if you make changes. This design may have geographic restrictions.

Artform Home Plans

603-431-9559

Living Area this Floor: 1190 SF  
9'-0" Ceiling Height

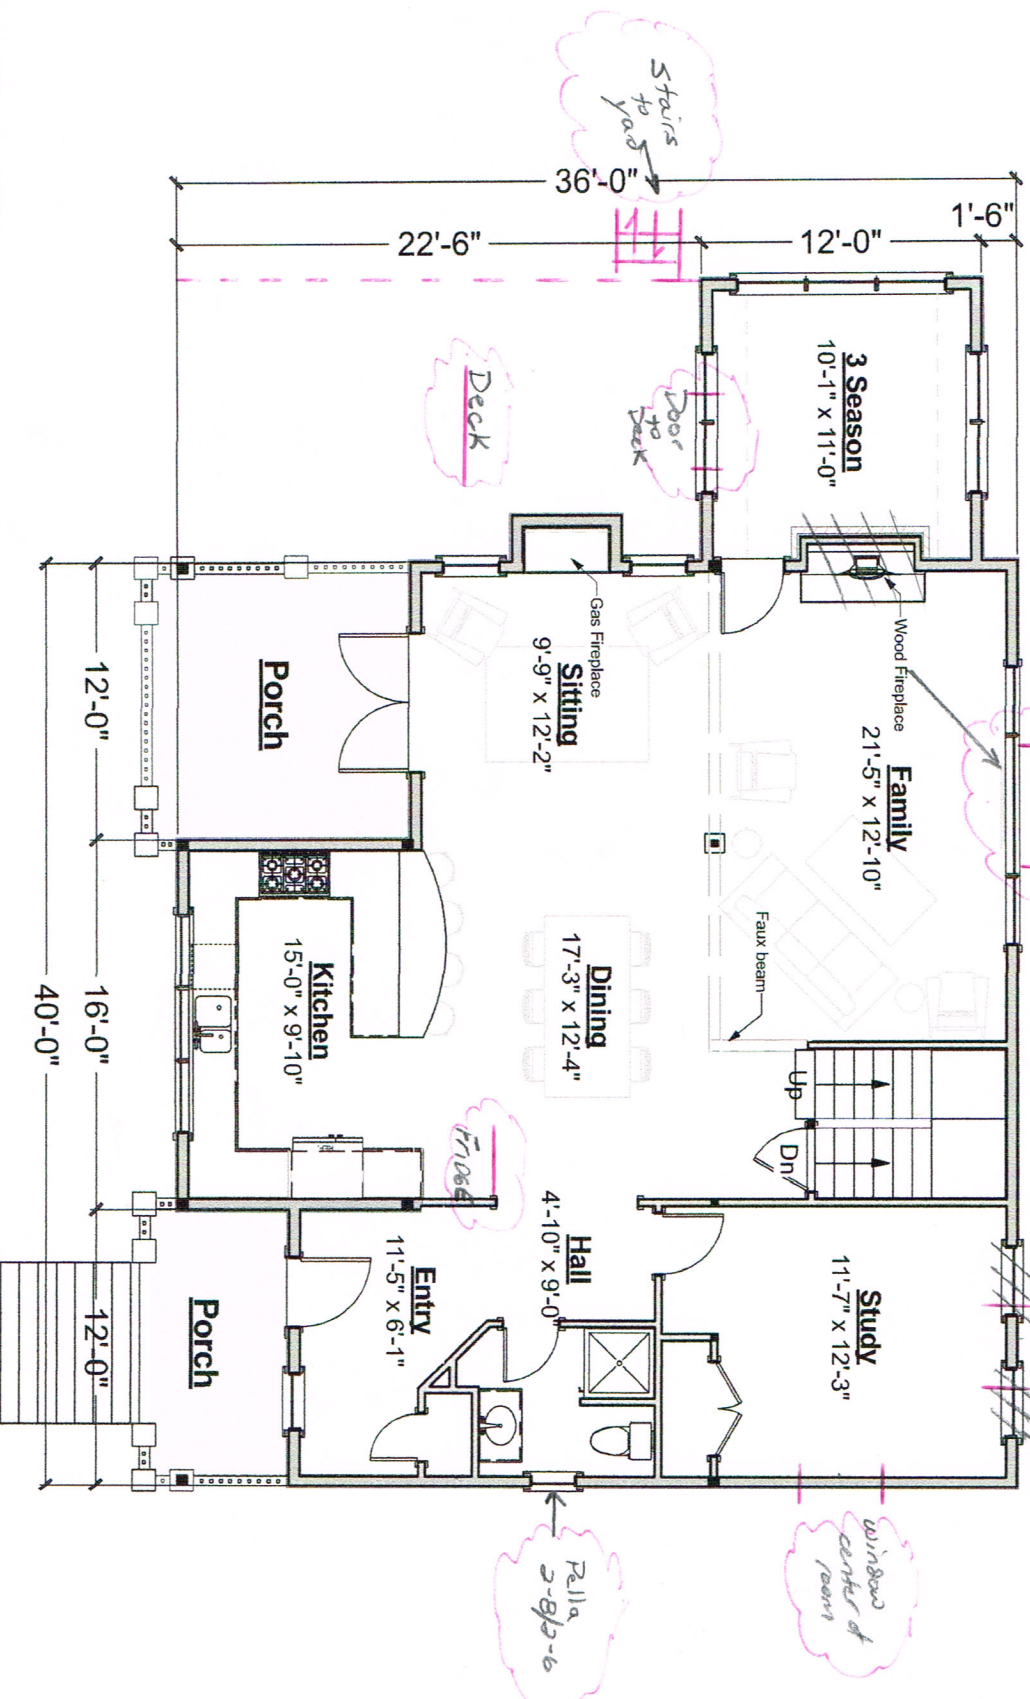

First Floor Plan

# High Skipper


389.120j.v5

© 2014 Wendy Welton, all rights reserved. You may not build this design without purchasing a license, even if you make changes. This design may have geographic restrictions.



603-431-9559

Living Area this Floor: 1234 SF

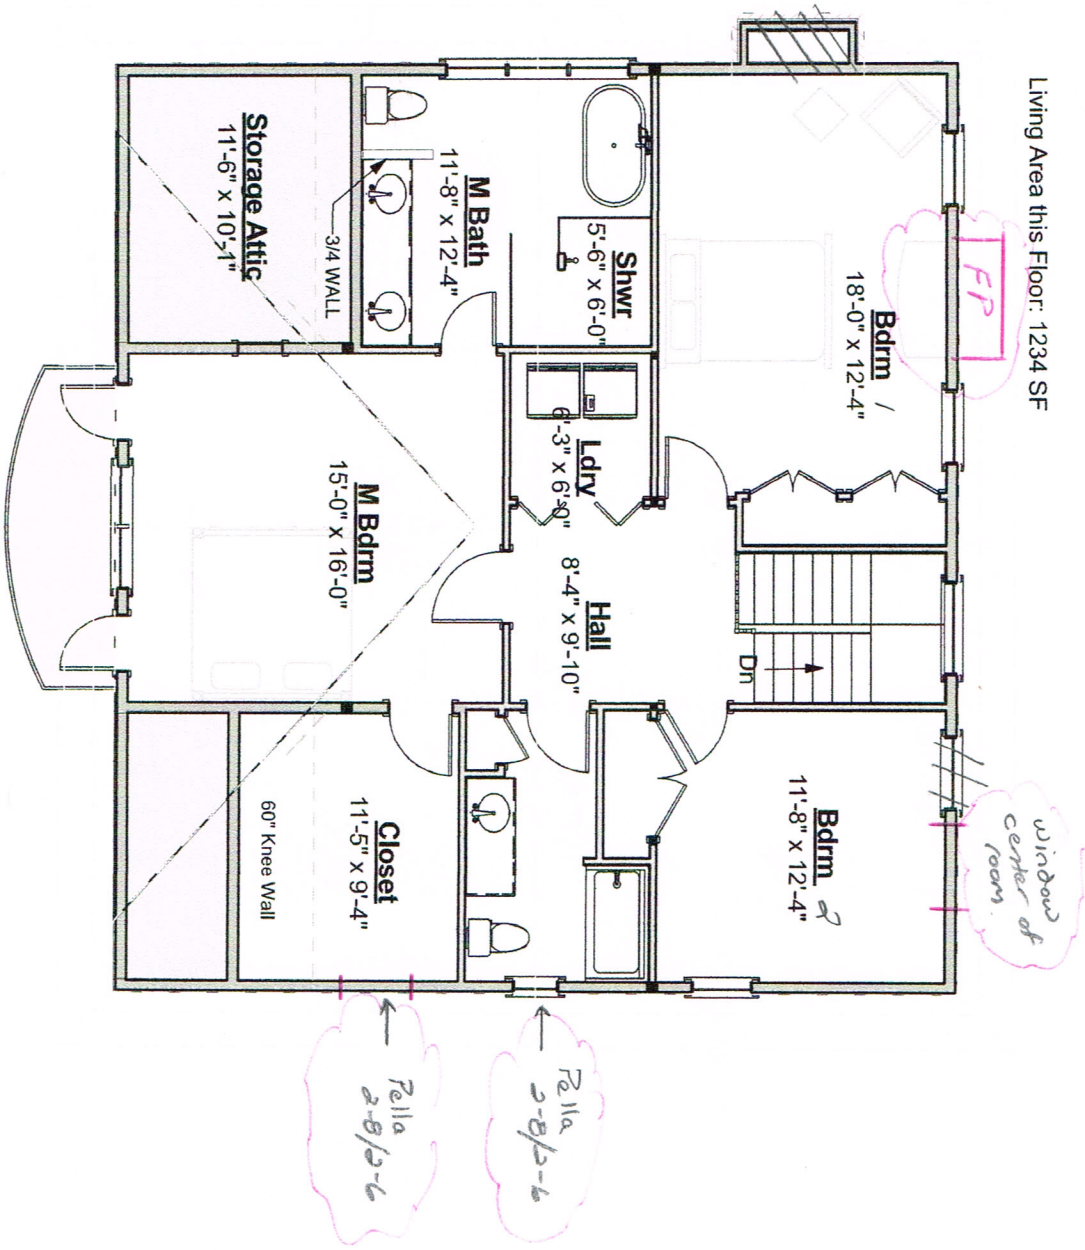


## Second Floor Plan

# High Skipper

389.120j.v5 © 2014 Wendy Wellon, all rights reserved. You may not build this design without purchasing a license, even if you make changes. This design may have geographic restrictions.

 Artform Home Plans

603-431-9559

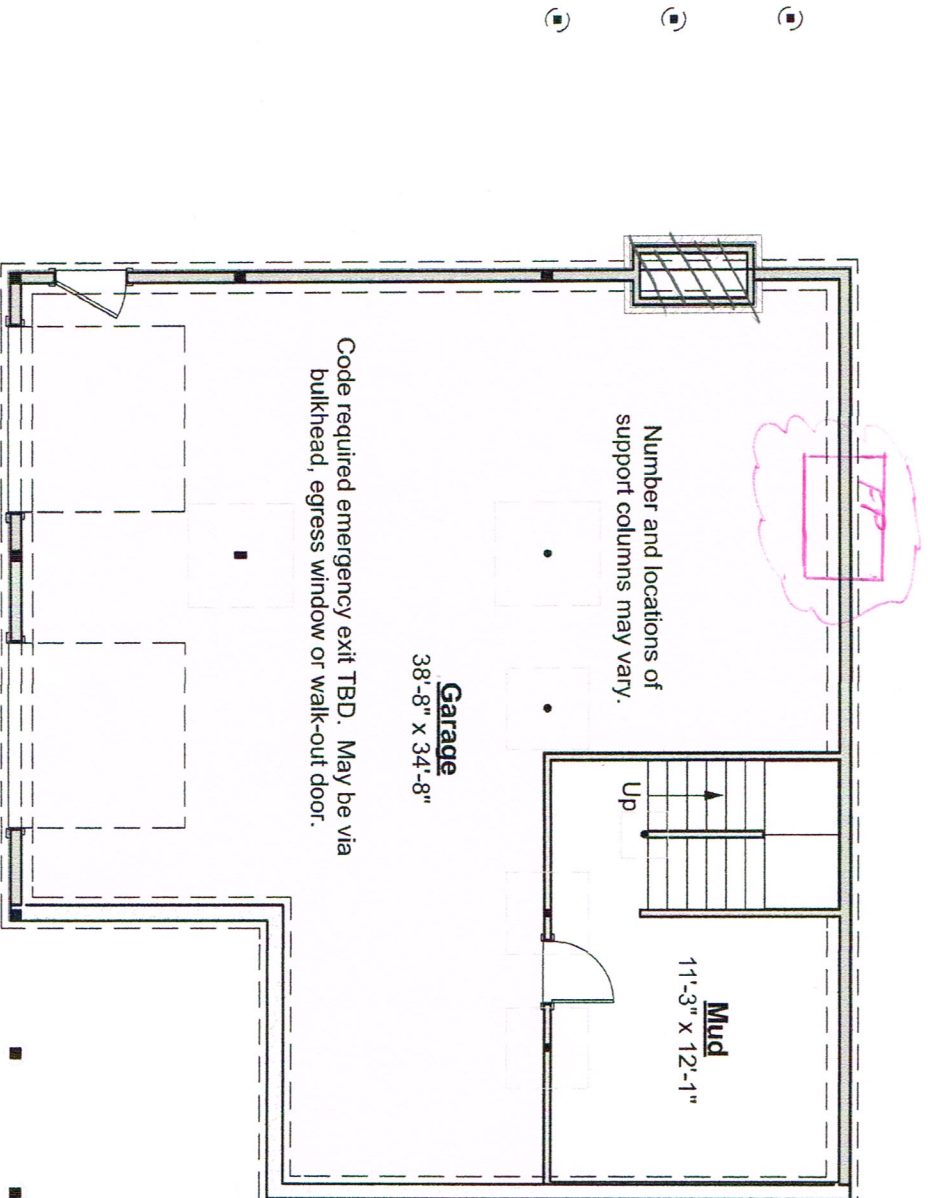


## Foundation Plan




# High Skipper

389.120j.v5

© 2014 Wendy Welton, all rights reserved. You may not build this design without purchasing a license, even if you make changes. This design may have geographic restrictions.

 Artform Home Plans

603-431-9559

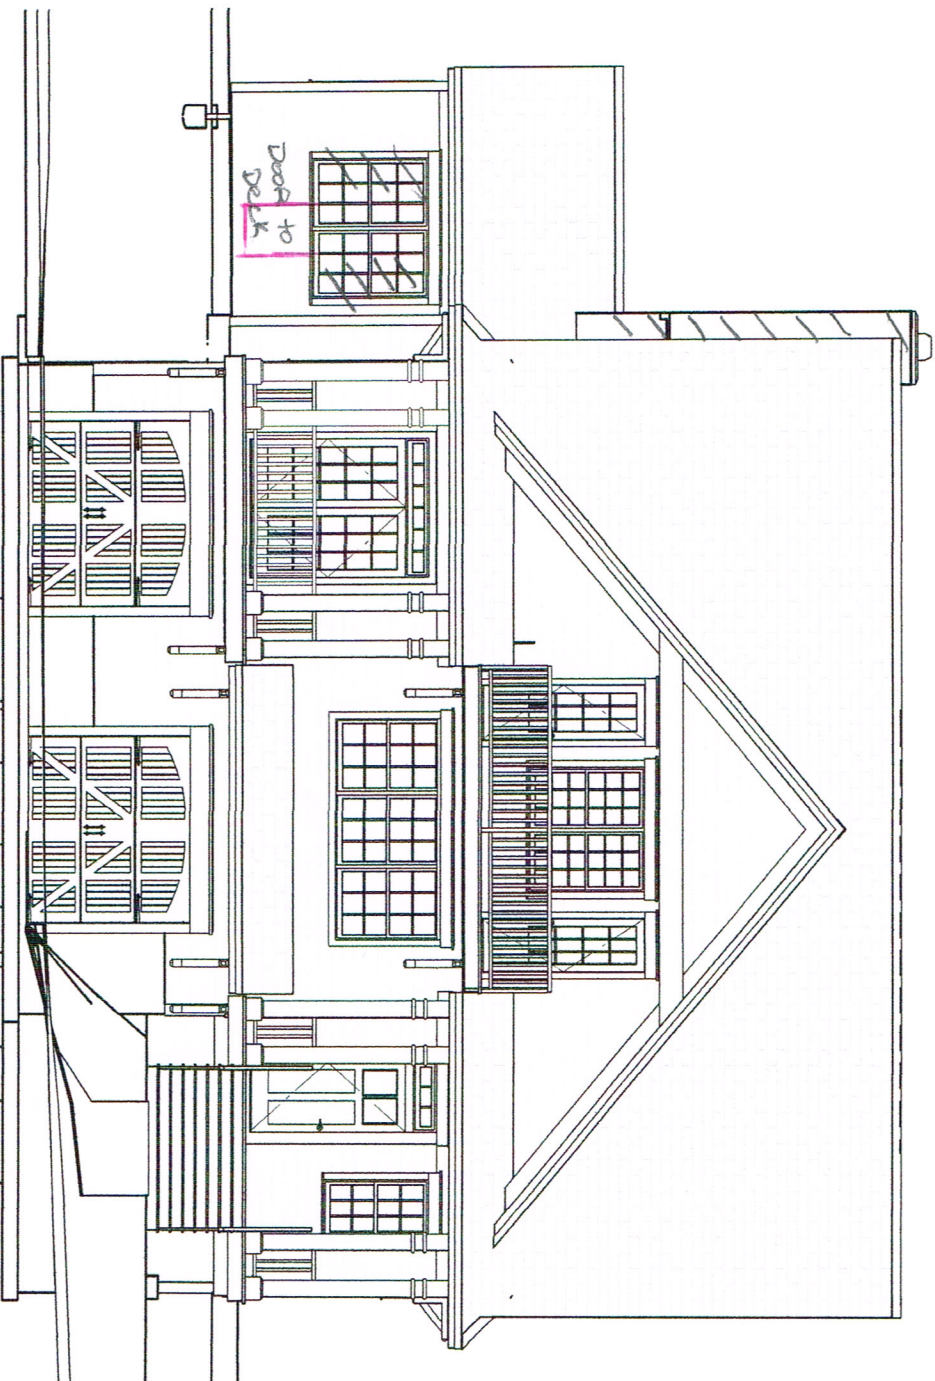


Front Elevation

# High Skipper

389.120j.v5 © 2014 Wendy Welton, all rights reserved. You may not build this design without purchasing a license, even if you make changes. This design may have geographic restrictions.

 Artform Home Plans

603-431-9559

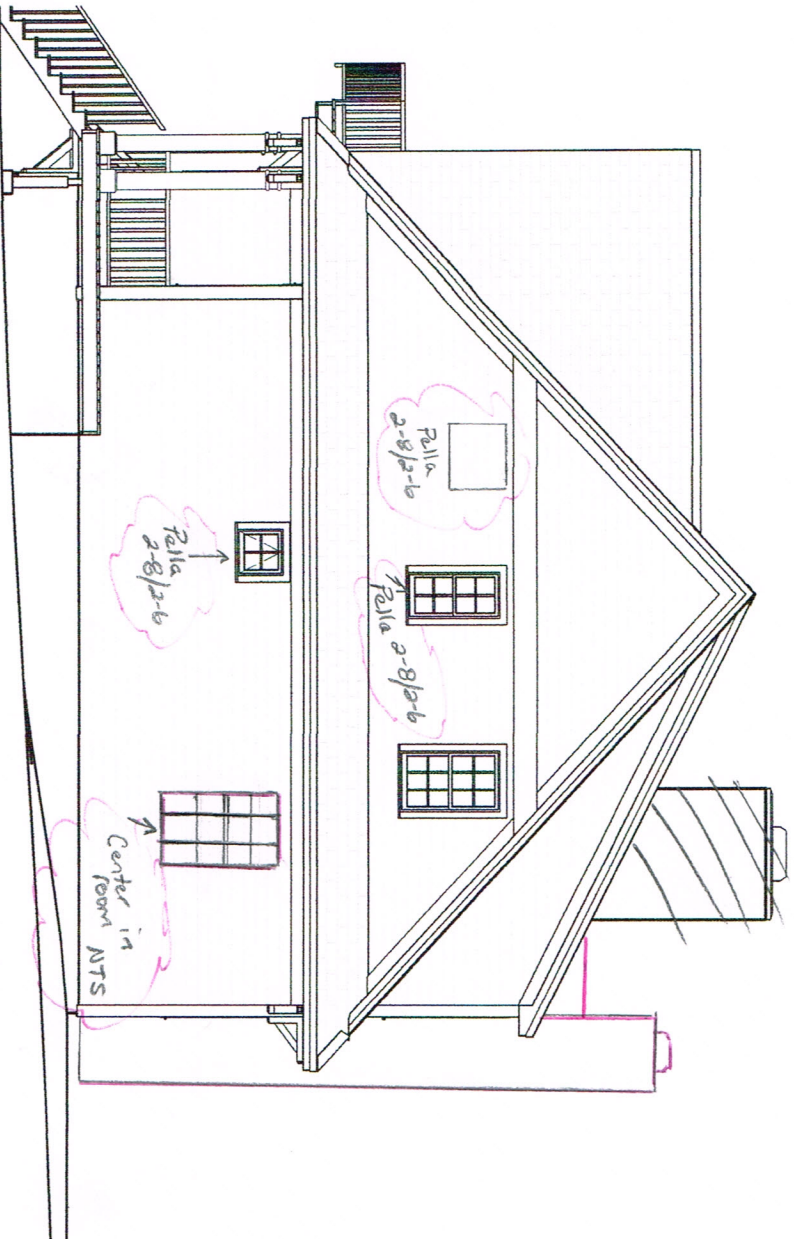

Right Elevation


# High Skipper

389.120j.v5

© 2014 Wendy Welton, all rights reserved. You may not build this design without purchasing a license, even if you make changes. This design may have geographic restrictions.



603-431-9559

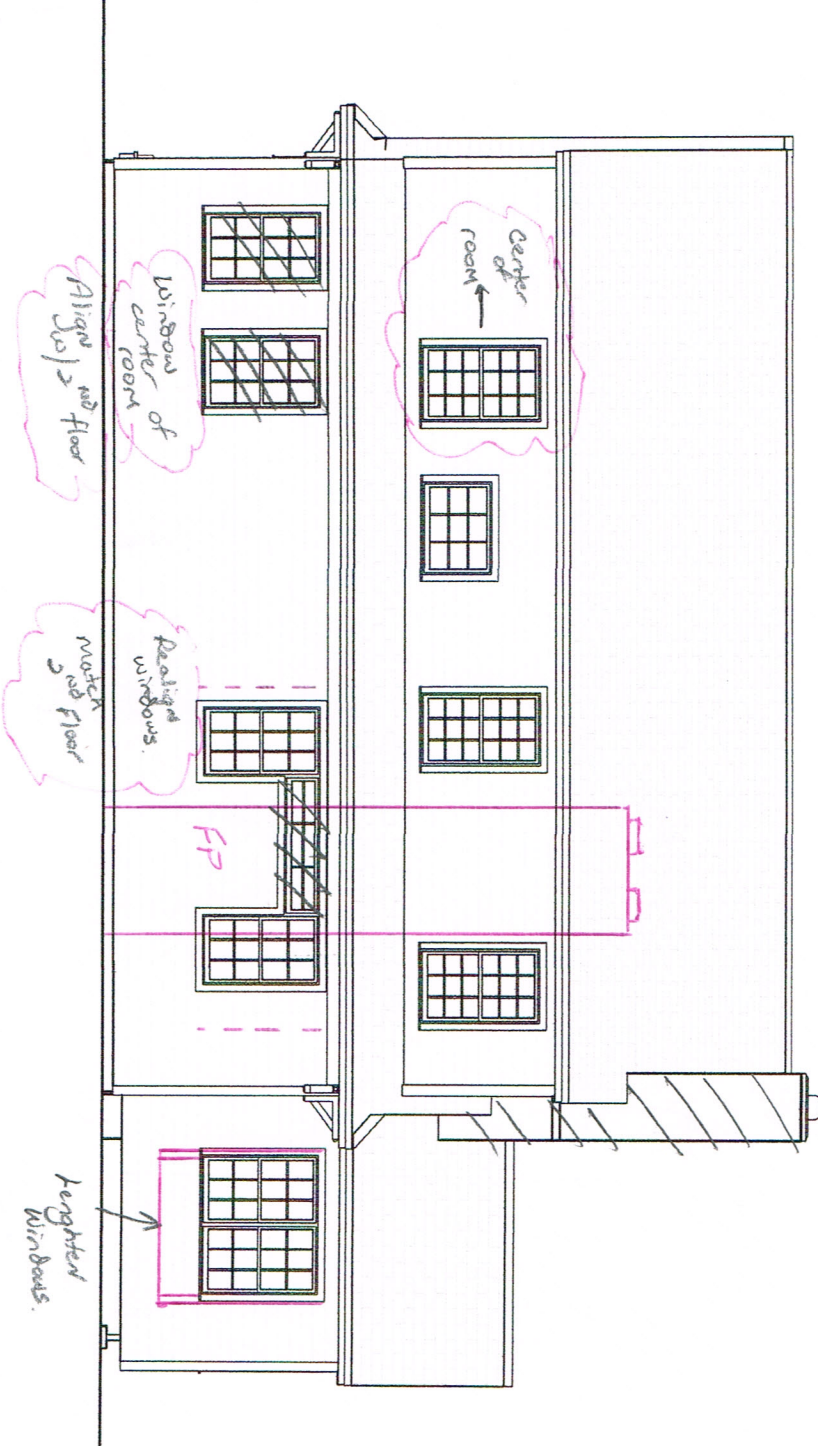


## Rear Elevation



## 389.120j.v5

603-431-9559

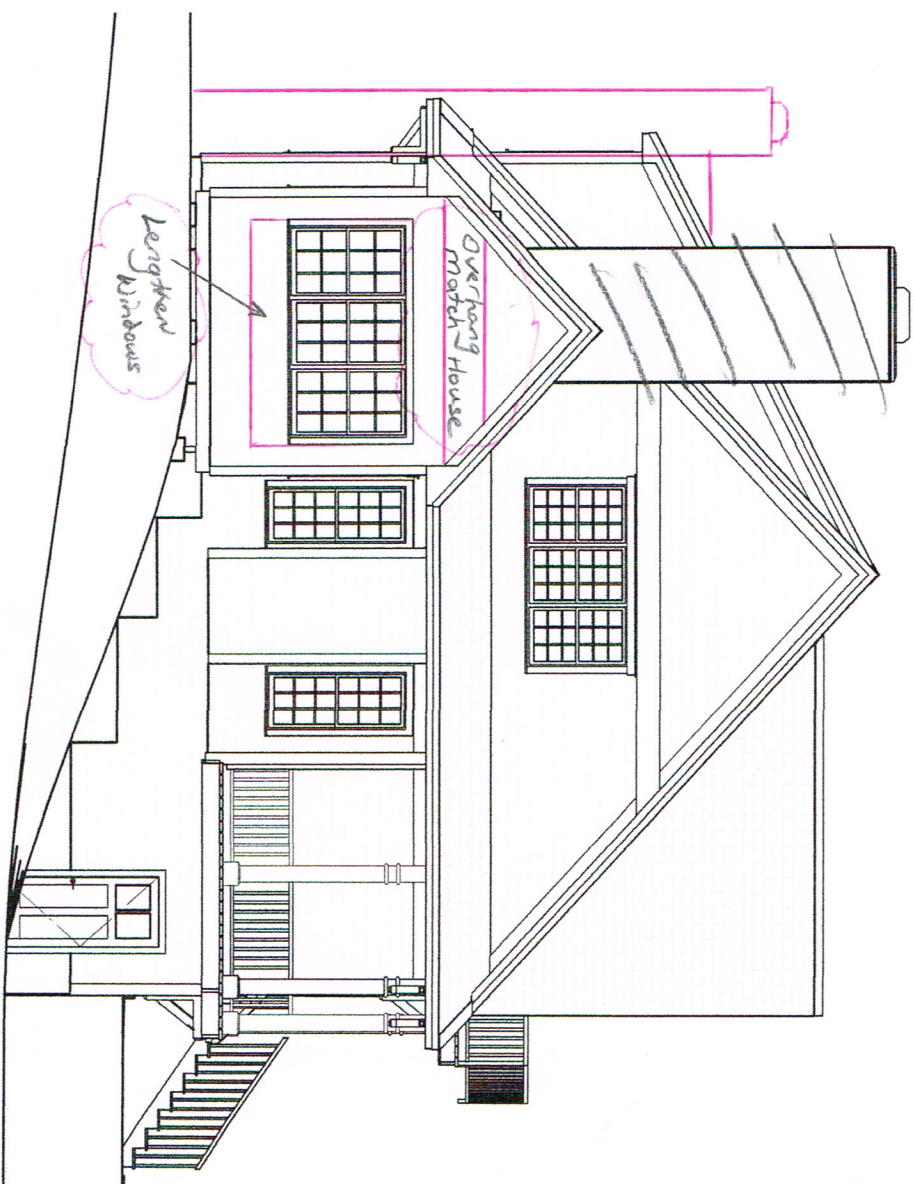

### Left Elevation