

berry Square

	Beds	Baths
1	2	2
2	0	0
3	0	0
4	2	2


g Height 22.46 ± 0.11

8'-0"

* 8-01

a plan page for cost

100

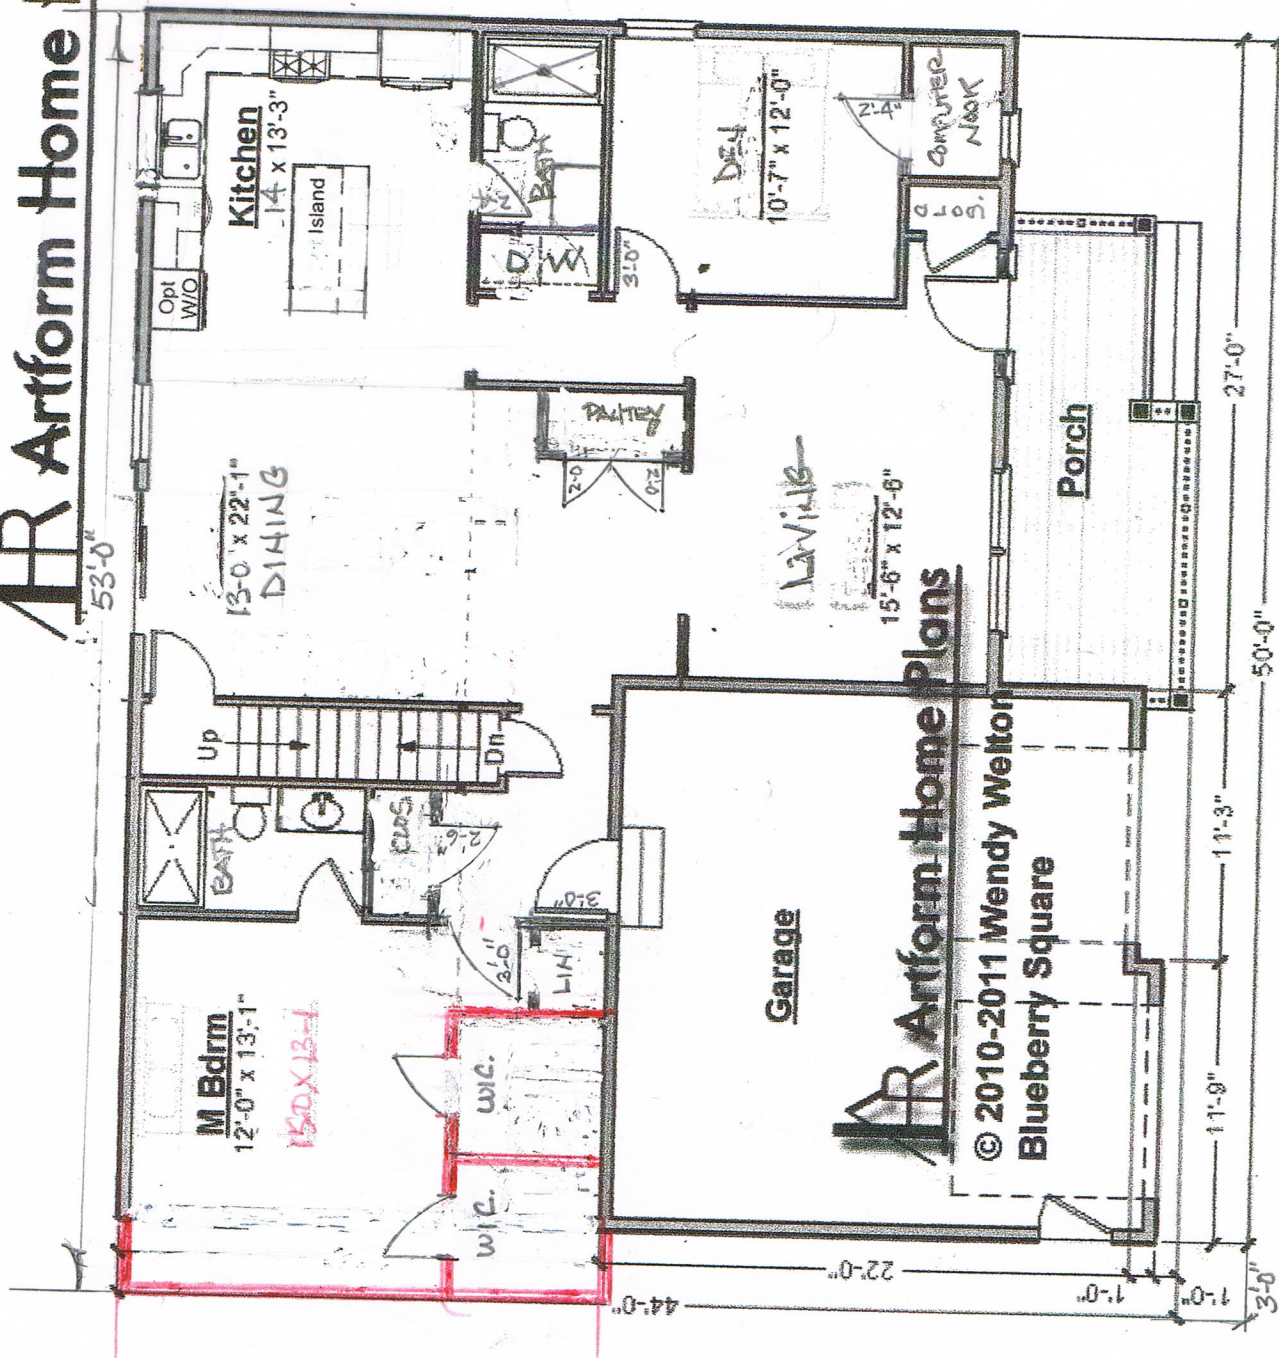

© 2010-2011 Wendy Welton
Blueberry Square

berry Square

Artform Home Plans

1/8"

Beds Baths

0 0

F 2 1

0 0

F 2 1

ing Height


vn 8'-0"

e* 8'-0"

on plan page for cost

Artform Home Plans

© 2010-2011 Wendy Welton
Blueberry Square

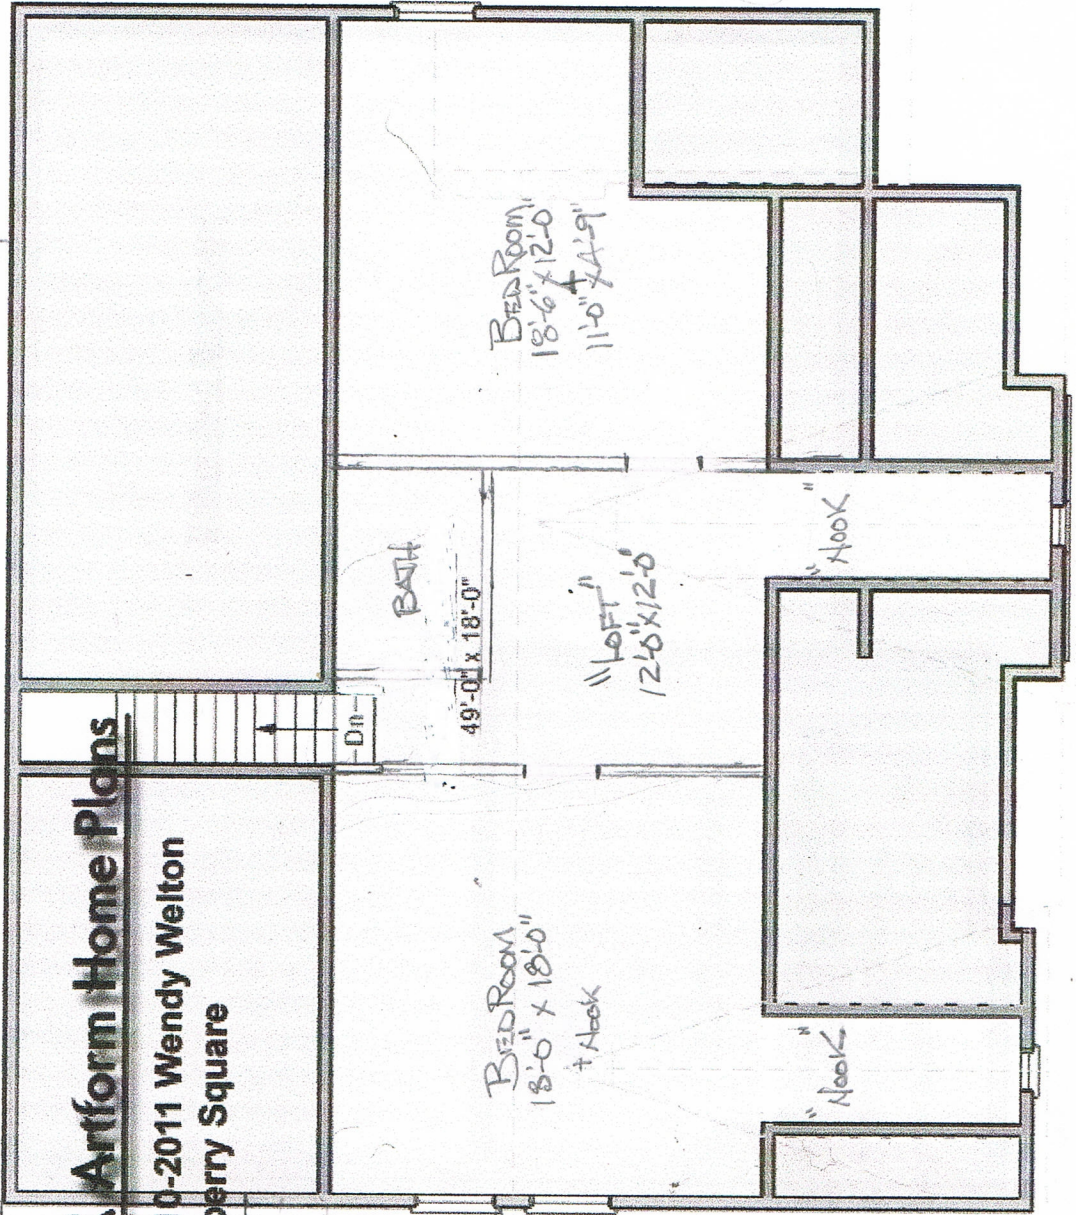

7/22/11

1/8"

Rooms	Baths
0	0
0	0
Light	
1'-0"	
1'-0"	

page for cost

