


Bernard

665.124.v3 KR

© 2012-2015 Wendy Welton, all rights reserved. You may not build this design without purchasing a license, even if you make changes. This design may have geographic restrictions.

 Artform Home Plans

603-431-9559

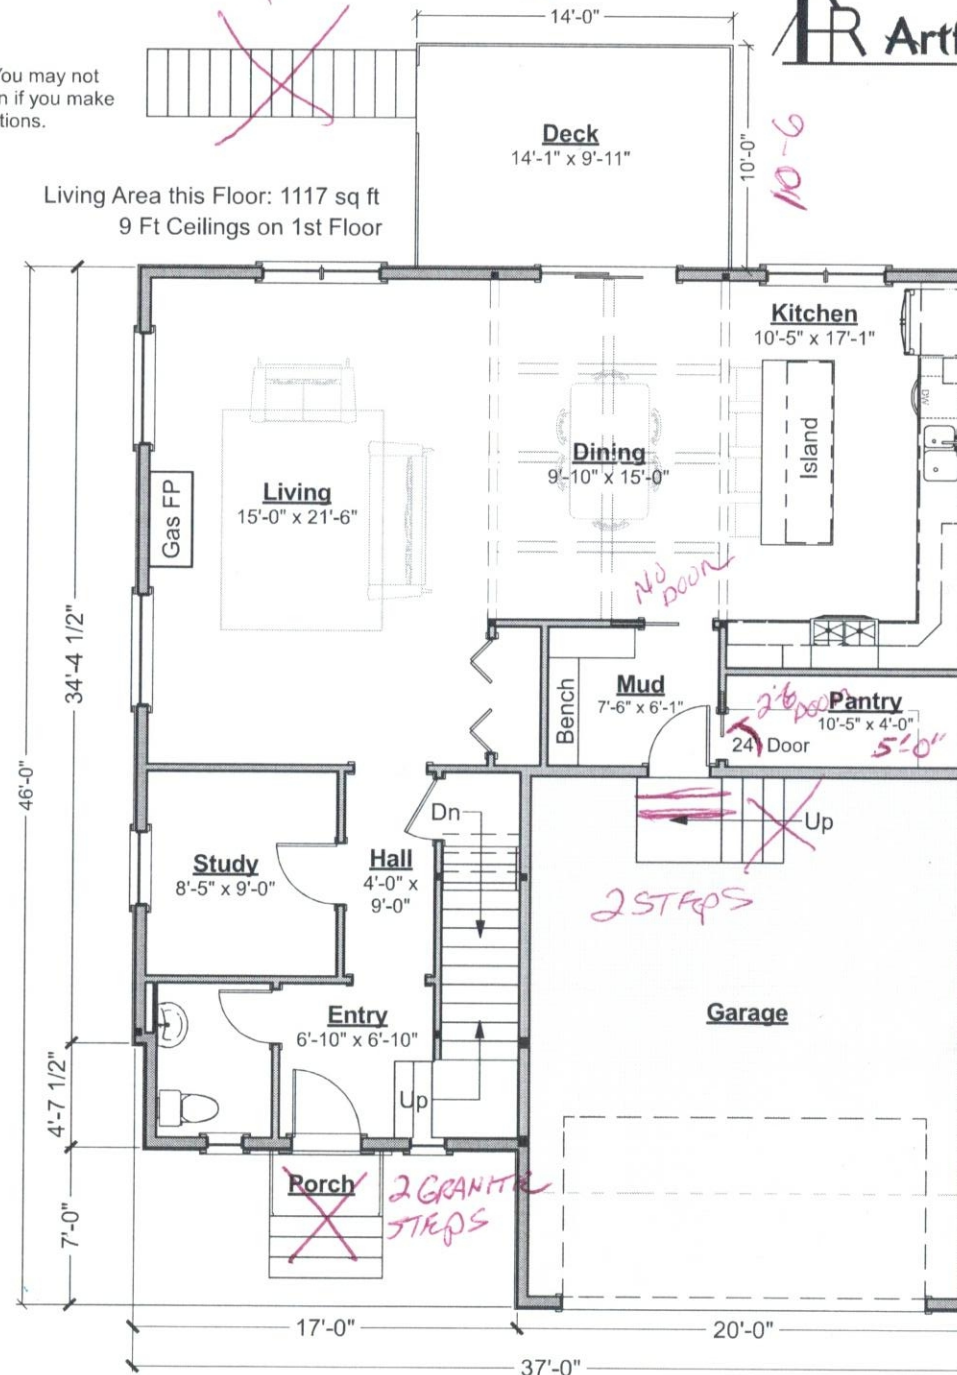

First Floor Plan

Bernard


665.124.v3 KR

© 2012-2015 Wendy Welton, all rights reserved . You may not build this design without purchasing a license, even if you make changes. This design may have geographic restrictions.

 Artform Home Plans

603-431-9559

Egress need if space is over 200 sq.ft.

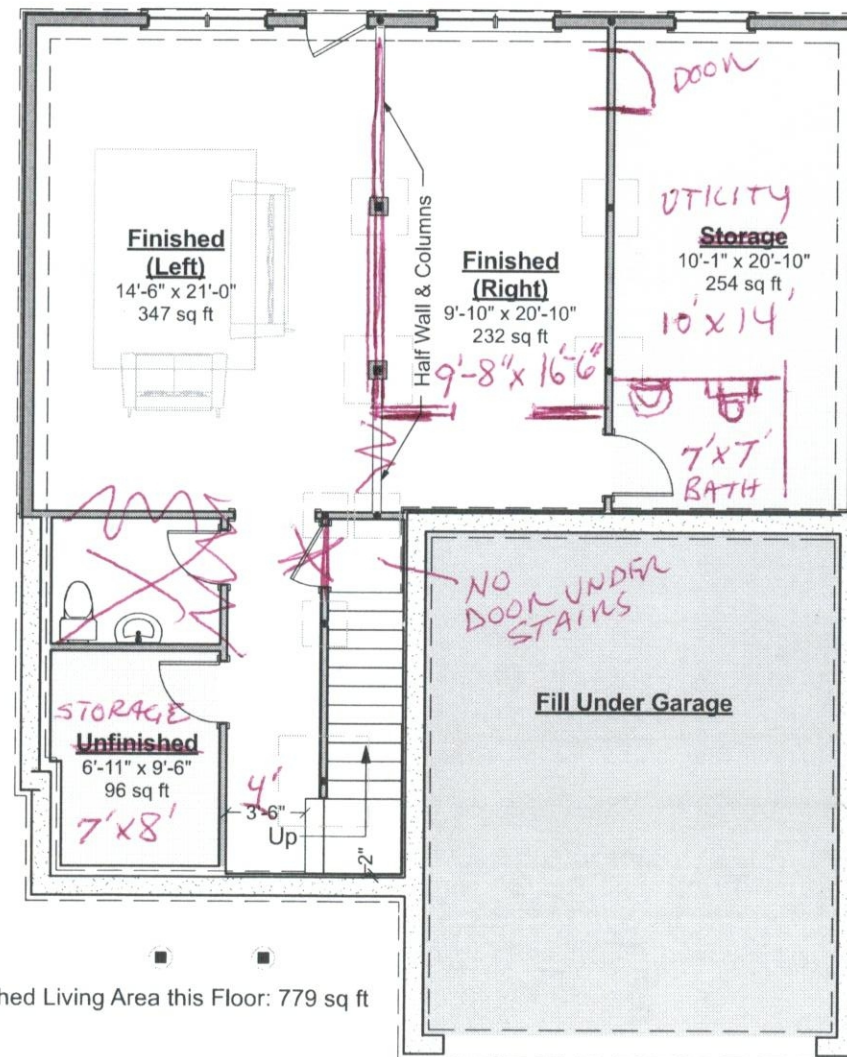

Finished Living Area this Floor: 779 sq ft

Foundation Plan