

5/15/2019


Caleb Classic with Wing

591.127.v11 KR

© 2013-2019 Art Form Architecture, Inc., all rights reserved .
You may not build this design without purchasing a license,
even if you make changes. This design may have geographic
restrictions.



603-431-9559

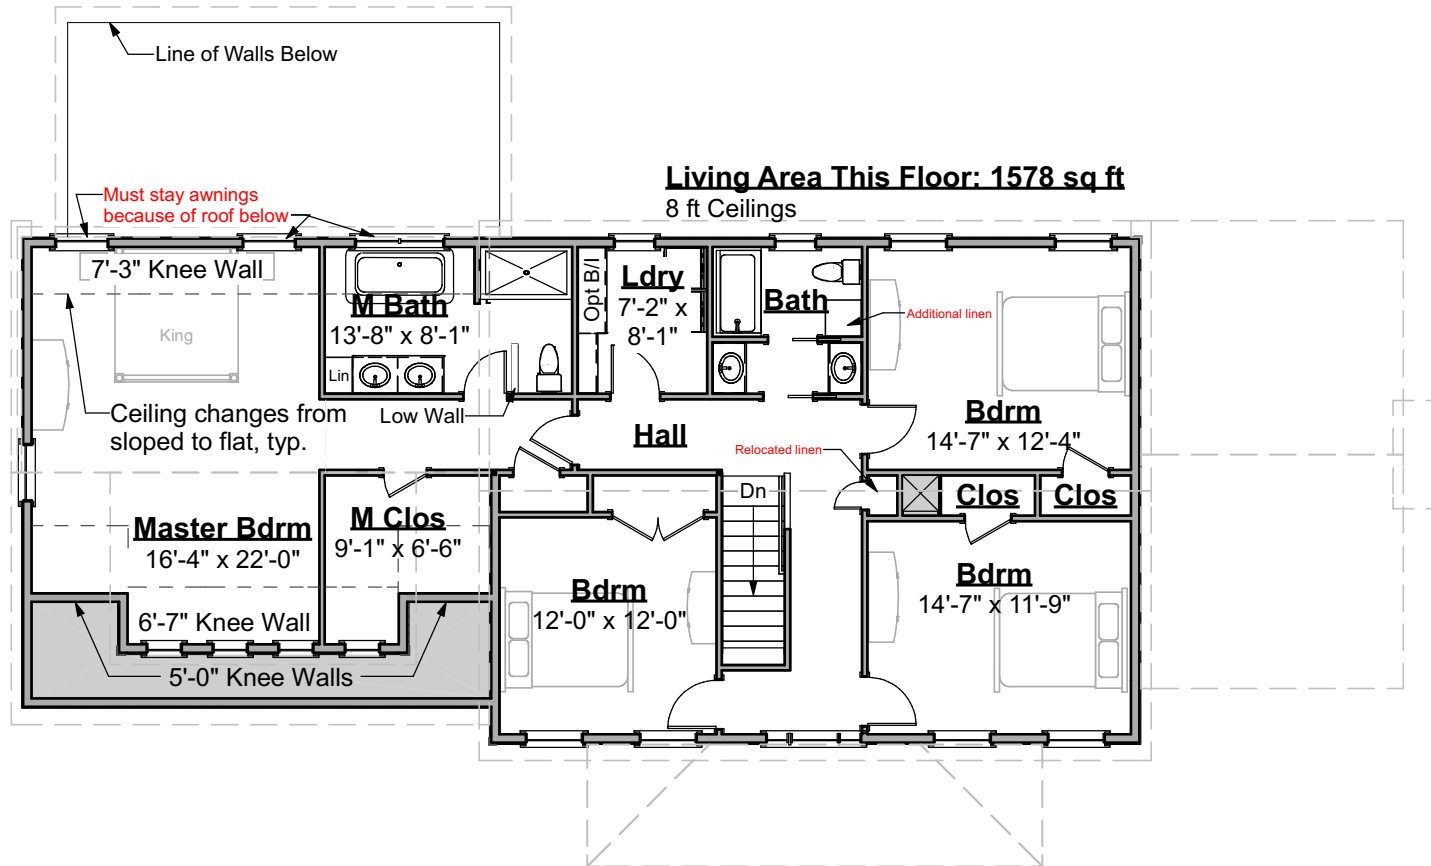

Second Floor Plan

Scale: 3/32" = 1'-0"