


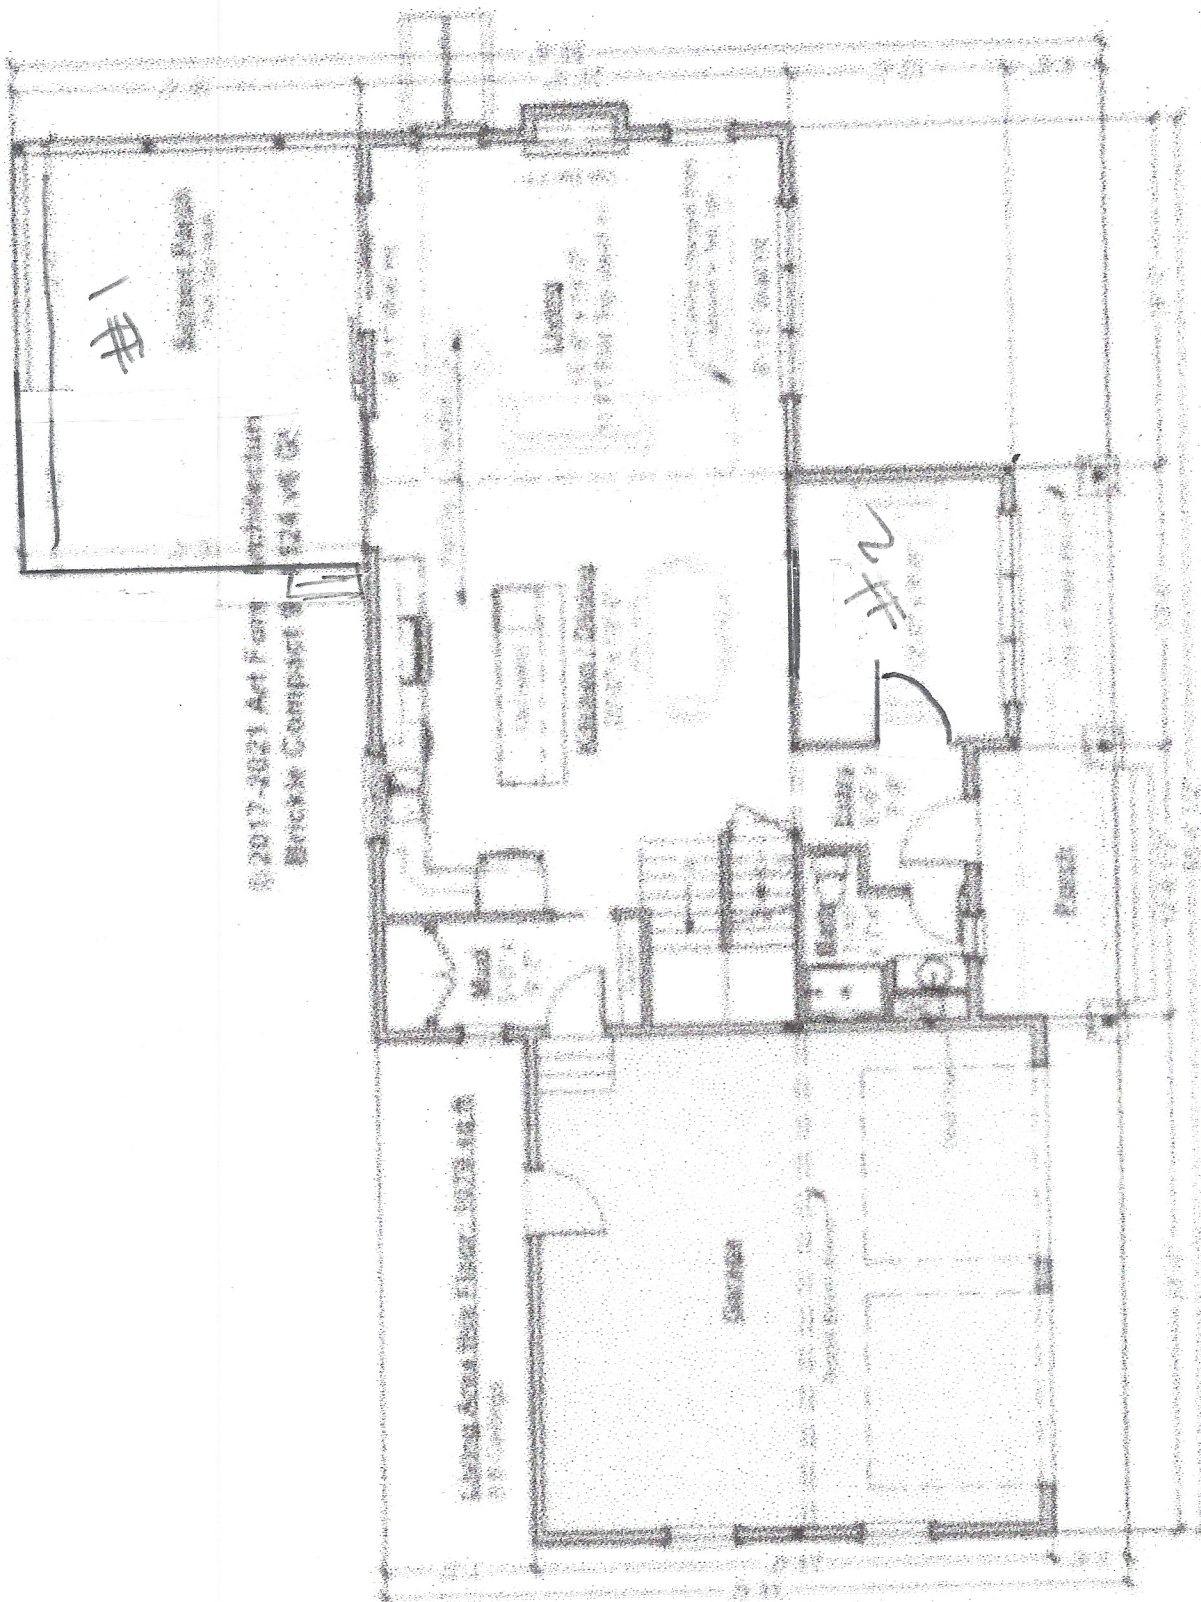

Current Living Area 1342 Sq. Ft.

2017-2021 Air Force Architecture Inc.
Brooks Complex 301 114th St.

1342 Sq. Ft.

1342 Sq. Ft.

1342 Sq. Ft.

1342 Sq. Ft.

33

900
551/4

