


Butterscotch

430.122.v2 SL

© 2011-2015 Wendy Welton, all rights reserved. You may not build this design without purchasing a license, even if you make changes. This design may have geographic restrictions.

Artform Home Plans

603-431-9559

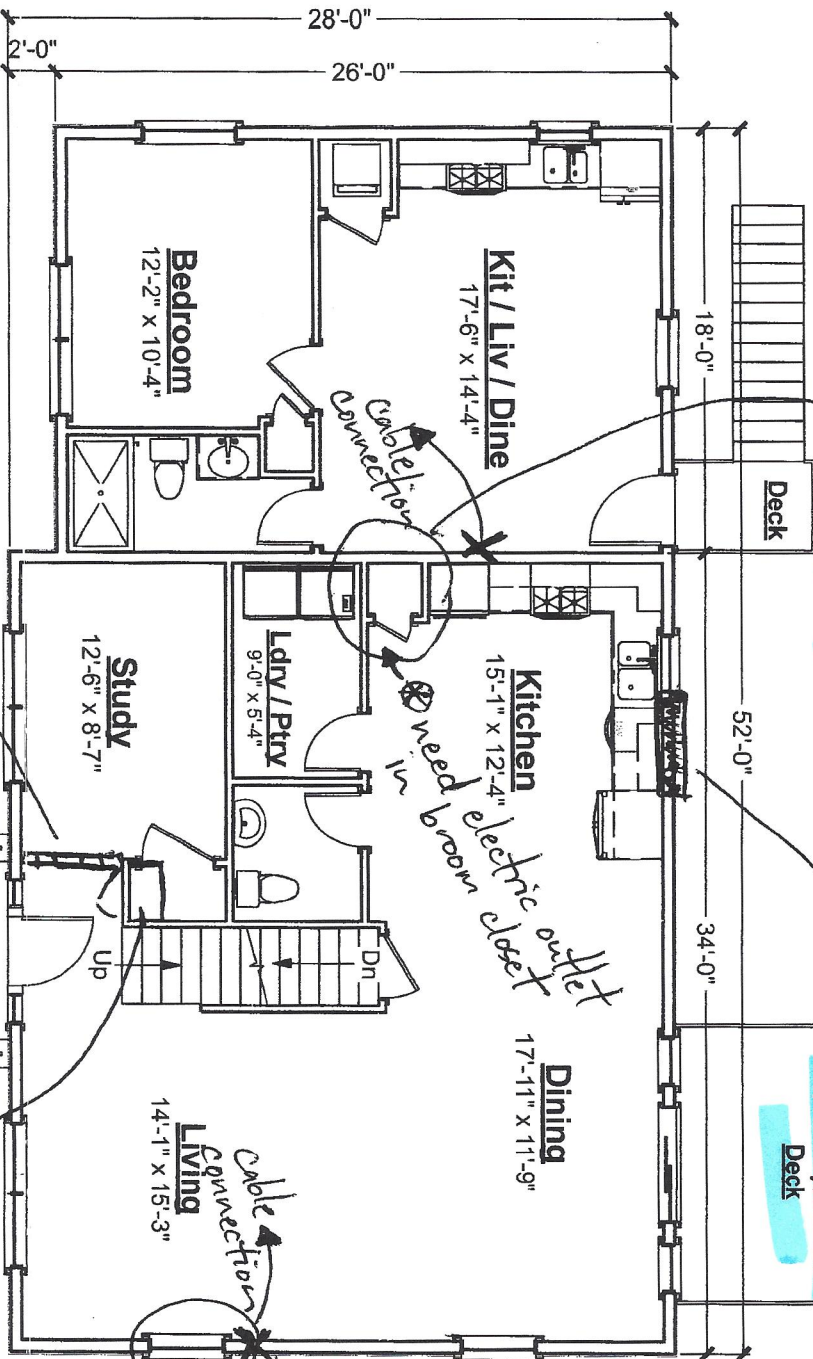

proper size ensure door is framed behind drywall for potential pass through to in-law suite

we would prefer a little larger window shifted further from corner

remove small window and living room and dining room window

use portion of study to create small closet for guests

First Floor Plan


Butterscotch

430.122.V2 SL

© 2011-2015 Wendy Welton, all rights reserved. You may not build this design without purchasing a license, even if you make changes. This design may have geographic restrictions.

Artform Home Plans

603-431-9559

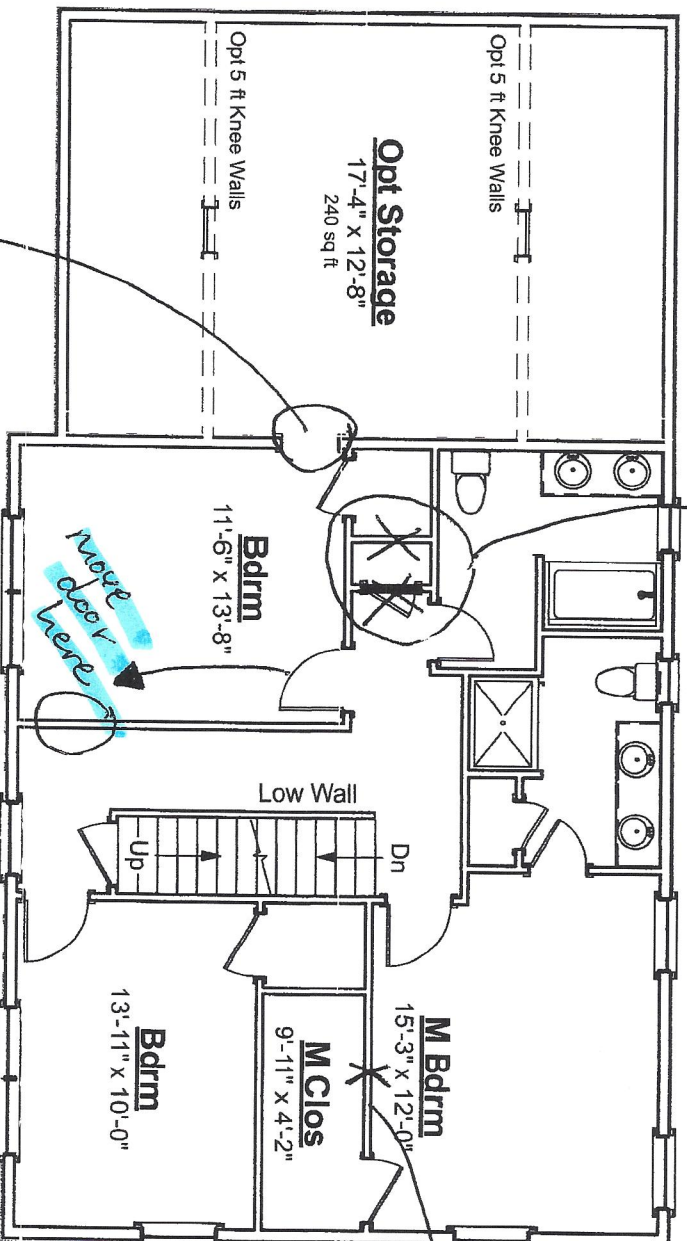


Second Floor Plan

Butterscotch


430.122.V2 SL

© 2011-2015 Wendy Welton, all rights reserved. You may not build this design without purchasing a license, even if you make changes. This design may have geographic restrictions.

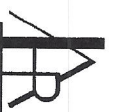 Artform Home Plans

603-431-9559

* where will mechanicals be placed?

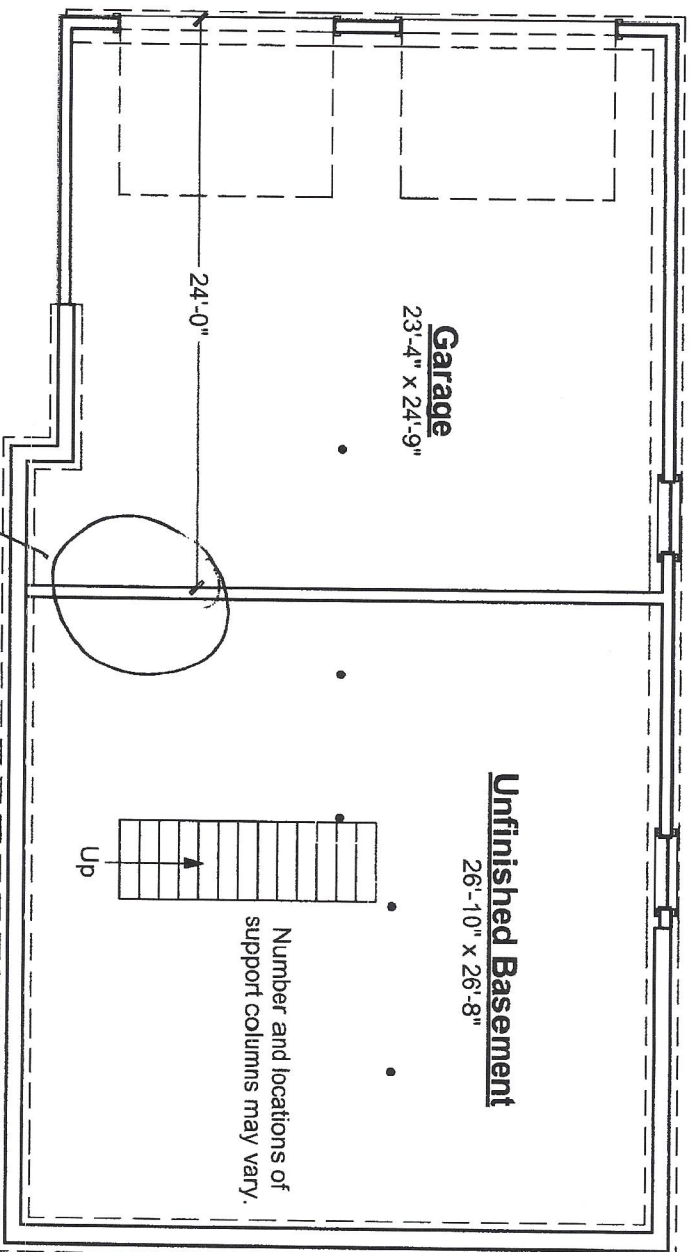

Foundation Plan

Butterscotch

430.122.V2 SL

© 2011-2015 Wendy Welton, all rights reserved. You may not build this design without purchasing a license, even if you make changes. This design may have geographic restrictions.



603-431-9559

Third Floor Plan

