

Houdini at the Beach (Houston Residence)

First Floor

Living Area - First Floor: 1062 SF

PATIO

Patio, Deck Above

ADD FIREPLACE

Family / Rec
26'-6" x 23'-3"

NEW UTILITY SPACE

Mud
10'-2" x 8'-6"

Elev
5'-1" x
5'-7"

UTILITY

Bath
10'-2" x 5'-0"

Entry
7'-5" x 5'-6"


ADD DOOR

Garage

28'-0" x 26'-0"

26'-0"

Porch

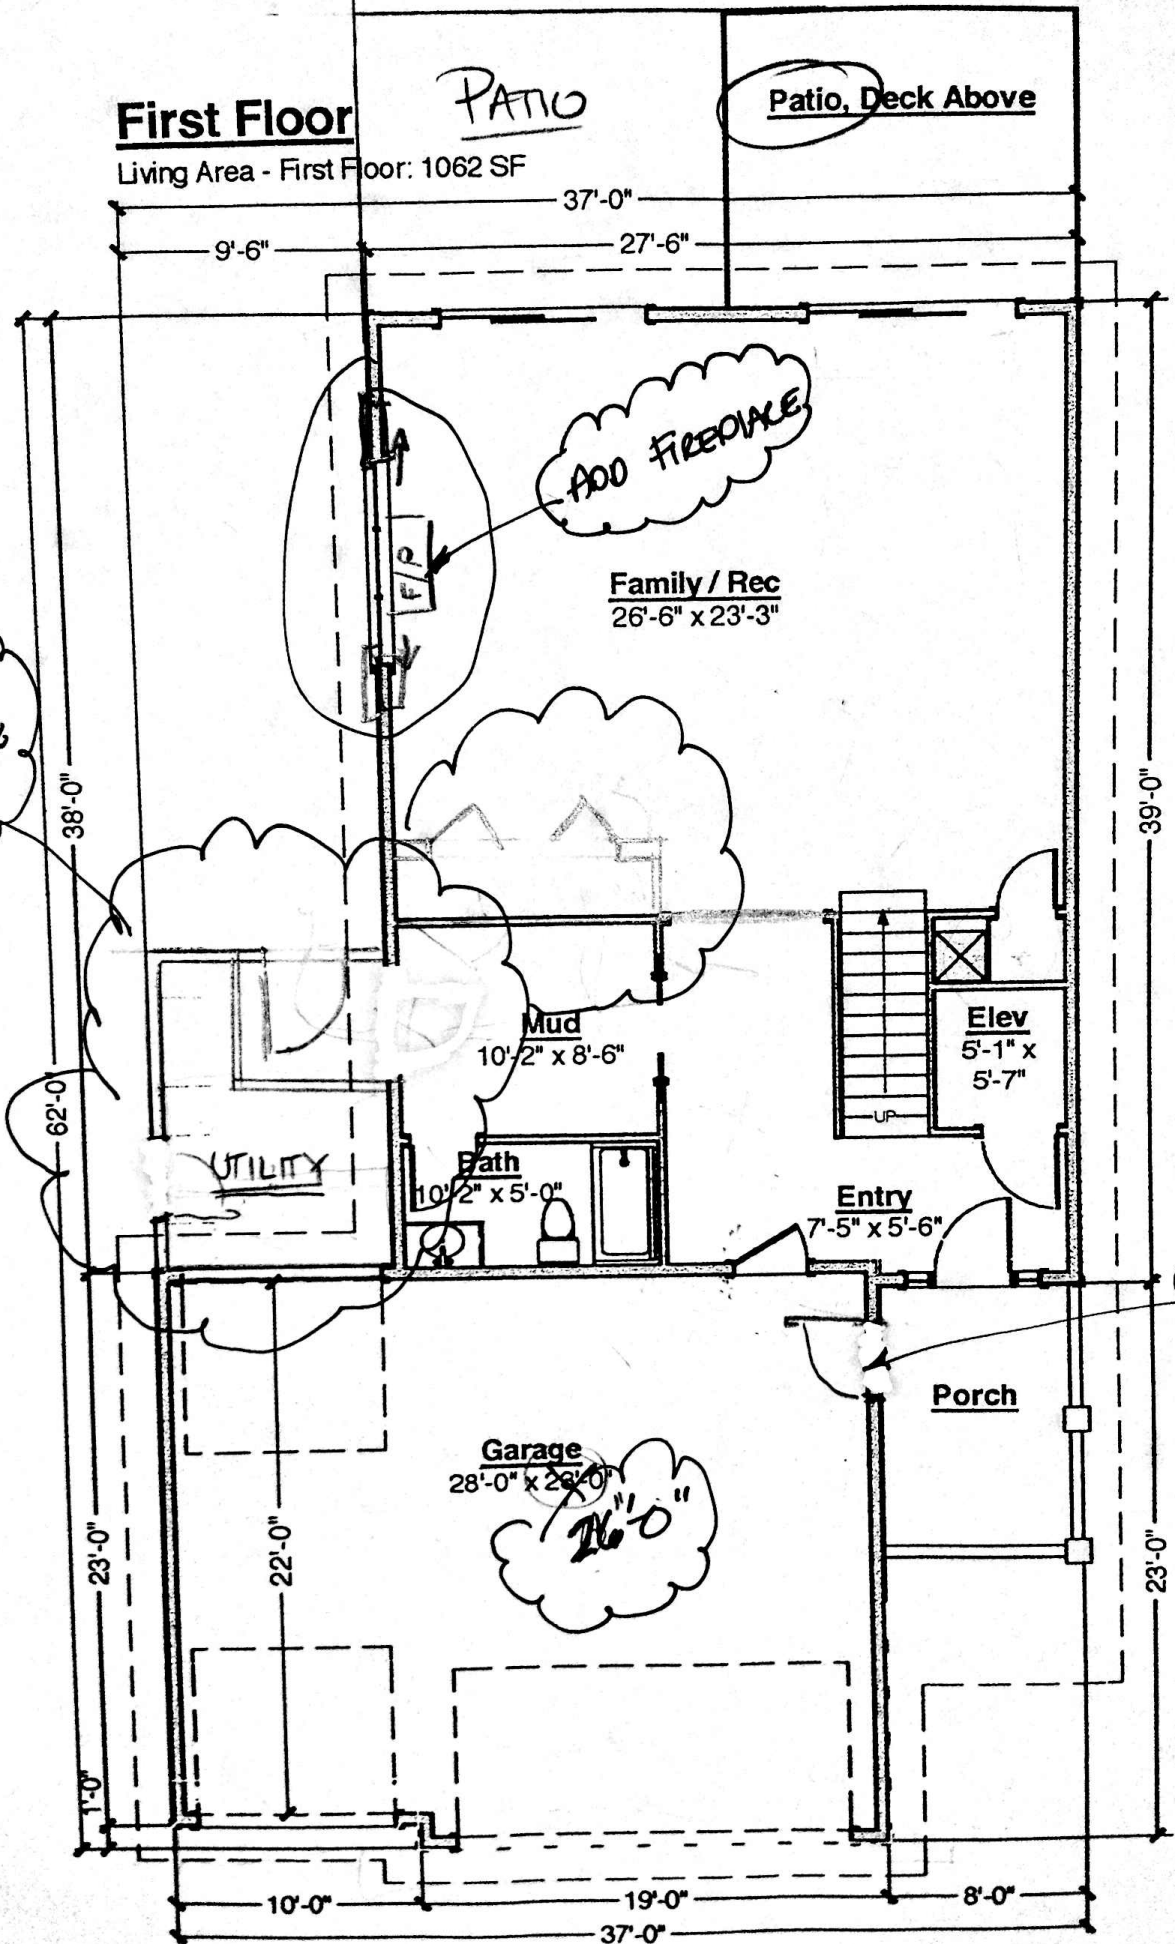

1ce)

this design without purchasing a license, even if you make changes. This design may have geographic restrictions.

Second Floor

Living Area - Second Floor: 1718 SF

Porch

FULL DECK

Whirlpool

84" Vanity

TRUE SHOWER

M Bdrm
17'-4" x 17'-10"

M Bath

8'-10" x 6'-11"

Shwr

5'-4" x 6'-4"

Closet

Elev

5'-1" x 5'-7"

DECK

Bath

9'-2" x 5'-0"

Clos

Bedroom

12'-6" x 11'-9"

Deck

Bedroom

15'-5" x 11'-3"

Clos

Clos

Deck

Bath

5'-0" x 8'-4"

Bath

7'-8" x 8'-4"

Bedroom

14'-7" x 11'-4"

ADD 1'-6"

ADD 1'-6"

Room for Bed & Bath

WALKIN FOR MASTER

Third Floor

Living Area - Third Floor: 1295 SF

Deck

Full Deck

3'0"

SWAP

Living
26'-6" x 17'-1"

Office Work
Space

Bath
5'-1" x 8'-2"

Elev
5'-1" x
5'-7"

Kitchen
17'-6" x 20'-6"

Ptry
4'-0" x 4'-1"

Dining
18'-6" x 11'-1"

Deck

3'0"?