

April Yarrow

326.120.v2

© 2013 Art Form Architecture, Inc. All Rights Reserved . <http://www.artformhomeplans.com>

First Floor

Living Area: 898 SF


Bedrooms: 1

Bathrooms: 0.5

Ceiling Height Shown: 8'-0"

Ceiling Height Possible*: 8'-0"

* - Increasing ceiling height requires a Major Change.

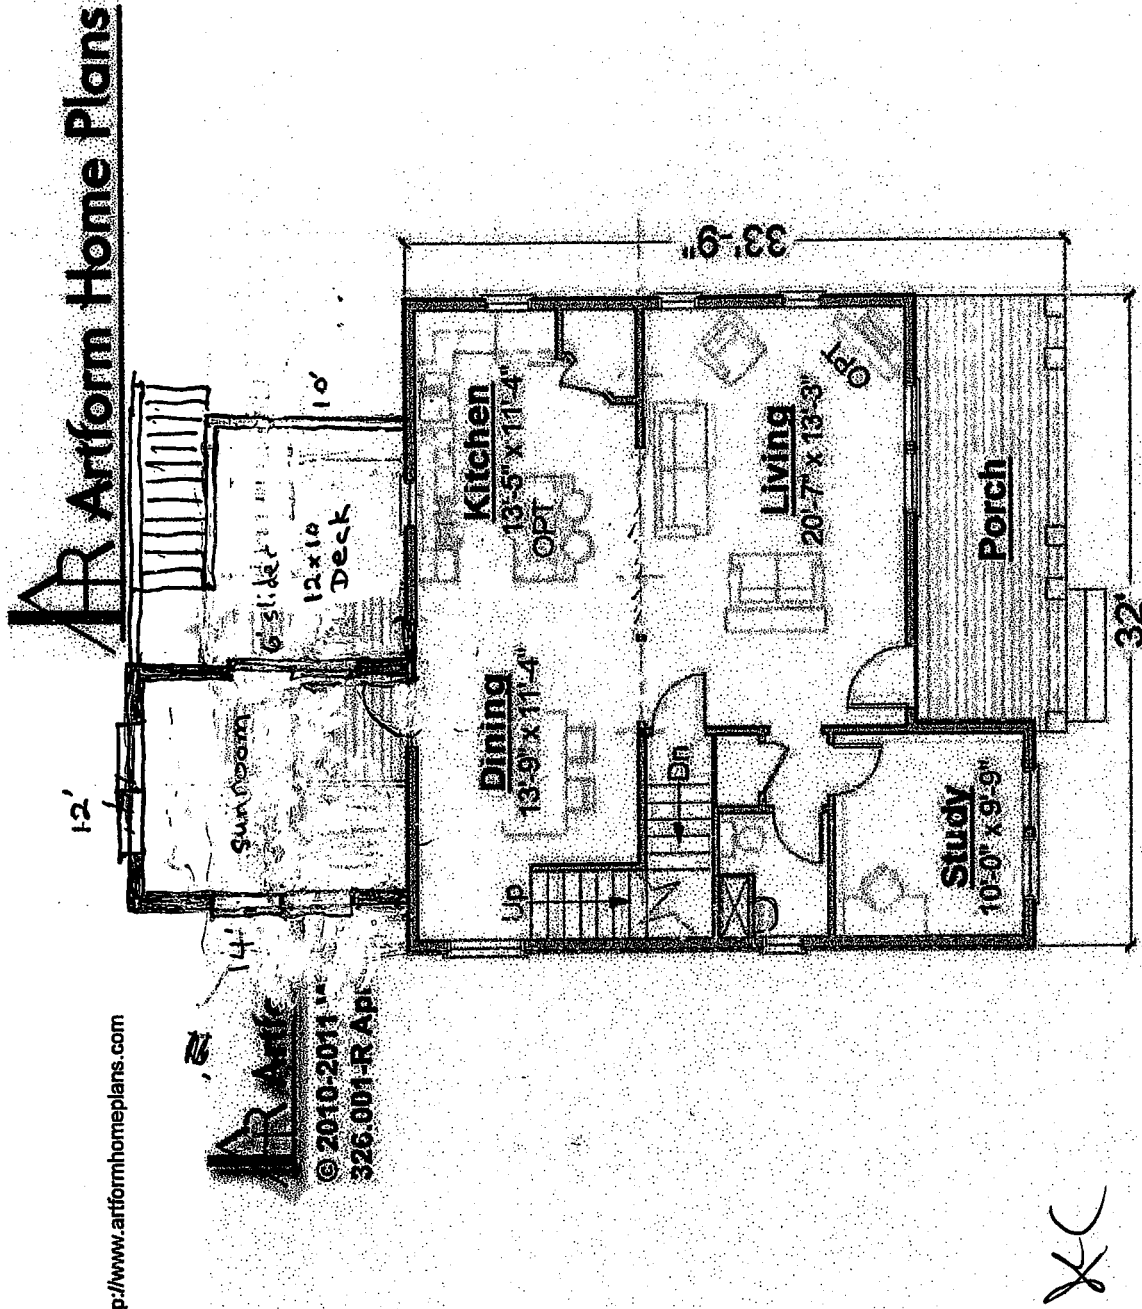

April Yarrow

326.120.V2

© 2013 Art Form Architecture, Inc. All Rights Reserved . <http://www.artformhomeplans.com>

Second Floor

Living Area: 986 SF

Bedrooms: 3

Bathrooms: 2.0

Ceiling Height Shown: 8'-0"


Ceiling Height Possible*: 8'-0"

* - Increasing ceiling height requires a Major Change.



© 2010-2011 Wendy Welton
326.001-R April Yarrow

Handwritten note: "Handwritten note" with an arrow pointing to a room.

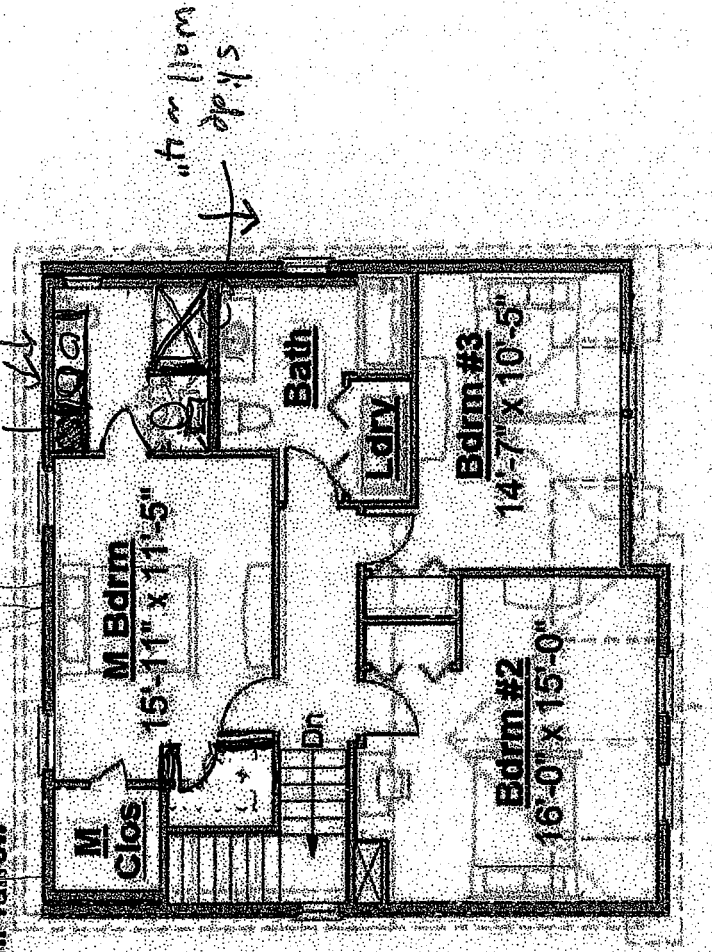

April Yarrow

326.120.v2

© 2013 Art Form Architecture, Inc. All Rights Reserved . <http://www.artformhomeplans.com>

Basement Floor

Living Area: 150 SF


Bedrooms: 0

Bathrooms: 0.0

Ceiling Height Shown: 8'-0"



Ceiling Height Possible*: 8'-0"

* -- Increasing ceiling height requires a Major Change.

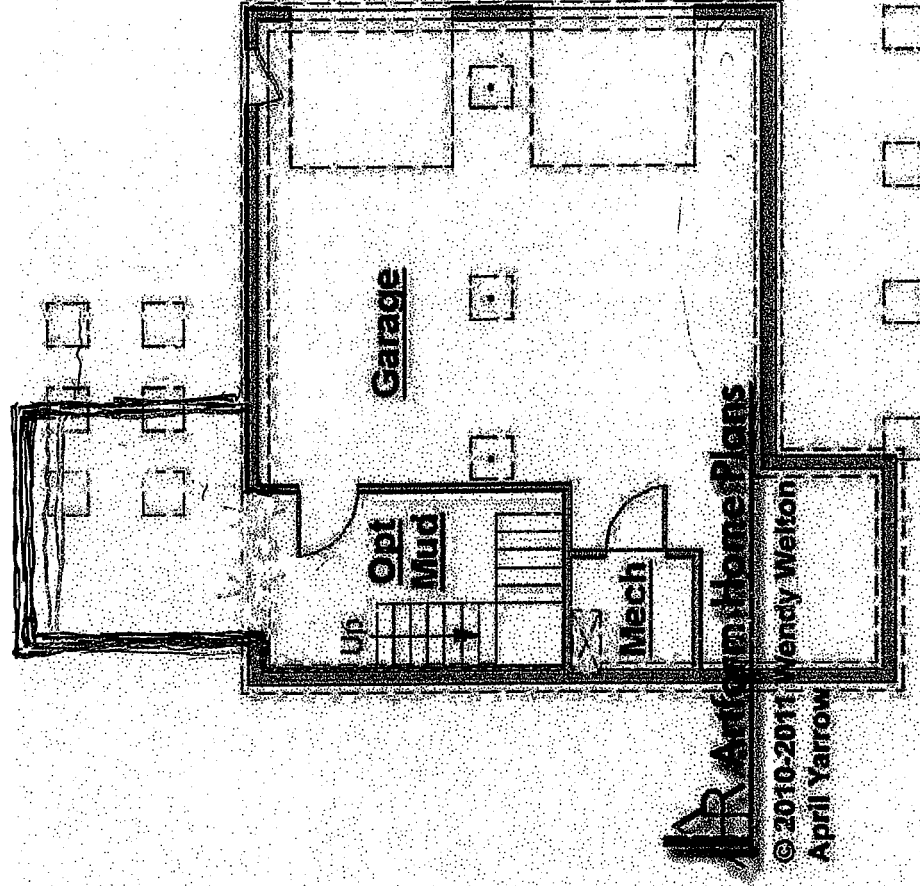

© 2010-2011 Wendy Walton
April Yarrow

XC

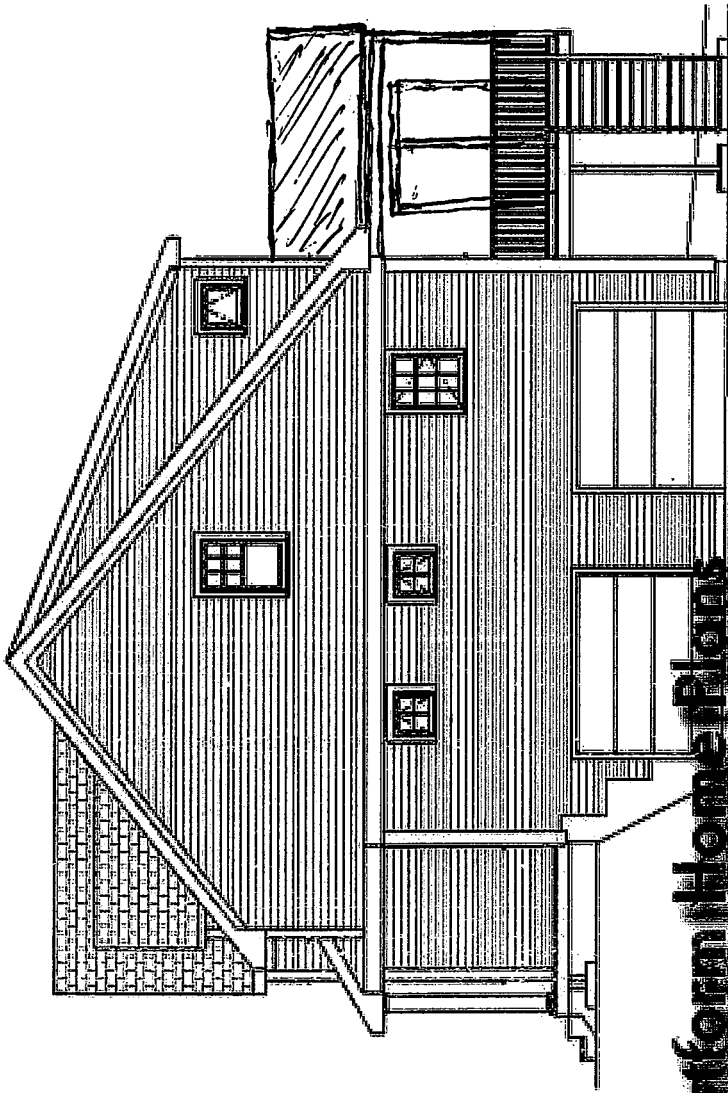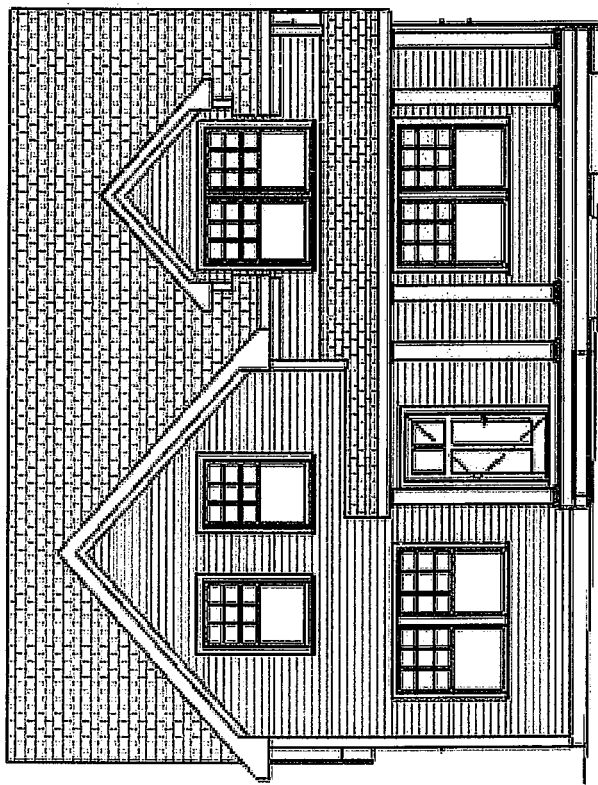

AR Antform Home Plans

© 2010 Wendy Welton
326-001-R April Yarrow

