

Flip
Plan

Bonnie Ranch

679.124.v29 GR

© 2014-2019 Art Form Architecture, Inc., all rights reserved.
You may not build this design without purchasing a license,
even if you make changes. This design may have geographic
restrictions.

Artform Home Plans

803-431-9559

LEADS
per plan
more linen


3'
ADD Freestanding
Tub
SEE NEW
LAYOUT

XC

09/31/20
6:27 PM EDT
desktop verified


09/31/20
6:30 PM EDT
desktop verified

change
door
swing

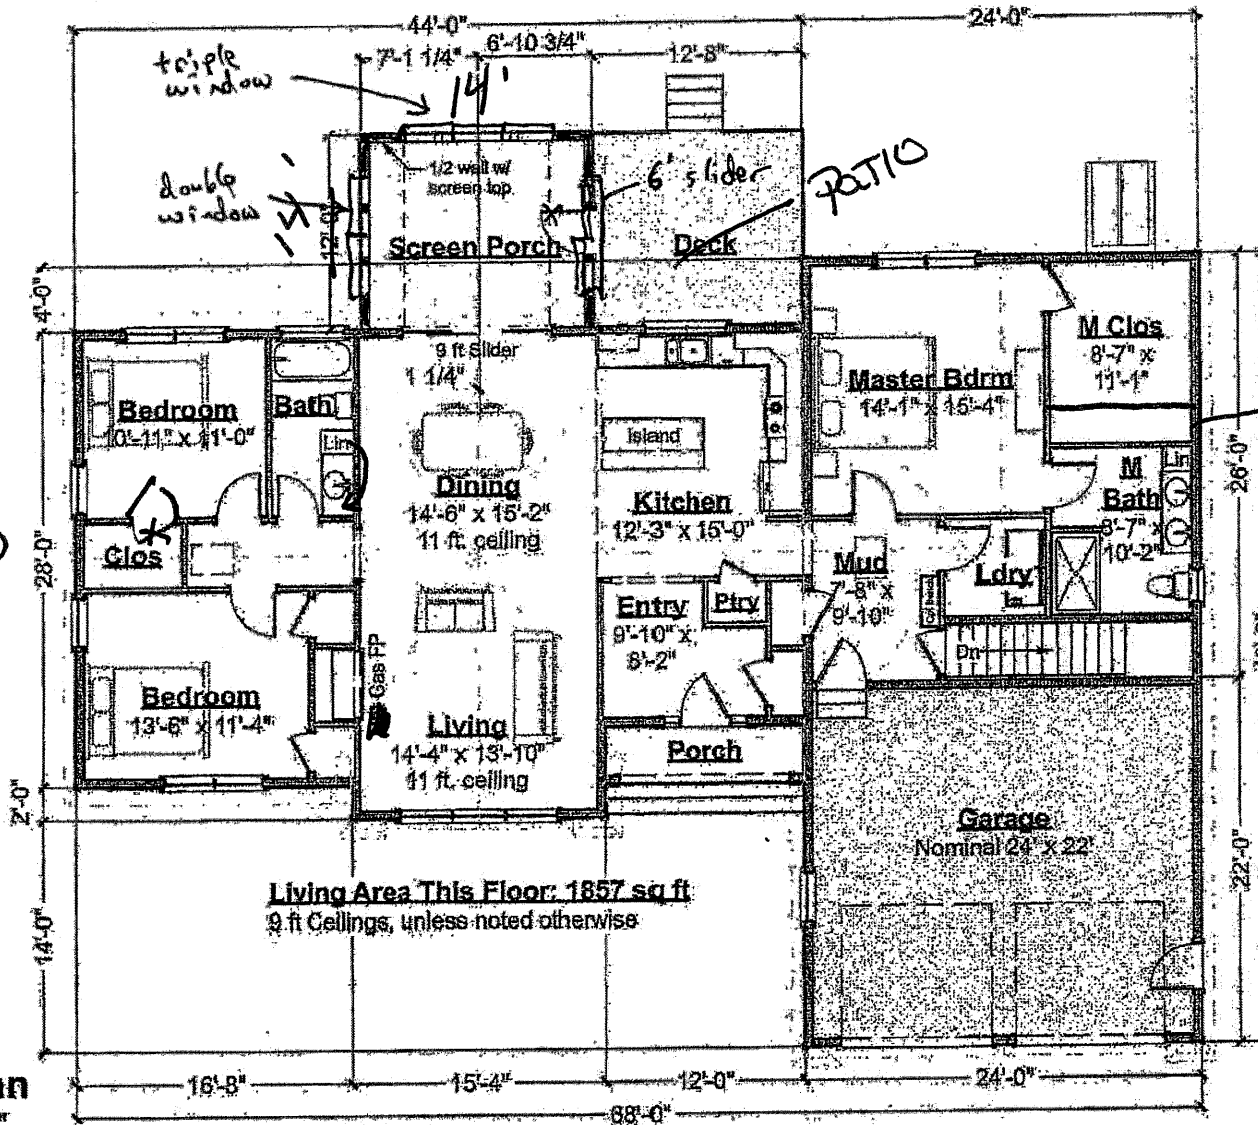

First Floor Plan

Scale: 3/32" = 1'-0"

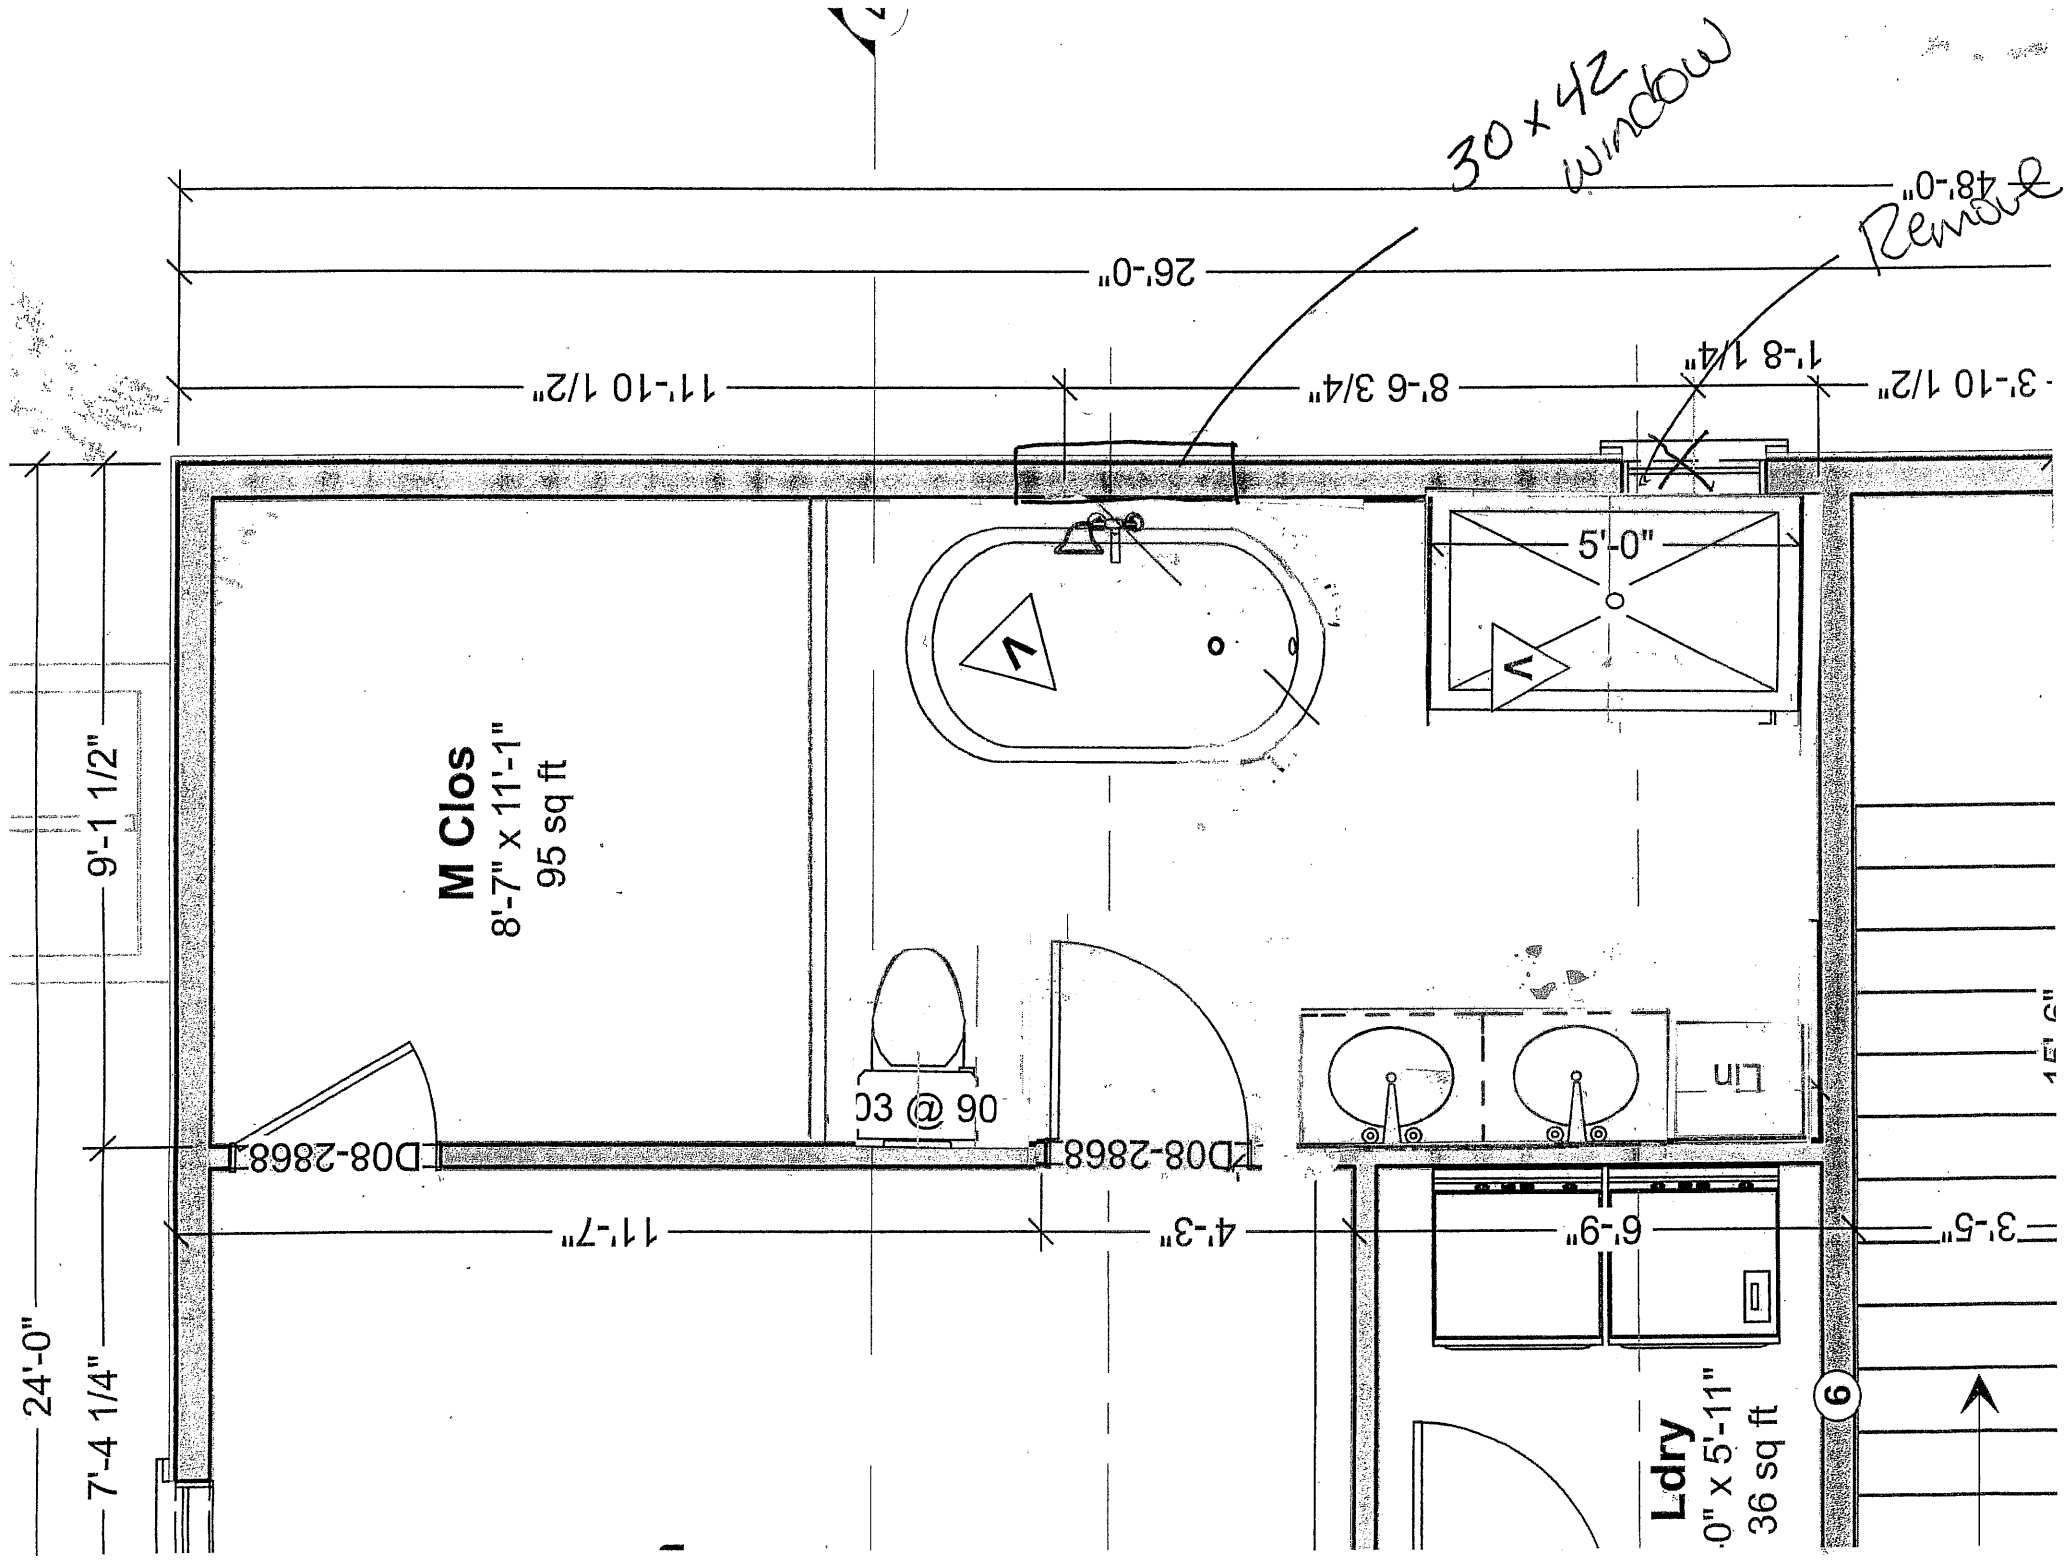

Bonnie Ranch

679.124.V29 GR


© 2014-2019 Art Form Architecture, Inc., all rights reserved.
You may not build this design without purchasing a license,
even if you make changes. This design may have geographic
restrictions.

Artform Home Plans

803-431-9559

AM
05/17/20
6:56 PM EDT
desktop verified

AM
05/17/20
6:56 PM EDT
desktop verified

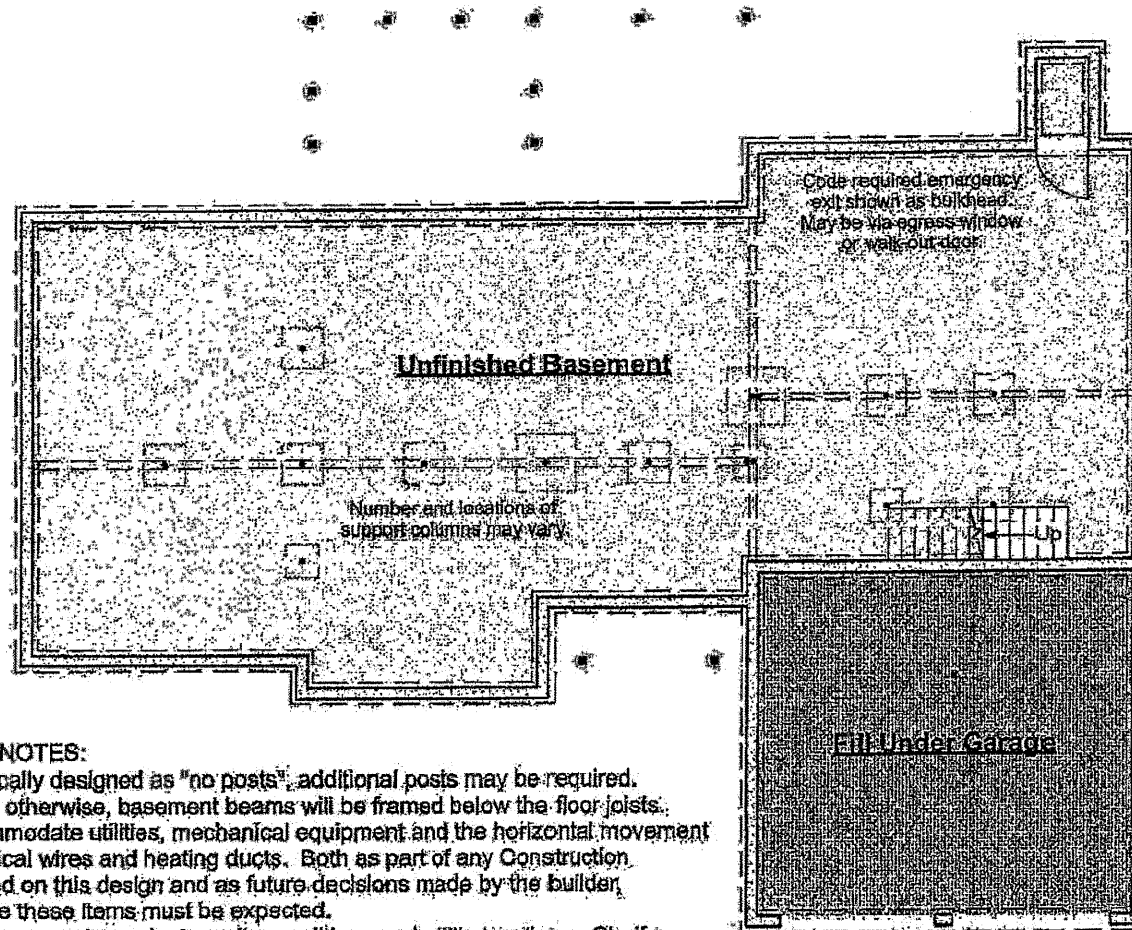

IMPORTANT BASEMENT NOTES:

- Unless an area is specifically designed as "no posts", additional posts may be required.
- Unless specifically noted otherwise, basement beams will be framed below the floor joists.
- Basement spaces accommodate utilities, mechanical equipment and the horizontal movement of plumbing pipes, electrical wires and heating ducts. Both as part of any Construction Drawings produced based on this design and as future decisions made by the builder, changes to accommodate these items must be expected.
- Basement window locations are dependent on site conditions and utility locations. Clarify number and location with your builder.

Foundation Plan

Scale: 3/32" = 1'-0"