

# Laughing Sea Tiger

623.120.v2 ER

© 2013-2019 Artform Architecture, all rights reserved. You may not build this design without purchasing a license, even if you make changes. This design may have geographic restrictions.


**Artform Home Plans**

603-431-9559

EXTEND  
DECK  
TO  
END -  
move STAIRS

REMOVE  
F/P

RB

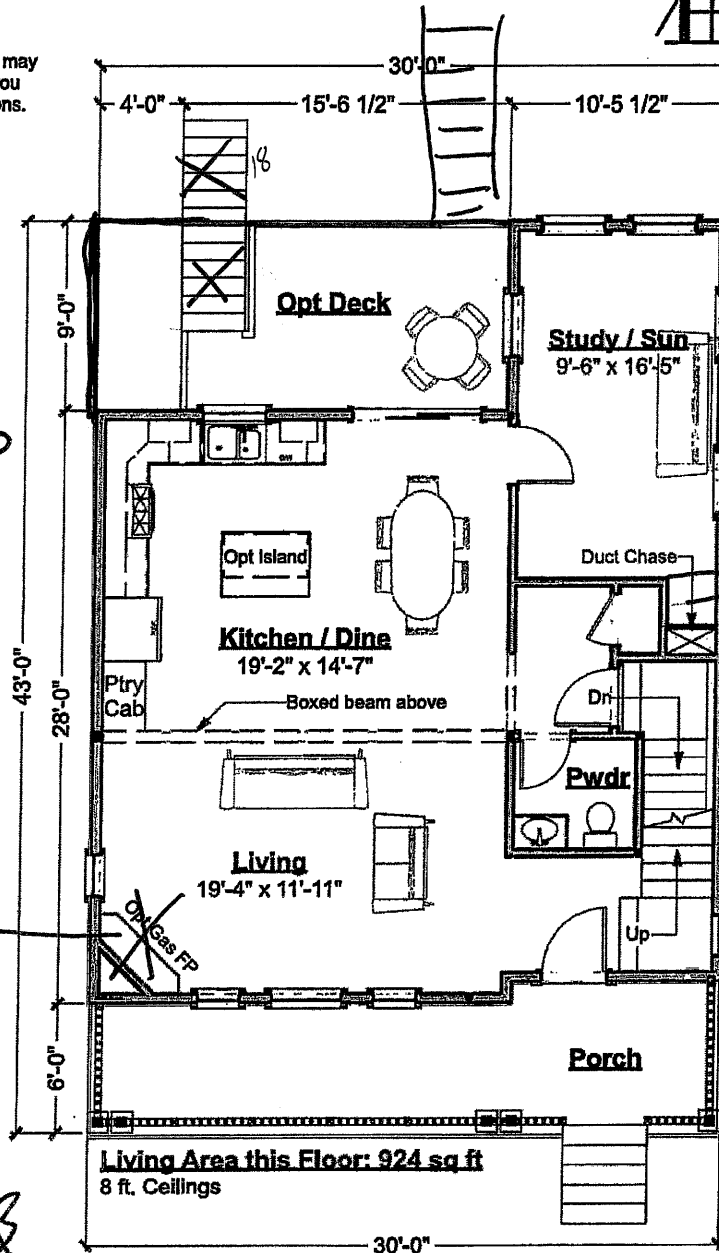

**First Floor Plan**

Scale: 1/8" = 1'-0"