

Flip plan


Raspberry Crisp

565.144.v53 GL

© 2013-2020 Art Form Architecture, Inc.
all rights reserved. You may not build this
design without purchasing a license, even
if you make changes. This design may
have geographic restrictions.

Artform Home Plans

603-431-9559

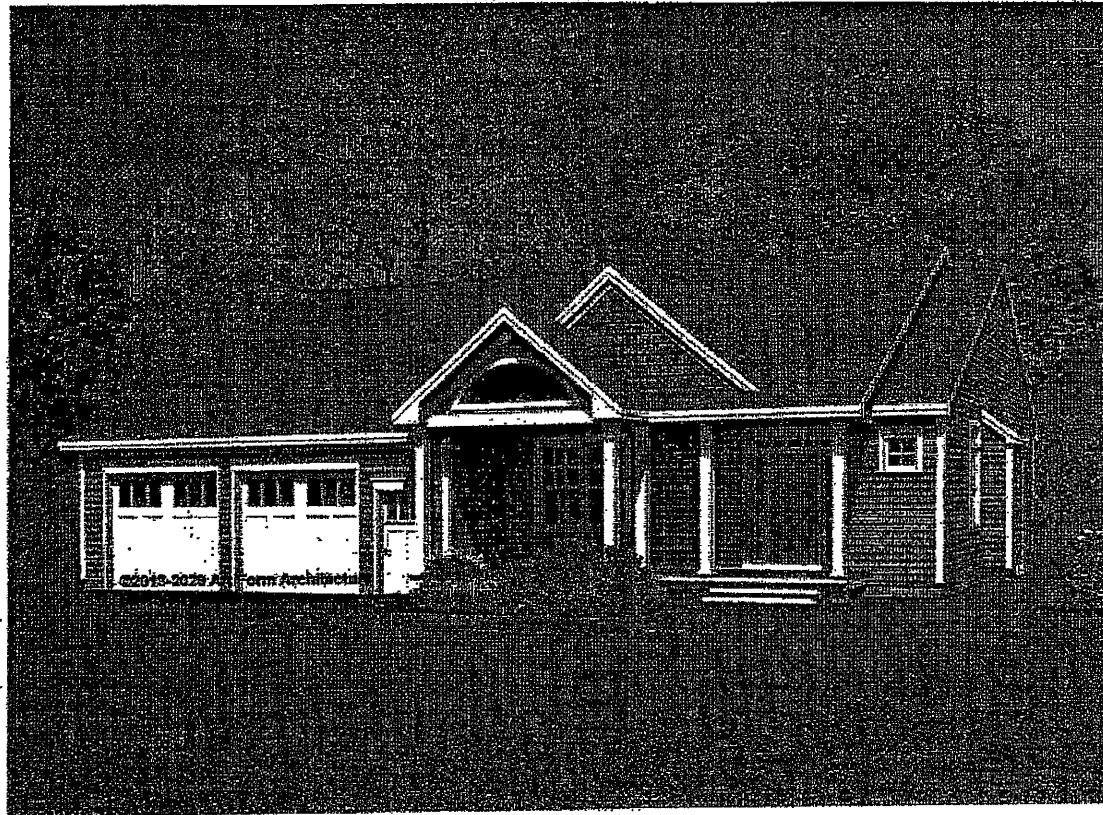

Some items shown are optional and/or may vary. Builder's written specifications always govern.

1. Gas fireplace and its surround or mantel
2. Kitchen - island, cabinet style & trim, countertop material, etc.
3. Door styles and trim
4. Window grilles and trim, window treatments
5. Stair balusters or low walls at stairs
6. Lighting
7. Material selections (flooring, siding, roofing, paint colors, etc.)
8. Other furnishings
9. Landscaping, paving and walkways
10. Gutters, shutters and other exterior trim components
11. Deck size, railing style, stair location, etc.
12. Amount of exposed basement and/or wood framed walls at basement.

These images are not of any specific building site. Sun and view through windows will vary, as will the site around the house on the exterior and the slope of the land.




Raspberry Crisp

565.144.v53 GL

© 2013-2020 Art Form Architecture, Inc.,
all rights reserved. You may not build this
design without purchasing a license, even
if you make changes. This design may
have geographic restrictions.

Artform Home Plans

603-431-9559

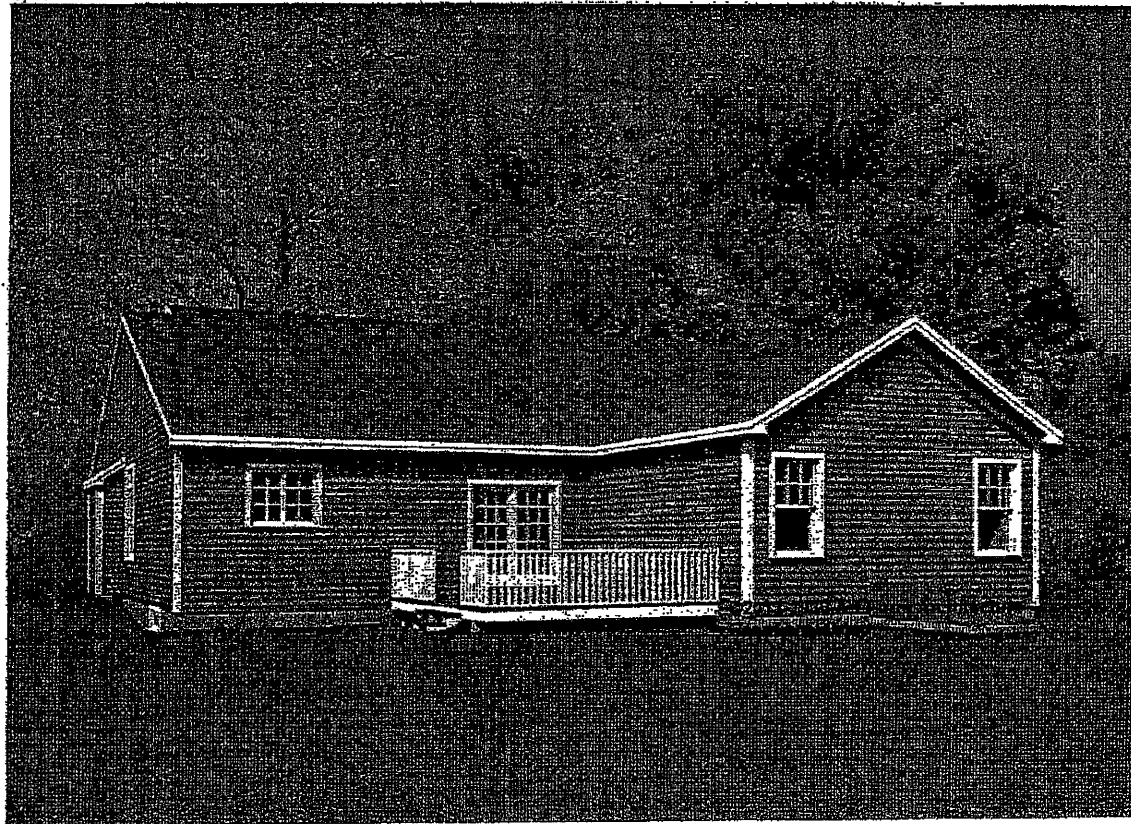

KC



Raspberry Crisp

565.144.v53 GL

© 2013-2020 Art Form Architecture, Inc.,
all rights reserved. You may not build this
design without purchasing a license, even
if you make changes. This design may
have geographic restrictions.


ADD 3'
TO MASTER



Artform Home Plans

603-431-9559

REMOVE
TRANSOM
ADD 2 LARGE windows
Longer
window

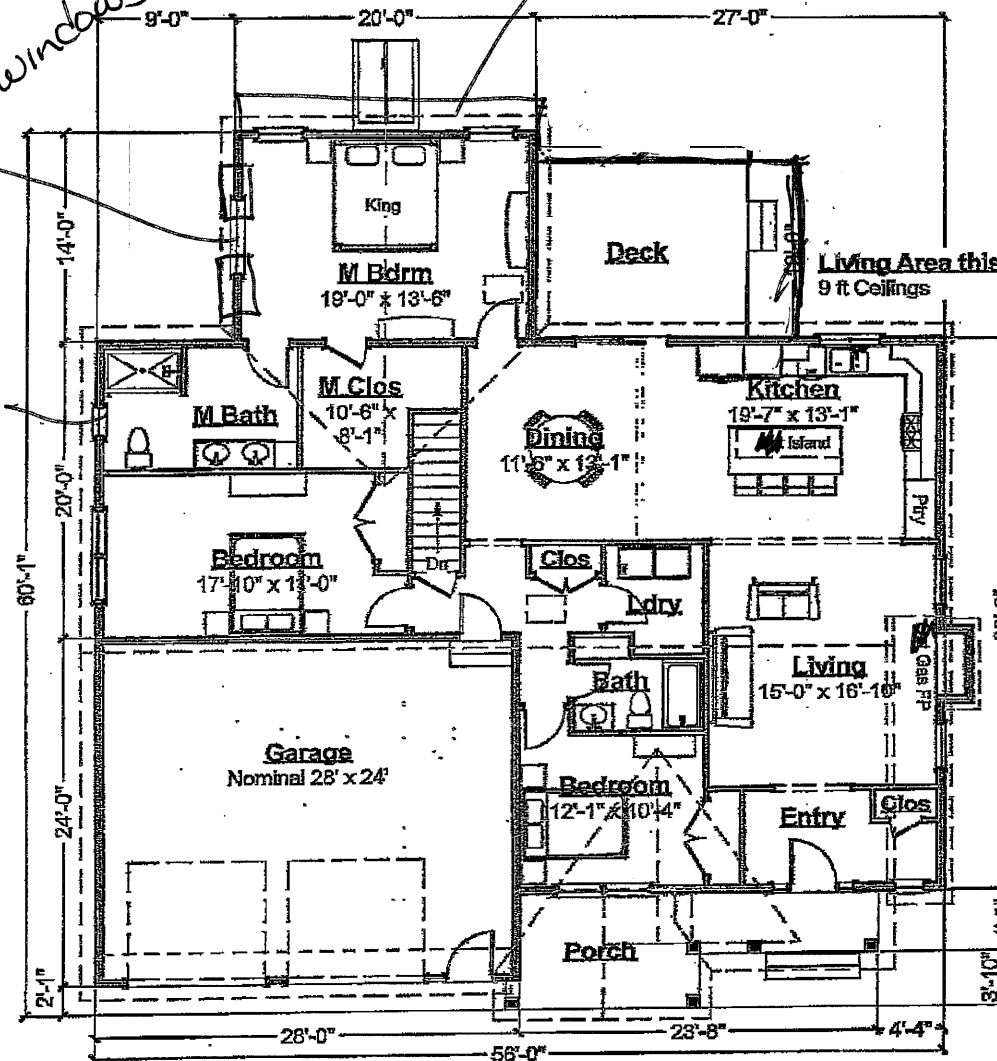

MB
7/18/2020
10:00 AM
10/18/2020

MB
7/18/2020
10:00 AM
10/18/2020

XC

First Floor Plan

Scale: 3/32" = 1'-0"

5/1/2020


Raspberry Crisp

565.144.v53 GL

© 2013-2020 Art Form Architecture, Inc.,
all rights reserved. You may not build this
design without purchasing a license, even
if you make changes. This design may
have geographic restrictions.

Artform Home Plans

603-431-9559

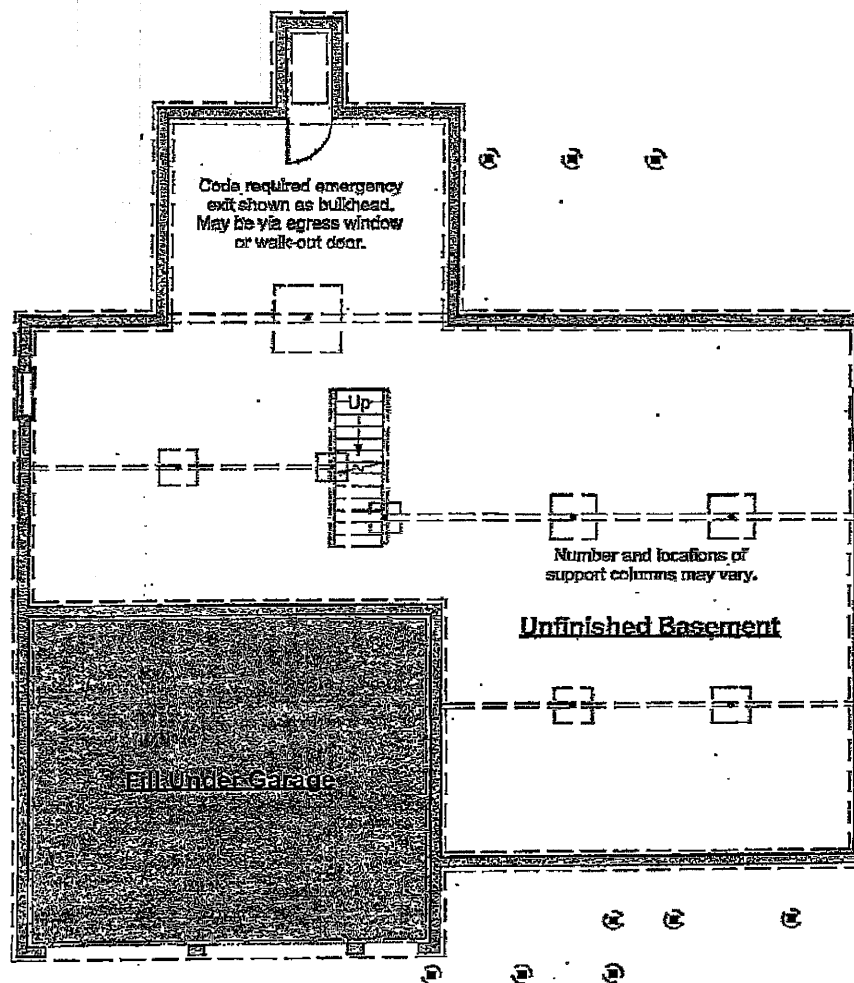

PRINTED ON RECYCLED PAPER
5/1/2020

PRINTED ON RECYCLED PAPER
5/1/2020

Handwritten signature

Foundation Plan

Scale: 3/32" = 1'-0"