

565.144.v53 GL


Flip plan

NO
DOORS
CASED
OPENING



Artform Home Plans


603-431-9559

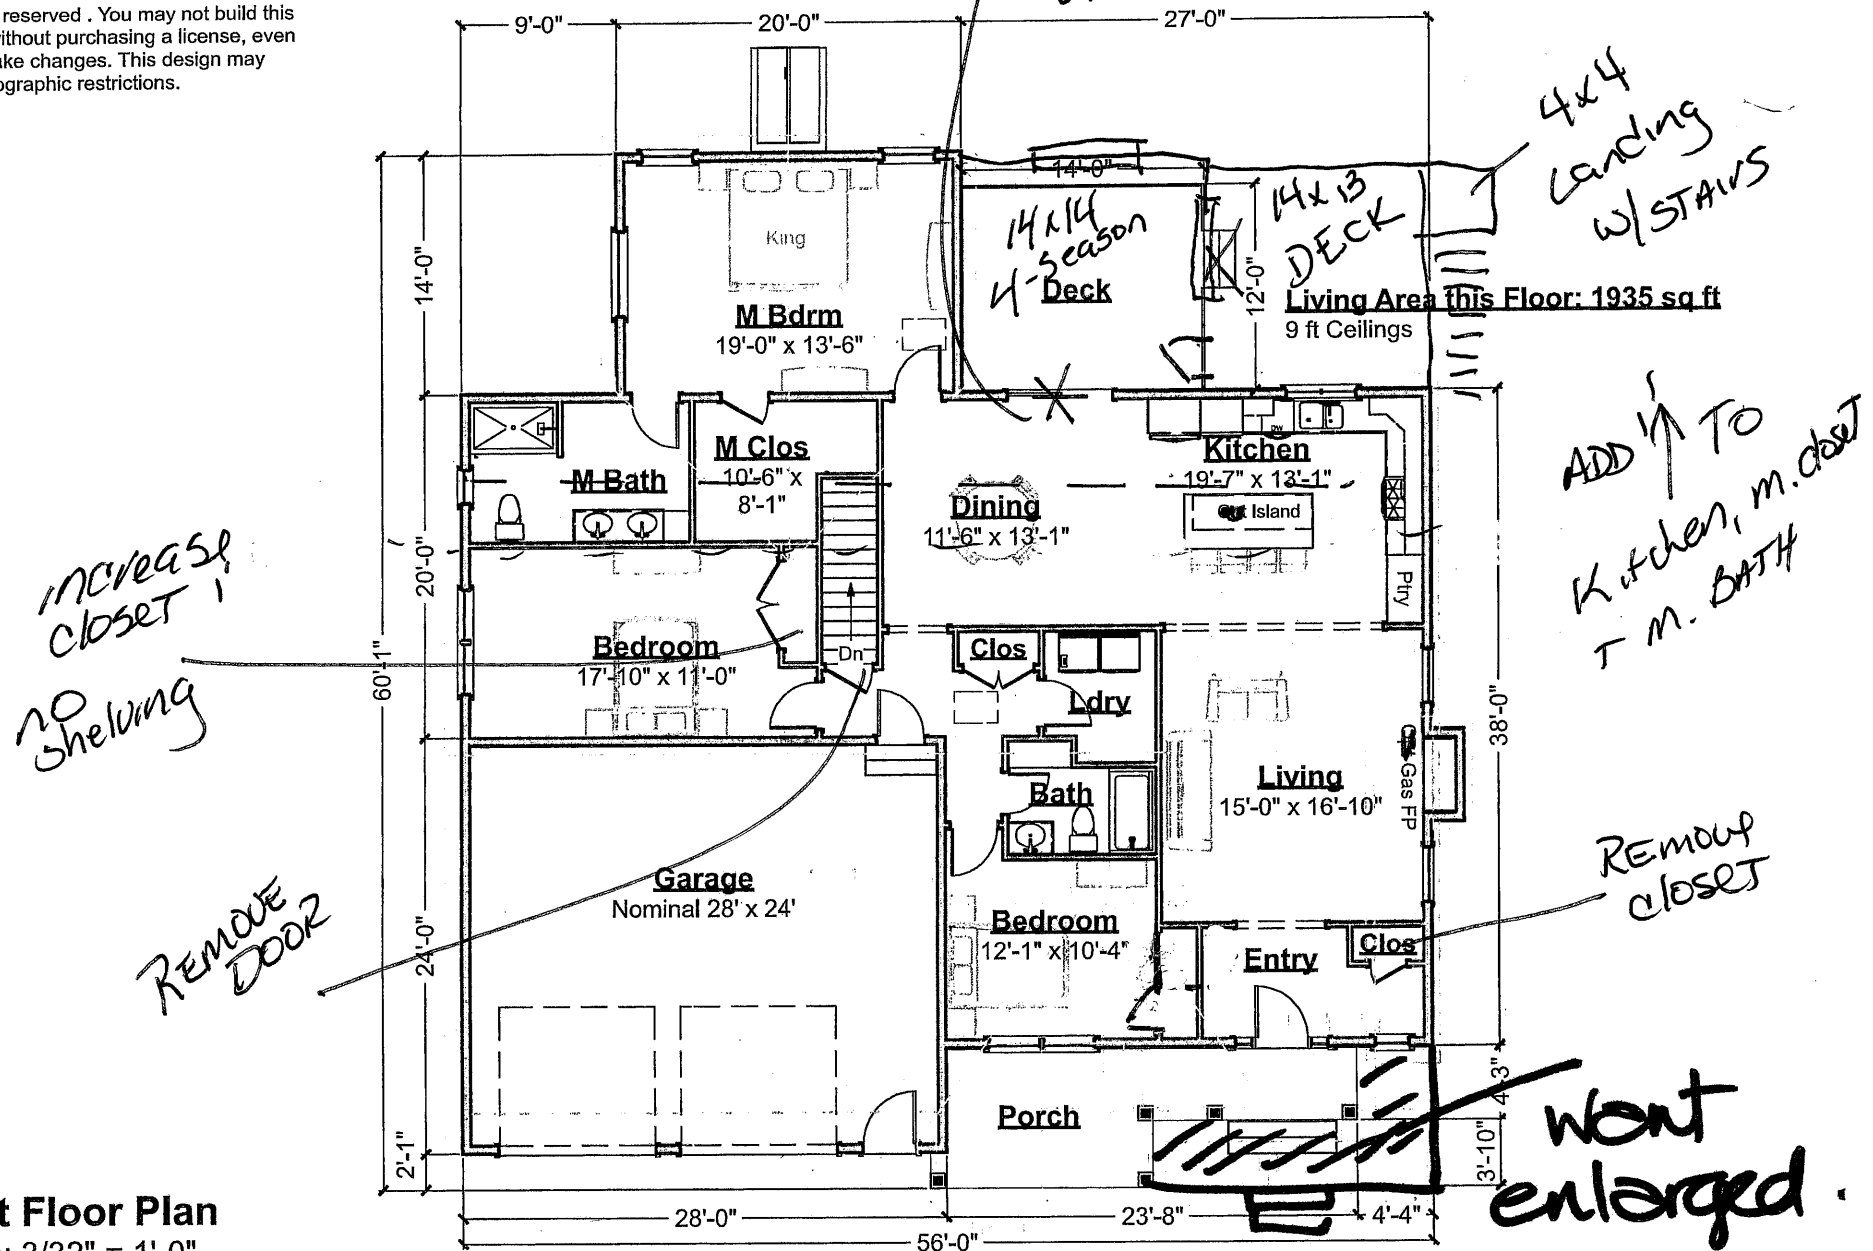

First Floor Plan

Scale: $\frac{3}{32}'' = 1'-0''$

Basement Plan - Rhoten Raspberry Crisp

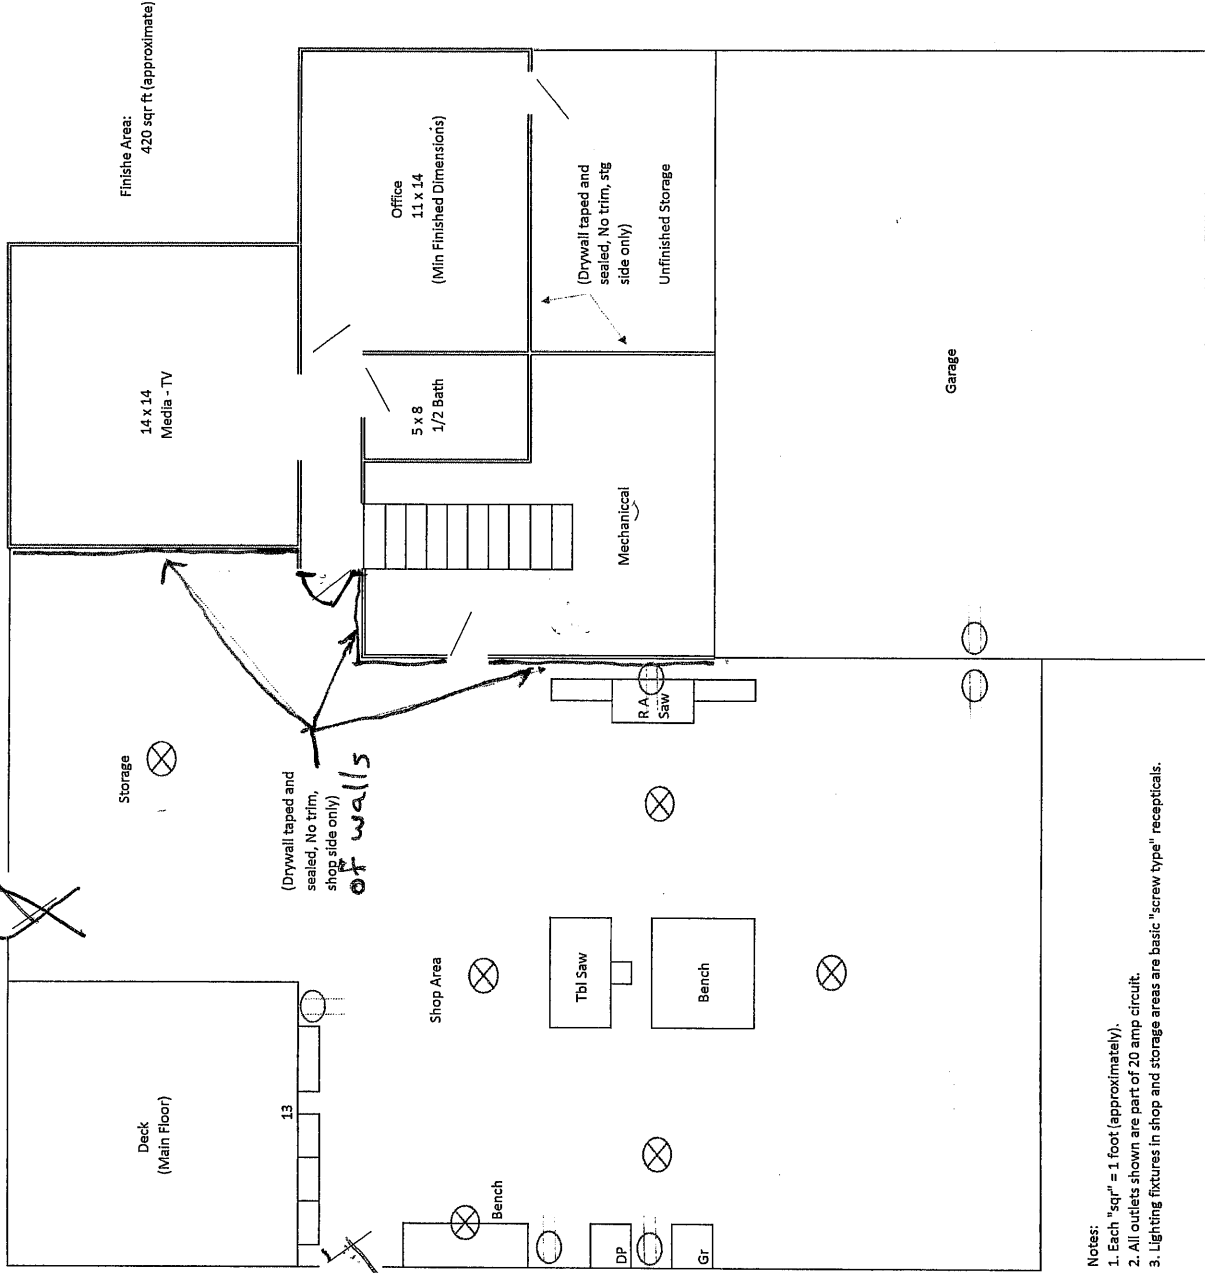

Want



↑
Shakes across
Front

Enlarged Front
Porch + Roof