


623.120.v5 ER Laughing Sea Tiger



Second Floor

	Area	Beds	Baths
Main	855 SF	3	2
Future	0 SF	0	0
Apt	0 SF	0	0
Total	855 SF	3	2
Ceiling Height			
Shown	8'-0"		
Possible*	8'-0"		

* See Major Change information on plan page for cost

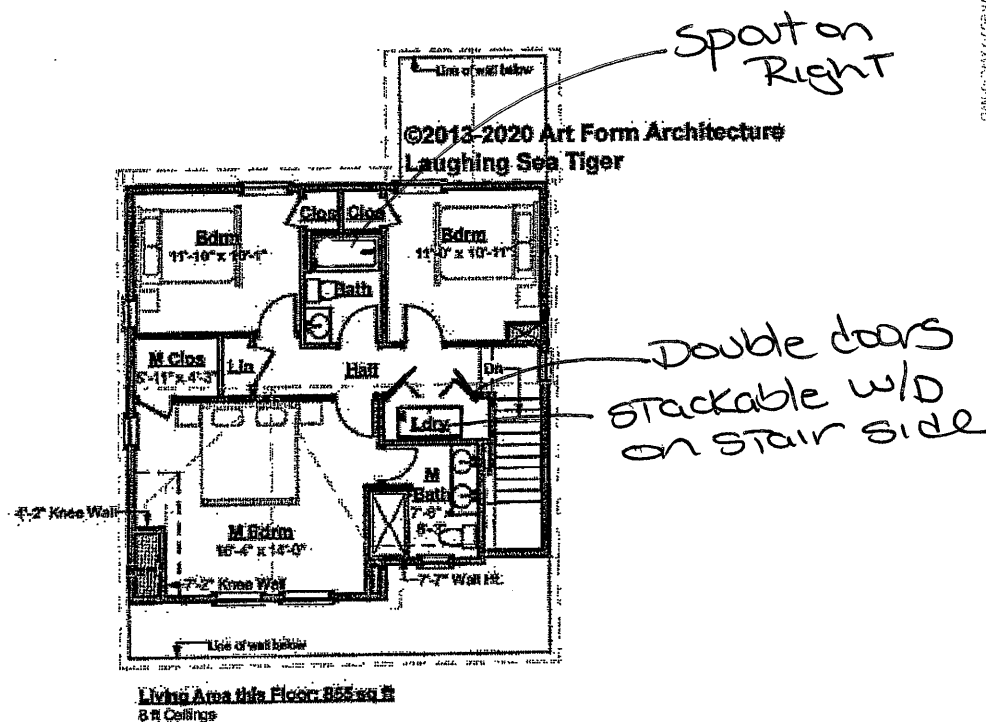

Use of this document is governed by our Terms and Conditions, found on our website:
<http://www.artformhomeplans.com/TermsConditions.a5w>

© 2013 Art Form Architecture, Inc. ALL RIGHTS RESERVED.
You may not build this Design without purchasing a License to Build (as defined in our Terms). Unauthorized changes are not permitted and violate copyright laws, which provide substantial penalties for infringement.

Some features show are optional. Your Purchase & Sale Agreement governs, whether items are labeled "optional" in this document or not.

We are not responsible for typographical errors.

[Handwritten signature]



623.120.v5 ER Laughing Sea Tiger




First Floor

	Area	Beds	Baths
Main	924 SF	0	0.5
Future	0 SF	0	0
Apt	0 SF	0	0
Total	924 SF	0	0.5
Ceiling Height			
Shown	8'-0"		
Possible*	8'-0"		

* See Major Change Information on plan page for cost

add
Fireplace

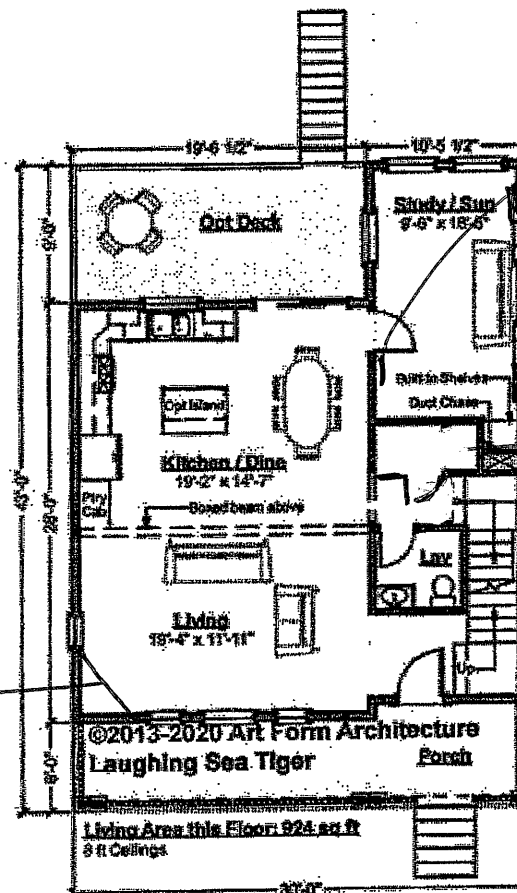

Pocket Door
move windows -
make same size as
the one on left elevation

change closet
Remove Basement
Door

Use of this document is governed by our **Terms and Conditions**, found on our website:
<http://www.artformhomeplans.com/TermsConditions.a5w>

© 2013 Art Form Architecture, Inc. ALL RIGHTS RESERVED.
You may not build this Design without purchasing a License to Build (as defined in our Terms). Unauthorized changes are not permitted and violate copyright laws, which provide substantial penalties for infringement.

Some features show are optional. Your Purchase & Sale Agreement governs, whether items are labeled "optional" in this document or not.

We are not responsible for typographical errors.

