

Ceiling Windows  
Corridors

Large Windows

Artform Home Plans

603-431-9559


**Bonnie Ranch**  
© 2014-2019 Artform Architecture, Inc. All rights reserved.  
G79.124.v29 ~~OK~~ You may not build this design without purchasing a license. You may not have geographic restrictions.

G-L

Garage Left  
4 Season Room  
instead of  
Screen Porch  
Patio instead of  
Deck if grade  
allows

TRANSOM TO  
MIRROR FRONT  
TO SUN ROOM  
DBL CLOSS. BORN DOORS

**First Floor Plan**  
Scale: 3/32" = 1'-0"

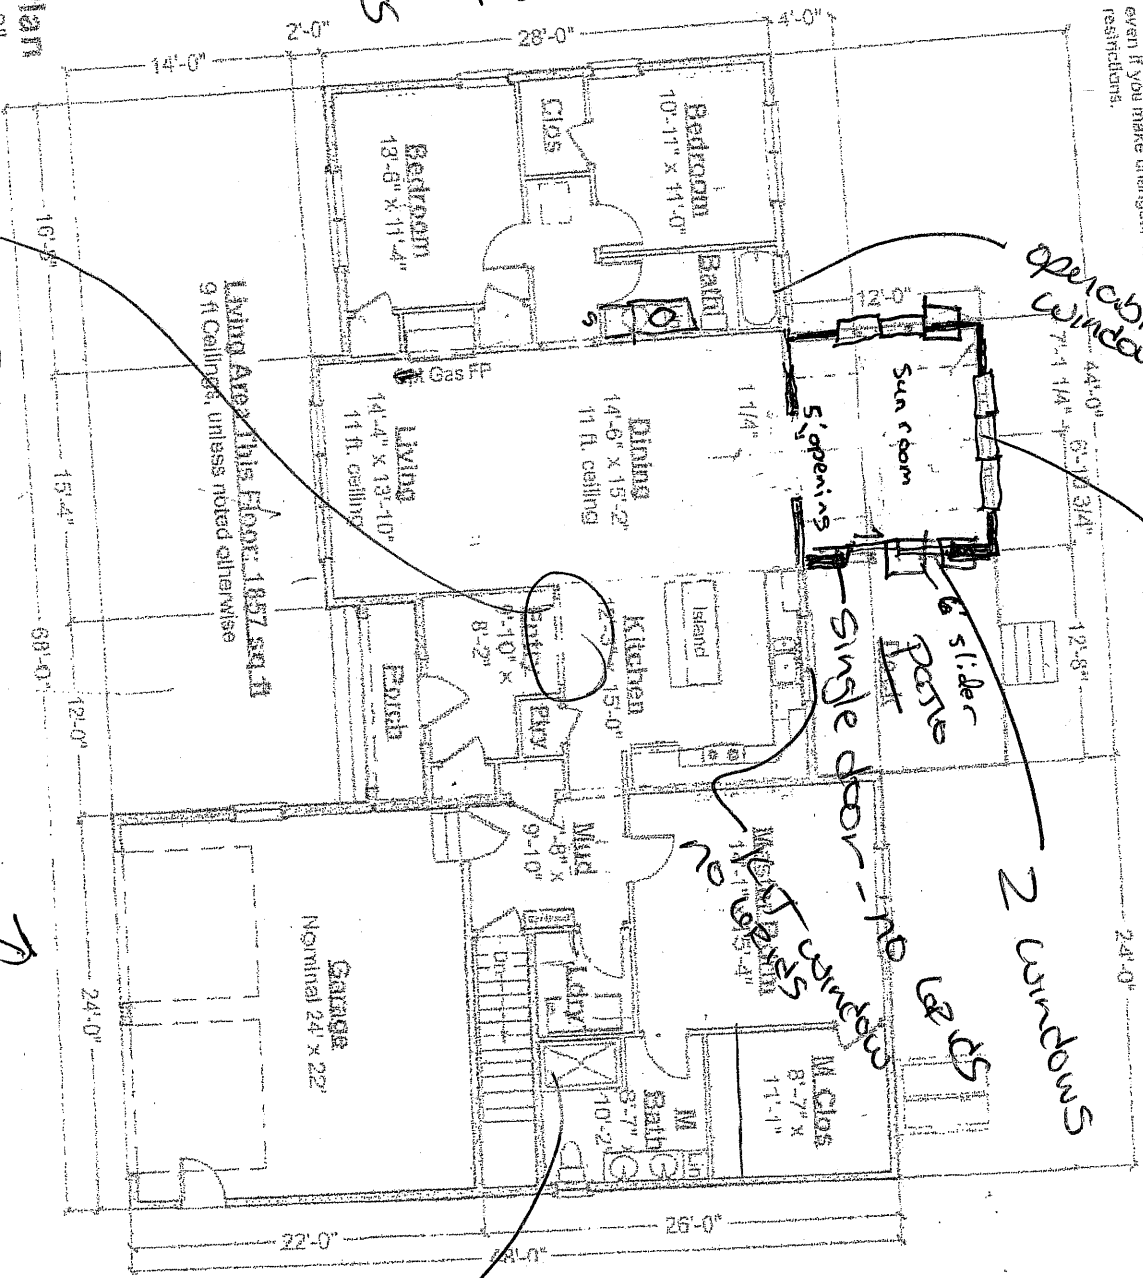

operable window  
44'-0" x 7'-1 1/4"  
6'-10 3/4"

5' opening  
6' slider  
Patio  
Single door - no window

2 windows

transoms

Living Area: This Floor: 1827 sq. ft.  
9 ft ceiling, unless noted otherwise

Fire plan

W/L 19

4' x 6' walk in shower w/ bench no curb

TB  
12/26/20  
12:27 PM EST  
dotloop verified

MB  
12/26/20  
12:10 PM EST  
dotloop verified