

Flip Plan

2x2
Awning

Raspberry Crisp

565.144.v53 GL

© 2013-2020 Art Form Architecture, Inc.,
all rights reserved. You may not build this
design without purchasing a license, even
if you make changes. This design may
have geographic restrictions.

 **Artform Home Plans**

603-431-9559



Some items shown are optional and/
or may vary. Builder's written
specifications always govern.

1. Gas fireplace and it's surround or mantel
2. Kitchen - island, cabinet style & trim, countertop material, etc.
3. Door styles and trim
4. Window grilles and trim, window treatments
5. Stair balusters or low walls at stairs
6. Lighting
7. Material selections (flooring, siding, roofing, paint colors, etc.)
8. Other furnishings
9. Landscaping, paving and walkways
10. Gutters, shutters and other exterior trim components
11. Deck size, railing style, stair location, etc.
12. Amount of exposed basement and/or wood framed walls at basement.

These images are not of any specific building site. Sun and view through windows will vary, as will the site around the house on the exterior and the slope of the land.

SHAKES ON FRONT






565.144.v53 GL
Raspberry Crisp

© 2013-2020 Art Form Architecture, Inc.,
 all rights reserved . You may not build this
 design without purchasing a license, even
 if you make changes. This design may
 have geographic restrictions.

Artform Home Plans

603-431-9559

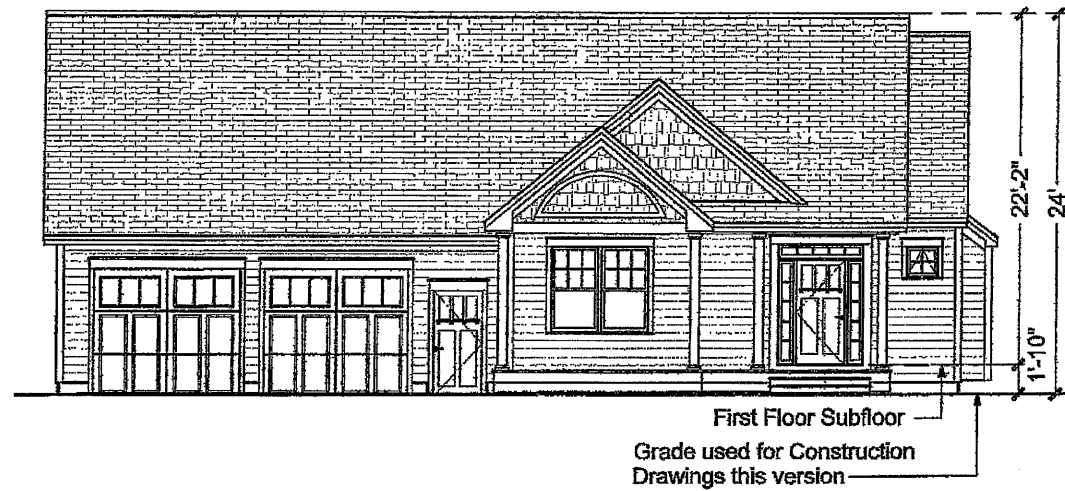

78 D-1
 ML

Front Elevation

Scale: 3/32" = 1'-0"

25

© 2013-2020 Art Form Architecture, Inc.,
all rights reserved . You may not build this
design without purchasing a license, even
if you make changes. This design may
have geographic restrictions.

Black Windows - PRICE

PUT ATTIC
ACCESS in Laundry


Scale: $3/32" = 1'-0"$

REMOVED
/ RANSOM

RECESS ENTRY 2



603-431-9559

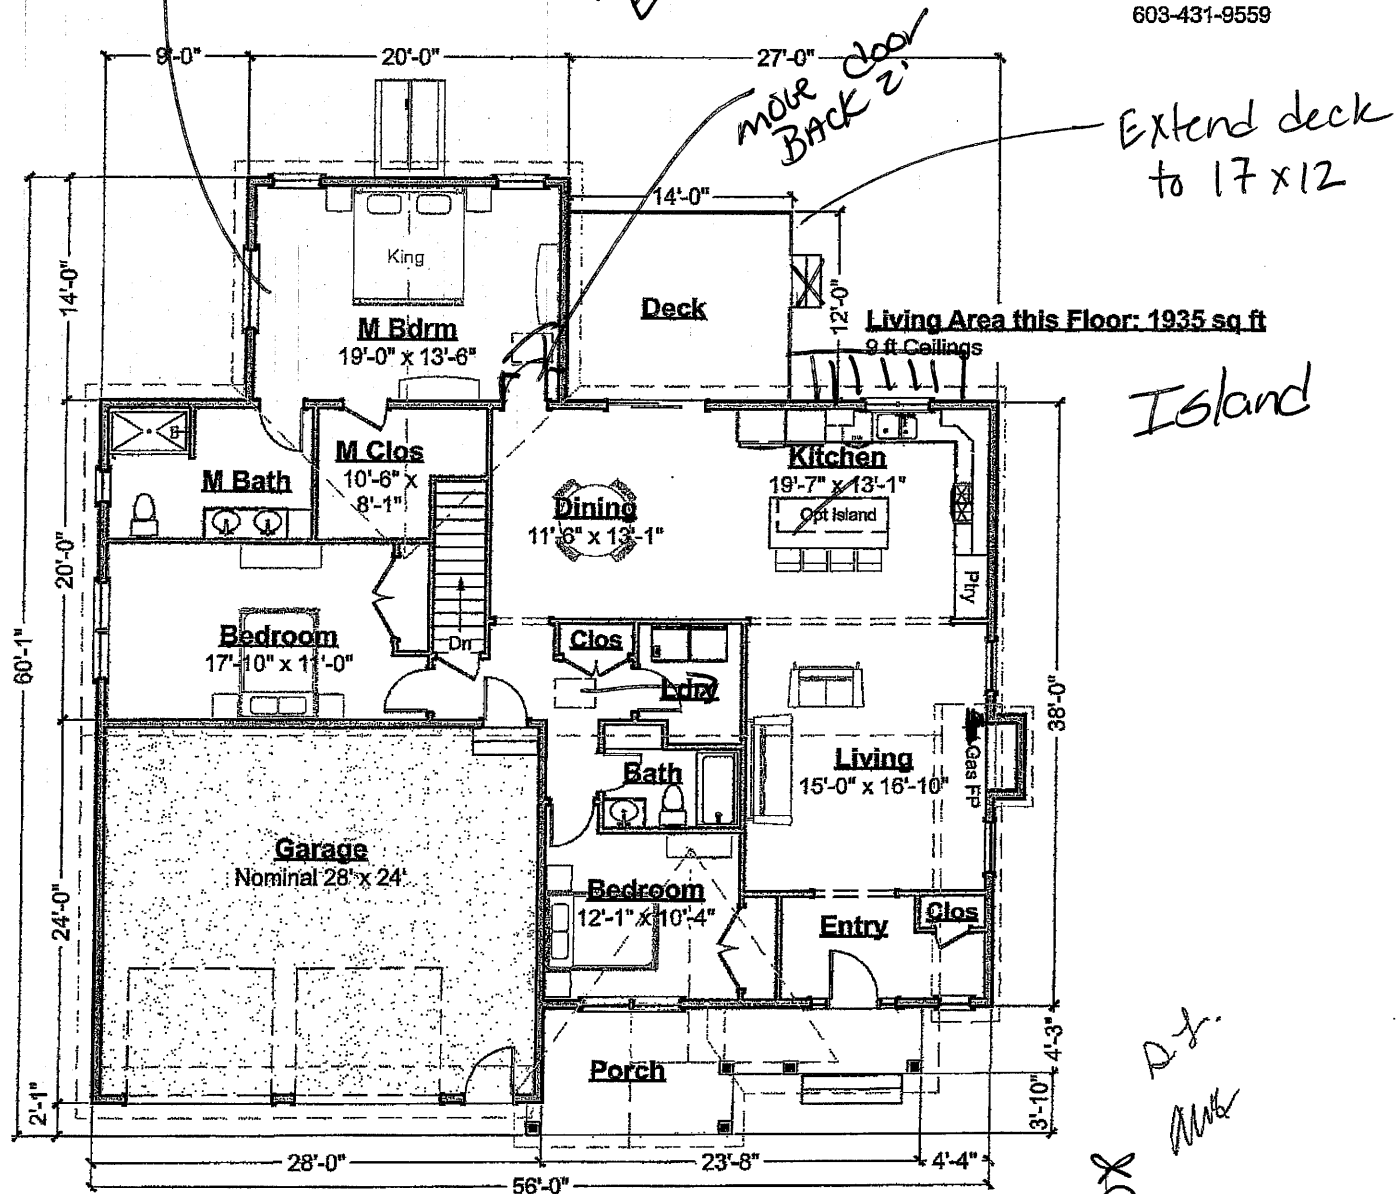

Island

D. J.
 M. K.
 E.

5/7/2021


Raspberry Crisp

565.144.v53 GL

© 2013-2020 Art Form Architecture, Inc.,
all rights reserved. You may not build this
design without purchasing a license, even
if you make changes. This design may
have geographic restrictions.

 **Artform Home Plans**

603-431-9559

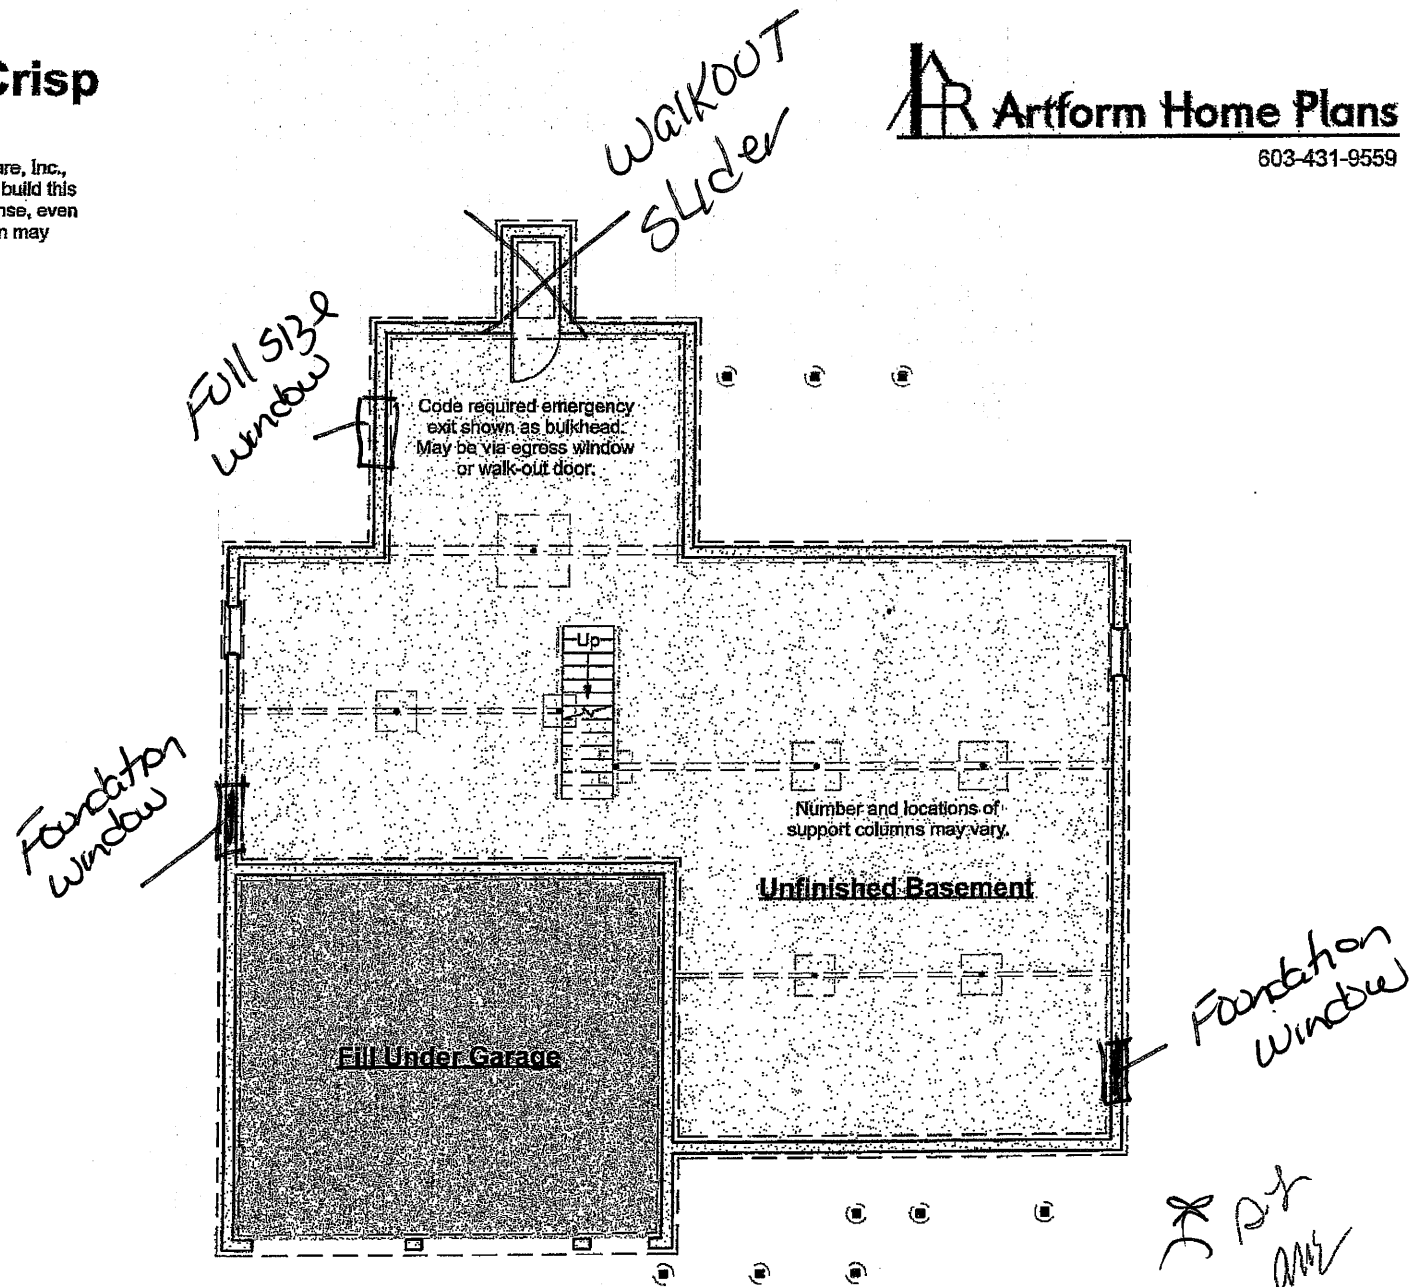

Foundation Plan

Scale: 3/32" = 1'-0"