

Boysenberry Biscotti

702.144.v9 GR

(5/7/2019)


© 2014-2019 Art Form Architecture, Inc., all rights reserved.
You may not build this design without purchasing a license,
even if you make changes. This design may have geographic
restrictions.

Artform Home Plans

603-431-9559

Living Area this Floor: 1614 sq ft

9 ft Ceilings, unless noted otherwise

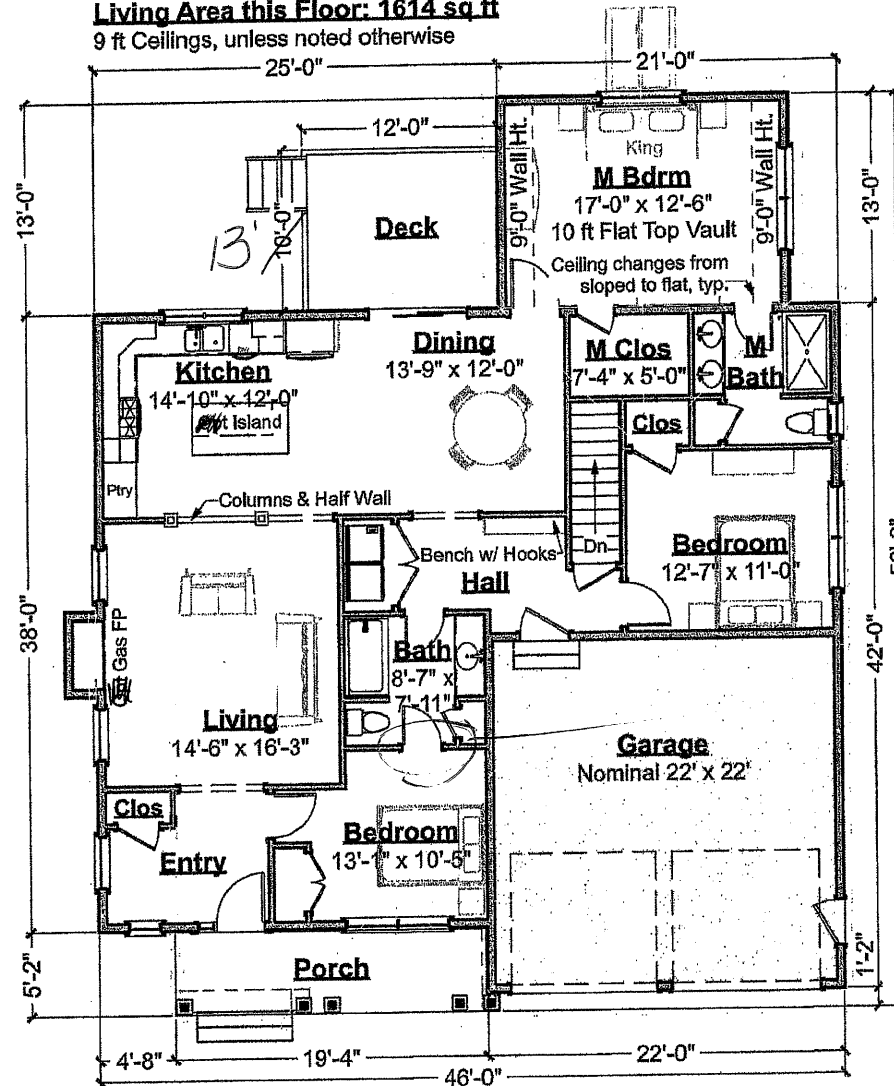

Garage
on
Left

4/0 window
CERIDS

Pocket
door

First Floor Plan

Scale: 3/32" = 1'-0"

JH AC XL