

12/7/2020

Sir Zach

845.124.v8 GR (12/7/2020)

© 2016-2020 Art Form Architecture, Inc., all rights reserved. You may not build this design without purchasing a license, even if you make changes. This design may have geographic restrictions.




Artform Home Plans

603-431-9559

Some items shown are optional and/or may vary. **Builder's written specifications always govern.**

1. Gas fireplace and it's surround or mantel
2. Kitchen - Island, cabinet style & trim, countertop material, etc.
3. Door styles and trim
4. Window grilles and trim, window treatments
5. Stair balusters or low walls at stairs
6. Lighting
7. Material selections (flooring, siding, roofing, paint colors, etc.)
8. Other furnishings
9. Landscaping, paving and walkways
10. Gutters, shutters and other exterior trim components
11. Deck size, railing style, stair location, etc.
12. Amount of exposed basement and/or wood framed walls at basement.

These images are not of any specific building site. Sun and view through windows will vary, as will the site around the house on the exterior and the slope of the land.

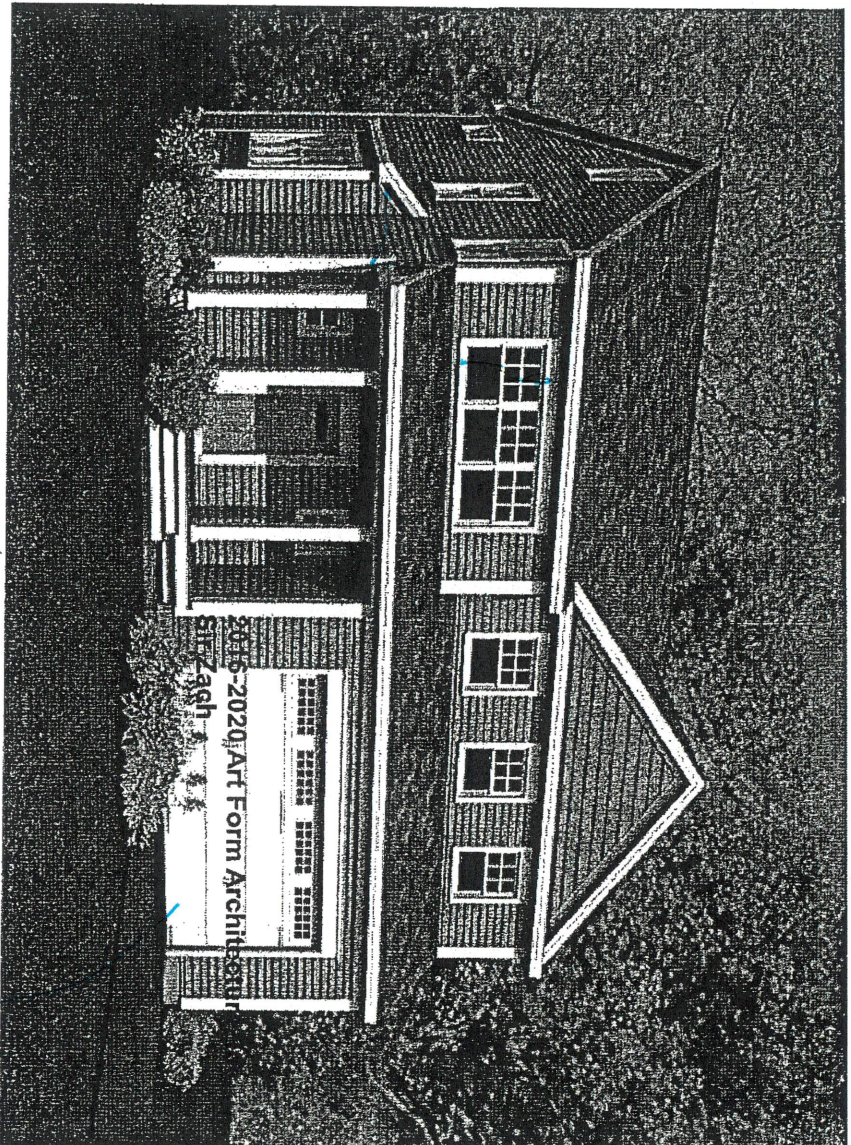

Flip Plan

Window grds - 2/2

Slider - no grds

Keep window

CRS 845.124.v8 GR Sir Zach

mb/ld

12/7/2020


Sir Zach

845.124.v8 GR (12/7/2020)

@ 2016-2020 Art Form Architecture, Inc., all rights reserved. You may not build this design without purchasing a license, even if you make changes. This design may have geographic restrictions.

 Artform Home Plans

603-431-9559

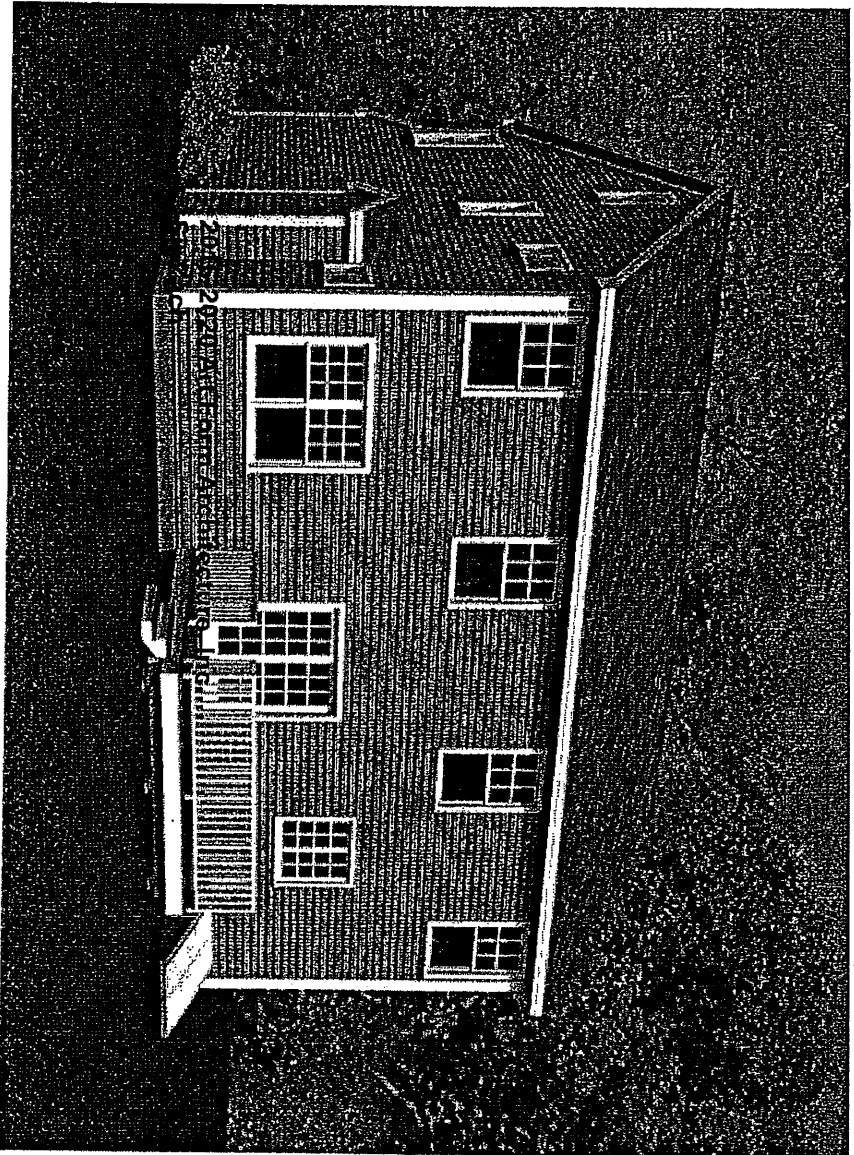

CRS 845.124.v8 GR Sir Zach

MD / LD 2

Sir Zach

845.124.v8 GR (12/7/2020)


© 2016-2020 Art Form Architecture, Inc., all rights reserved. You may not build this design without purchasing a license, even if you make changes. This design may have geographic restrictions.

Artform Home Plans

603-431-9559

First Floor Plan

Scale: 1/8" = 1'-0"

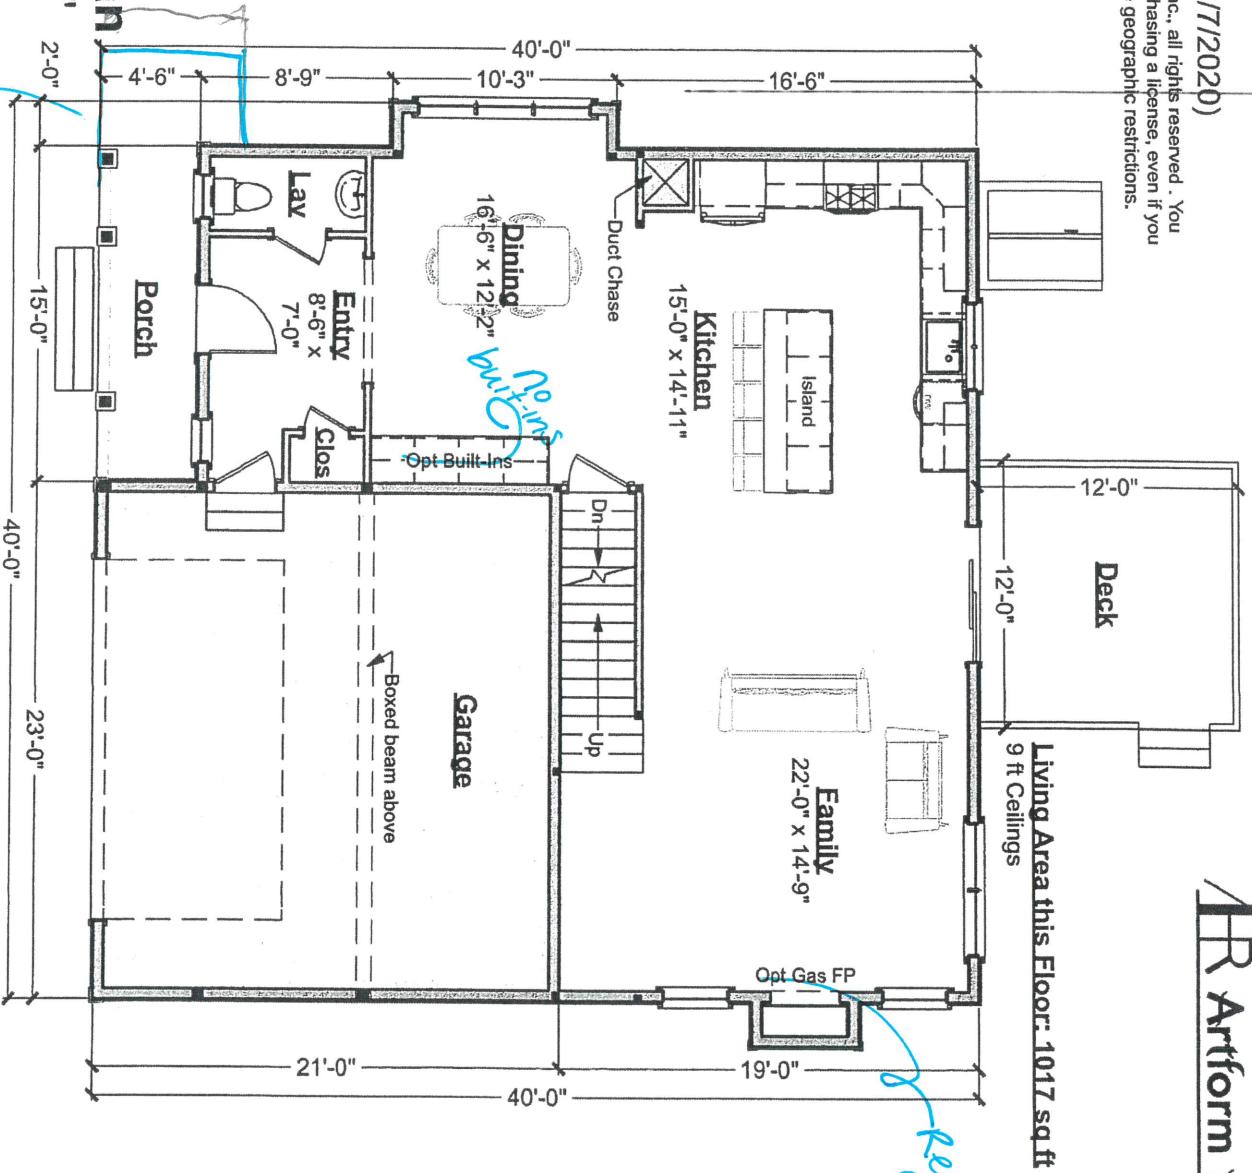

remove optional

Extend porch to 20 x 4.5 w/ 2' wrap around

MD / LD

12/7/2020

Sir Zach

845.124.v8 GR (12/7/2020)


@ 2016-2020 Art Form Architecture, Inc., all rights reserved. You may not build this design without purchasing a license, even if you make changes. This design may have geographic restrictions.

Artform Home Plans

603-431-9559

Second Floor Plan

Scale: 1/8" = 1'-0"

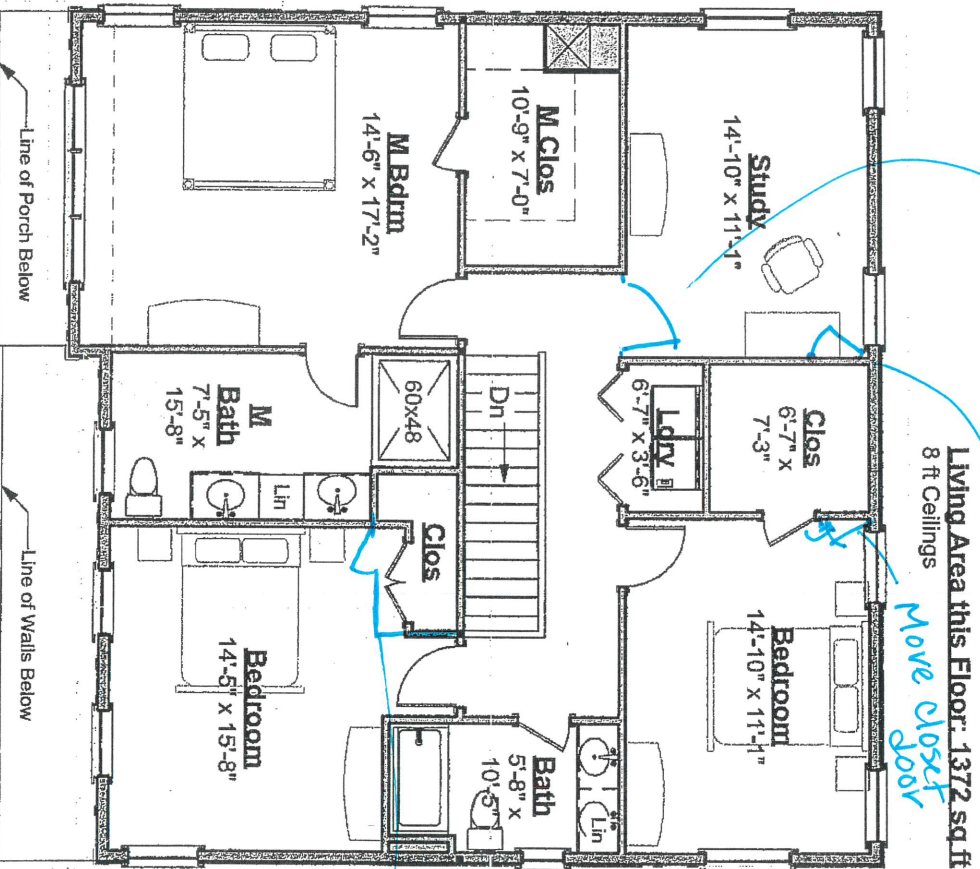

pg 1/20


Sir Zach

845.124.v8 GR (12/7/2020)

© 2016-2020 Art Form Architecture, Inc., all rights reserved. You may not build this design without purchasing a license, even if you make changes. This design may have geographic restrictions.




603-431-9559

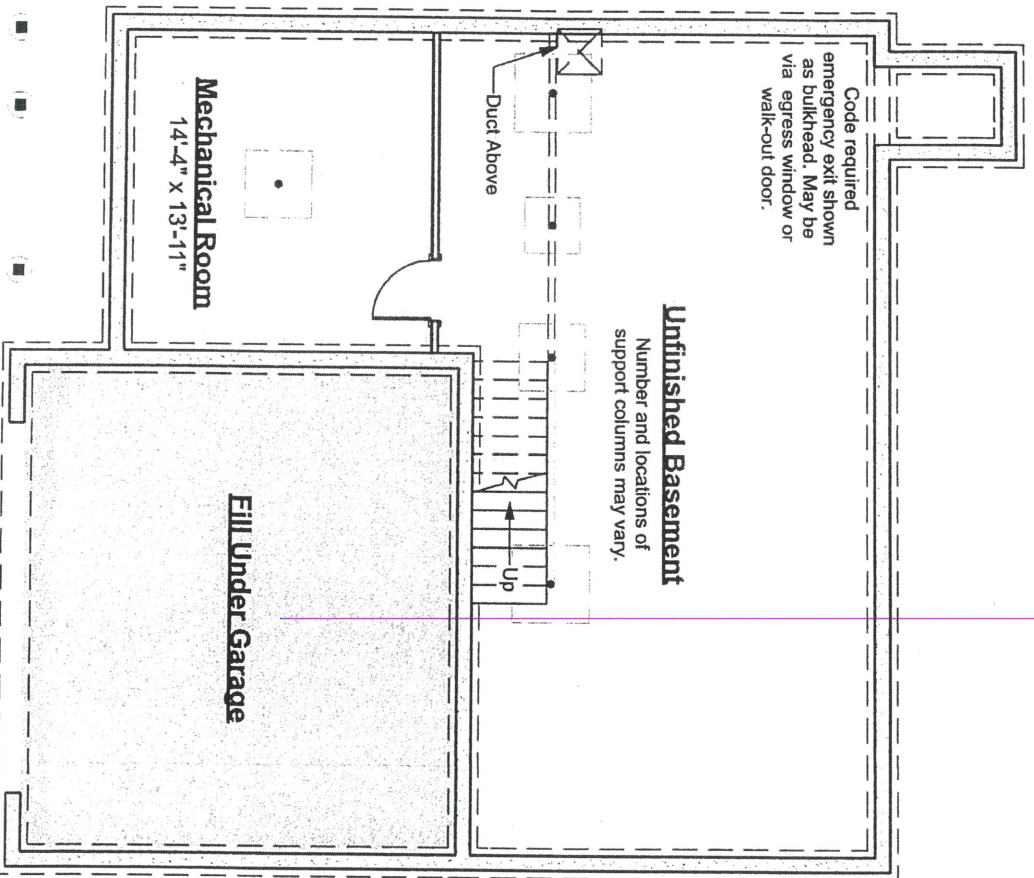

Handwritten notes: '2' and '10/10'.

Foundation Plan
Scale: 1/8" = 1'-0"

Change to this door pattern

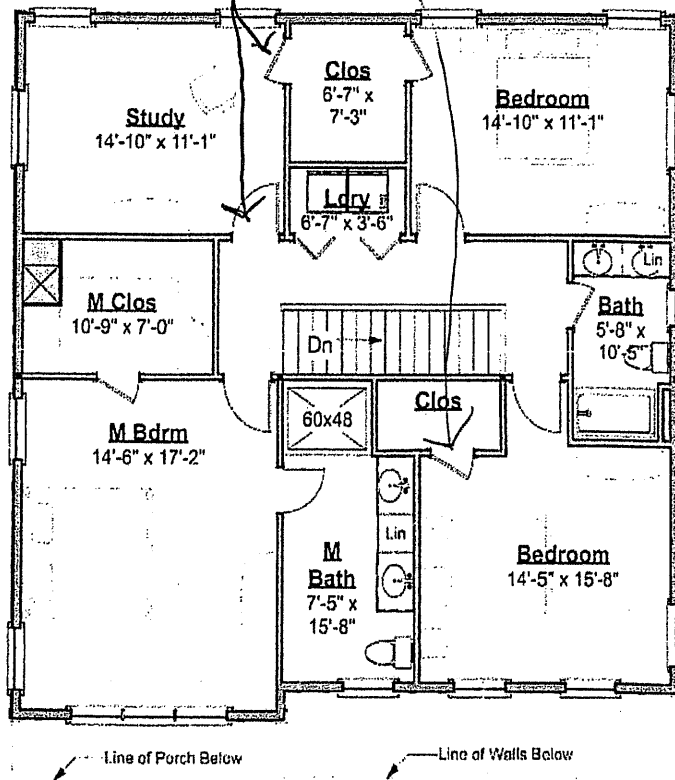

XC MP/LD