

574.124.v6 GL Mayberry Shortcake




First Floor

	Area	Beds	Baths
Main	1130 SF	1	1.5
Future	0 SF	0	0
Apt	0 SF	0	0
Total	1130 SF	1	1.5
Ceiling Height			
Shown 9'-0"			
Possible* 8'-0"			

* See Major Change Information on plan page for cost

Window grids-Full grids
Slider grids-Grids

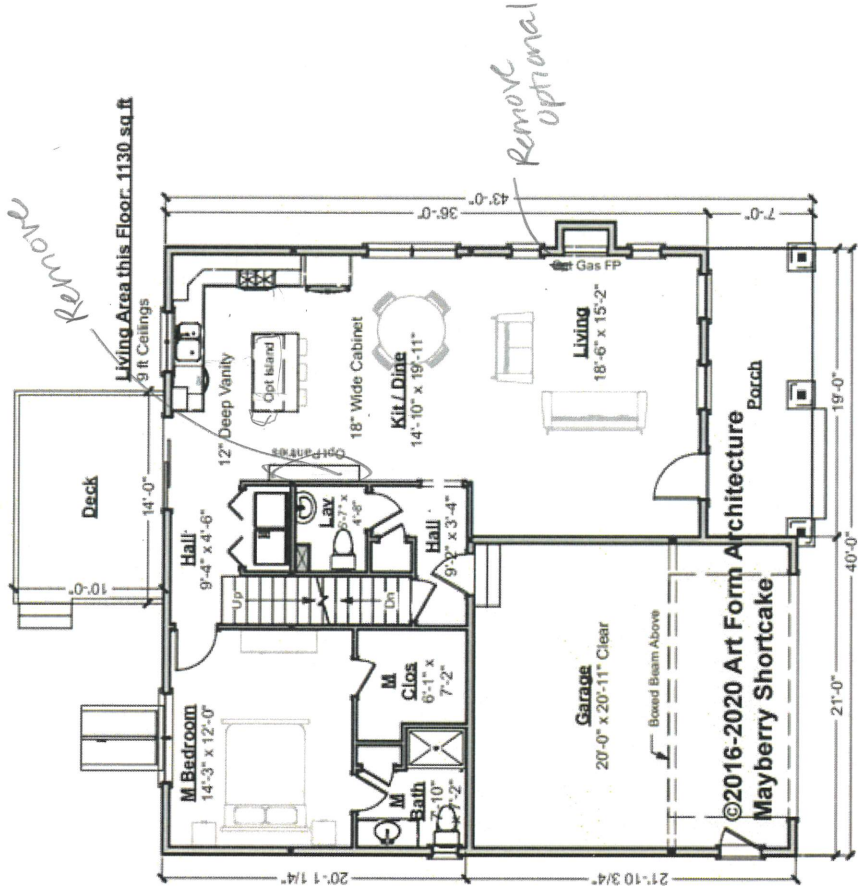

Use of this document is governed by our Terms and Conditions, found on our website: <http://www.artformhomeplans.com/TermsConditions.a5w>

© 2016 Art Form Architecture, Inc. ALL RIGHTS RESERVED. You may not build this Design without purchasing a License to Build (as defined in our Terms). Unauthorized changes are not permitted and violate copyright laws, which provide substantial penalties for infringement.

Some features show are optional. Your Purchase & Sale Agreement governs, whether items are labeled "optional" in this document or not.

We are not responsible for typographical errors.