


959.124.v5 ER

Orkney

959.124.v5 ER
(11/14/2019)

Area this Floor: 1064 sq ft
ing Ht., unless noted otherwise

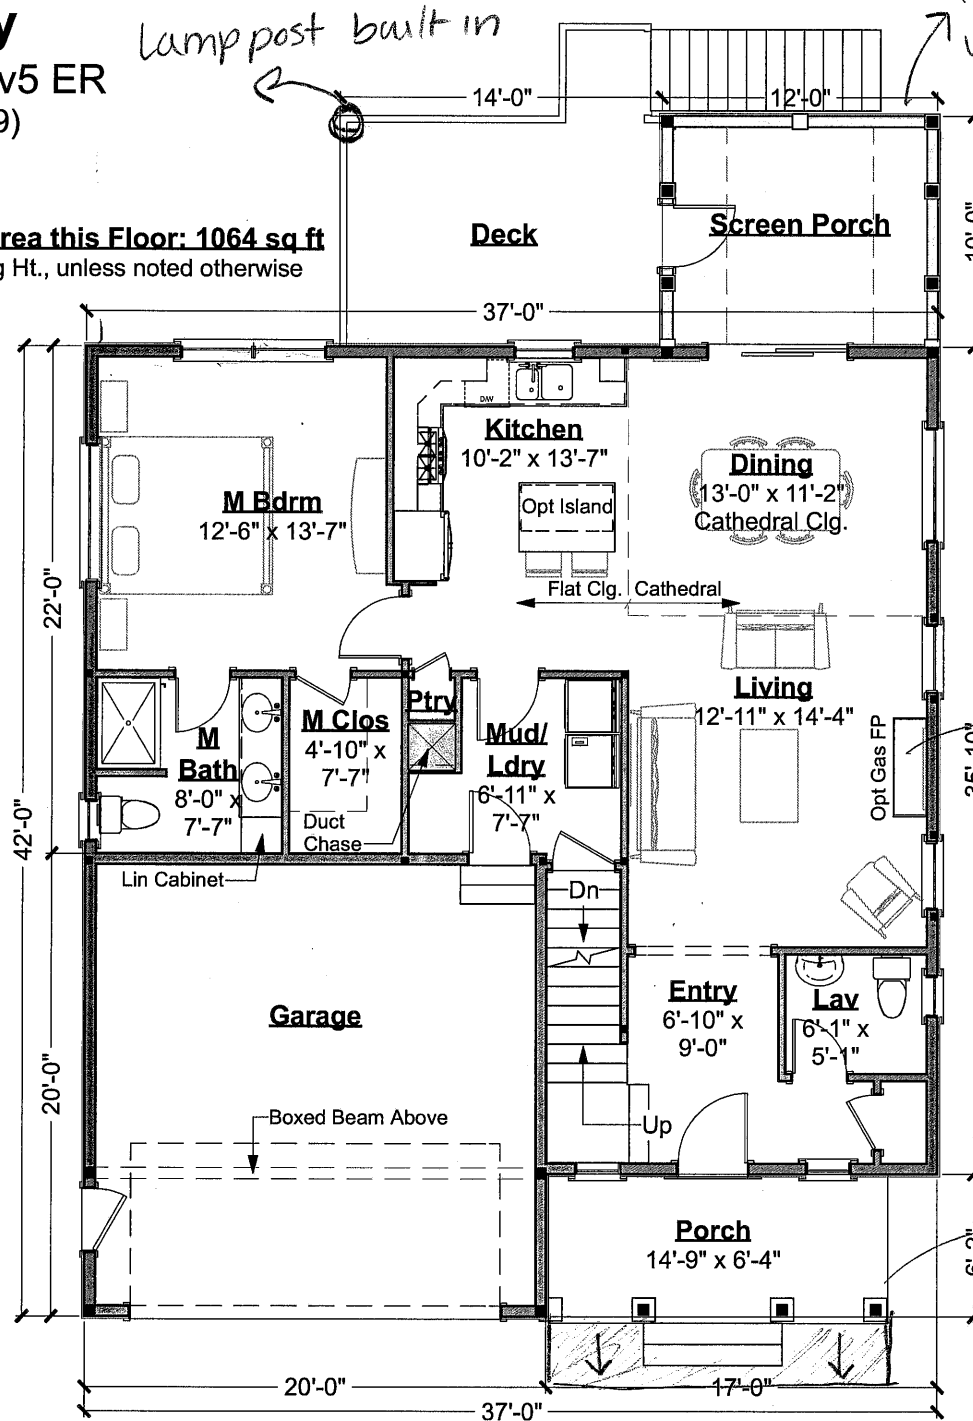

Foundation
under screen
porch?

Artform Home Plans

603-431-9559
© 2018-2019 Art Form Architecture, Inc., all rights reserved.
You may not build this design without purchasing a license,
even if you make changes. This design may have
geographic restrictions.

1. Window grids - Full grids
2. Slider - No grids

Don't frame to ceiling

Possible to
extend front porch
4' in depth?

First Floor Plan
Scale: 1/8" = 1'-0"

11/14/2019

Orkney


959.124.v5 ER
(11/14/2019)



603-431-9559

© 2018-2019 Art Form Architecture, Inc., all rights reserved.
You may not build this design without purchasing a license,
even if you make changes. This design may have
geographic restrictions.

Living Area this Floor: 798 sq ft
8 ft Ceiling Ht

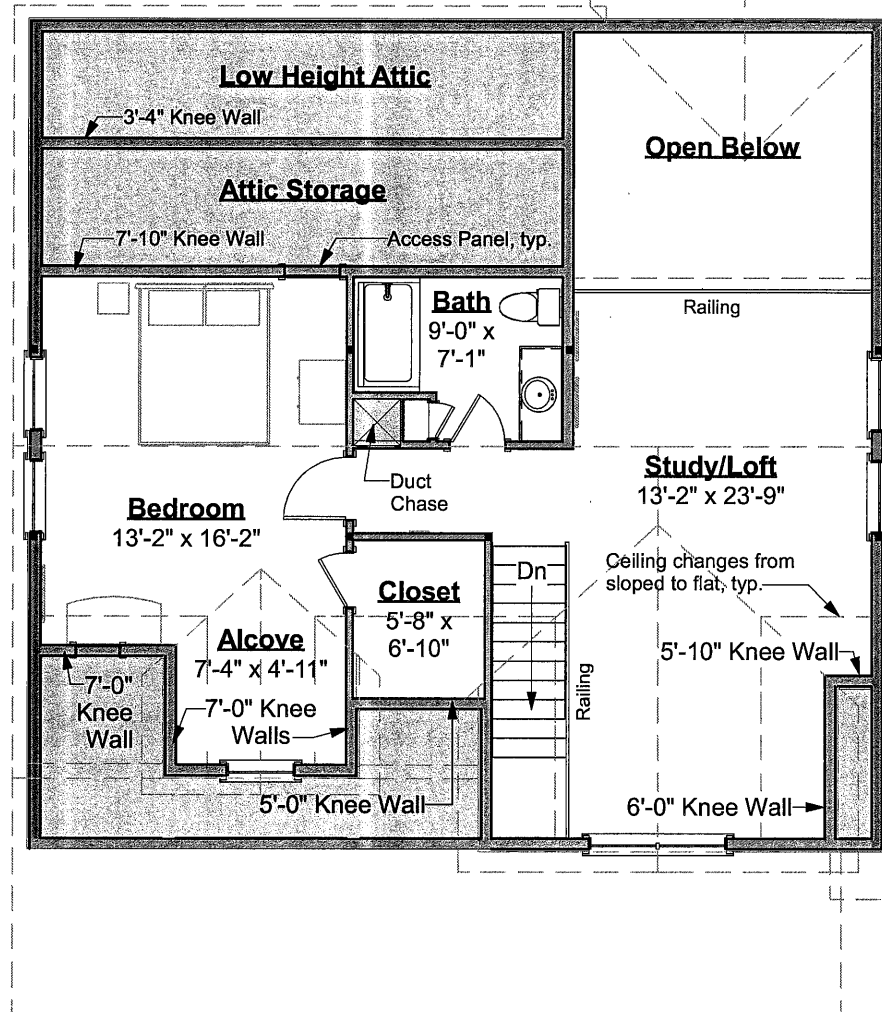

Second Floor Plan

Scale: 1/8" = 1'-0"