

540.126.v10 EL Balmalcolm


First Floor

	Area	Beds	Baths
Main	1514 SF	1	1.5
Future	0 SF	0	0
Apt	0 SF	0	0
Total	1514 SF	1	1.5
Ceiling Height			
Shown	9'-0"		
Possible*	8'-0"		

* See Major Change information on plan page for cost


Window grids: Full grids
Slider: None

KE

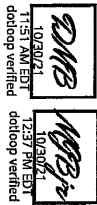

Higher Windows
Vaulted ceiling

6' French
Pocket Doors
w/transom

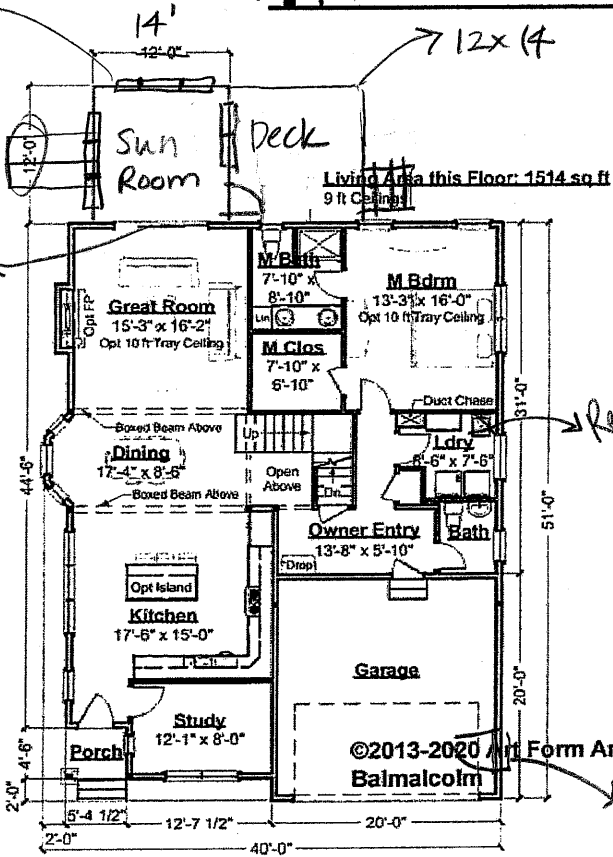

Remove sink
+ folding

Add Garage
People door

©2013-2020 Art Form Architecture
Balmalcolm

Use of this document is governed by our Terms and Conditions, found on our website:
<http://www.artformhomeplans.com/TermsConditions.a5w>

© 2013 Art Form Architecture, Inc. ALL RIGHTS RESERVED.
You may not build this Design without purchasing a License to Build (as defined in our Terms). Unauthorized changes are not permitted and violate copyright laws, which provide substantial penalties for infringement.

Some features show are optional. Your Purchase & Sale Agreement governs, whether items are labeled "optional" in this document or not.

We are not responsible for typographical errors.